


"TREWYN

Class 100 A.1. 3 deck rule with freeboard.

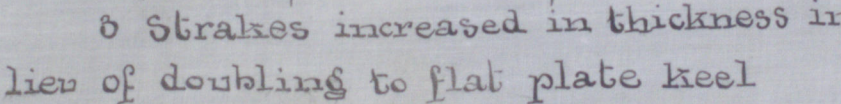

STEEL & NO. 207 —
MIDSHIP SECTION


Class 100 A.I. 3 deck rule with freeporg.

II


40 1/2


5115

Dimensions of Per. Kyrle

Bridge Deck. —

Dehner

57

4/5/7
B
C

Lloyd's Register
Foundation

W739-10043