

6.6-13

Howaldtswerke  
Kiel

# Deckplans of S.S. 583

S.S. No. 583

$B = 61.855'$   
 $C-2' = 30.73'$   
 $B \cdot C = 434.96$


$B = 18.48$   
 $C-2' = 21.67$   
 $B \cdot C = 401.27m^2$

$R: B = 7.0$   
 $R: C = 12.95$   
 $d = 23' 10\frac{1}{2}"$

Length between S.S.  $470'-0" = 143.25m$   
Breadth moulded  $61'-10" = 18.848m$   
Depth mid. to Upper Deck  $28'-\frac{1}{2}" = 8.557m$   
Depth of Shelter Deck  $10'-0" = 3.048m$

Class \* 100A1 Brit. Lloyd  
Tonnage: 5000


NOTE: SIZES OF DECK BEAMS, OF PILLARS & HEAD GIRDELS  
SEE ALSO APPROVED PLAN FROM 27.8.13

 



Lloyd's Register  
Foundation



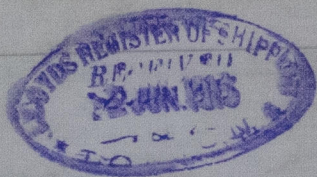

*Deck plans. General & etc.*

*S. S. No 583*

*Hamburg letter*

*31. 5. 13*

**HAMBURG** Report No 14138

*"Inostburg"*



© 2020

Lloyd's Register  
Foundation

W739-0148