
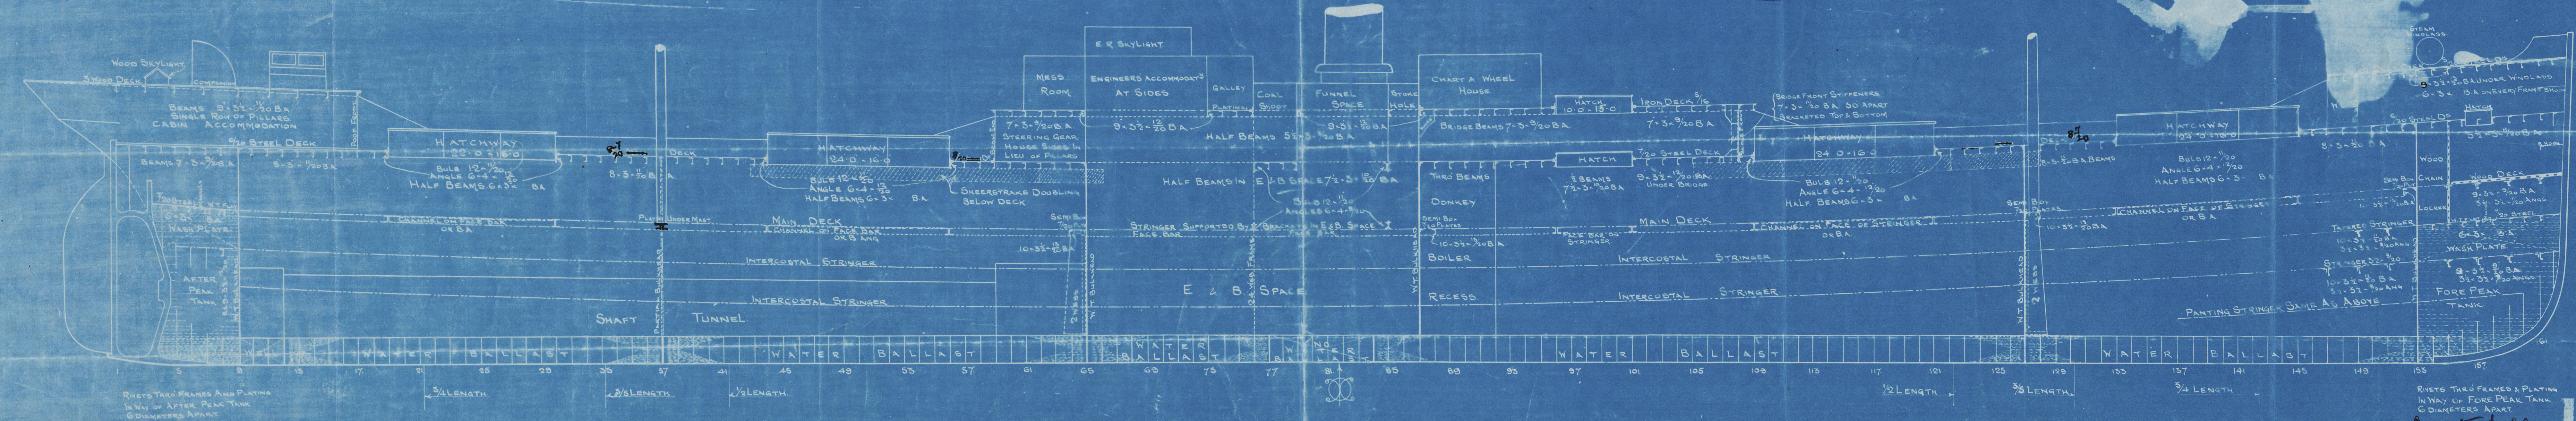


151. PROFILE.

S.S. 325-0 x 47-0 x 24-0 (TO SPAR DECK)

SCALE 1/8" = ONE FOOT

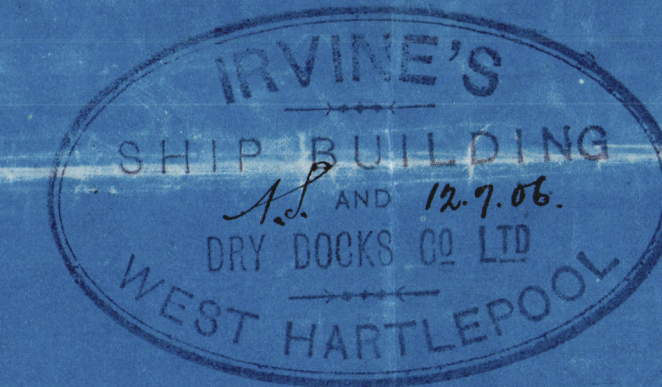


S.S. 1434. 151.

Corrected Profile
S.S. 1434. 151.
Lloyd's Register
Foundation
W743-0040

RETAIN

James S. B. & S. & Co.
no 151 only
Profile

88 'Snowdon Range'
Hpl Rpt no 13025

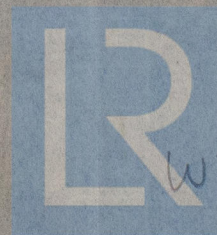

© 2020

Lloyd's Register
Foundation