

N<sup>o</sup> 1

Equipment number 3502-  
Anchors & chains to be tested as required by Rules


Section indicating sizes of scantlings

1  
2 Breadth 90  
Depth 10 5/8  
1 1/2 17 5/8  
1 1/2 36 8/16  
1 1/2 89 06  
1 1/2 22 83  
1 1/2 4 94 5 8 59  
4 3 03

2 lower anchors 5 Cwt. ex stock  
1 Stream " 1 1/2 " " "  
1 Hedge " 3/4 " " "  
135 fms 13/16 stud chain cable  
45 fms 8/16 stream chain  
75 fms 5/8 wireline  
90 fms 3 wire  
Bulwarks 4/20

Deck plating in way of 6 Scale 1/2 = one foot  
8 - 5/8 rivets in seams between beams  
rivets through beams and plating 6 diameters apart  
rivets 5/8"

Seams of plating double riveted in way of oil compartments

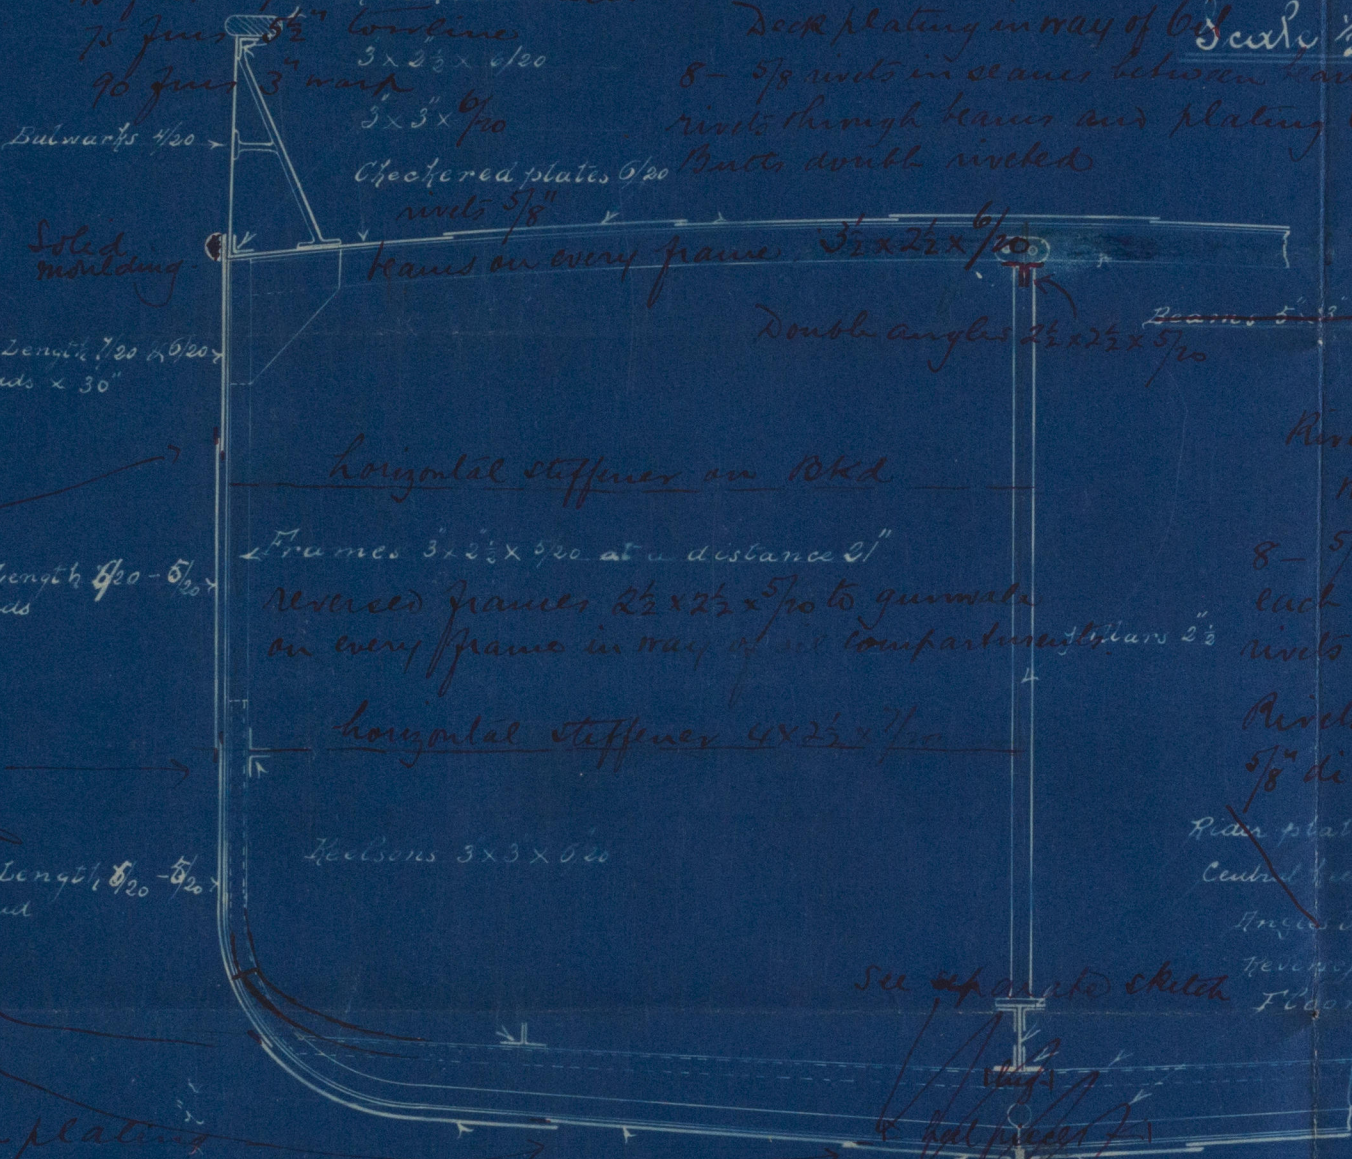


Riveting of outside plating in way of oil compartments  
8 - 5/8 rivets between frames in each row in seams and two rivets through frame at landings  
Rivets through frames & plating 5/8 dia. spaced 6 diam. apart.


Plating plates 6 1/2 x 7/20  
Central keelson 3 2 x 7/20  
Angles bars 3 x 3 x 5/20  
Reversed frames 2 1/2 x 2 1/2 x 5/20  
Floors 11 1/2 x 5/20 - 6/20 under engine

See separate sketch

Butts of outside plating double riveted throughout

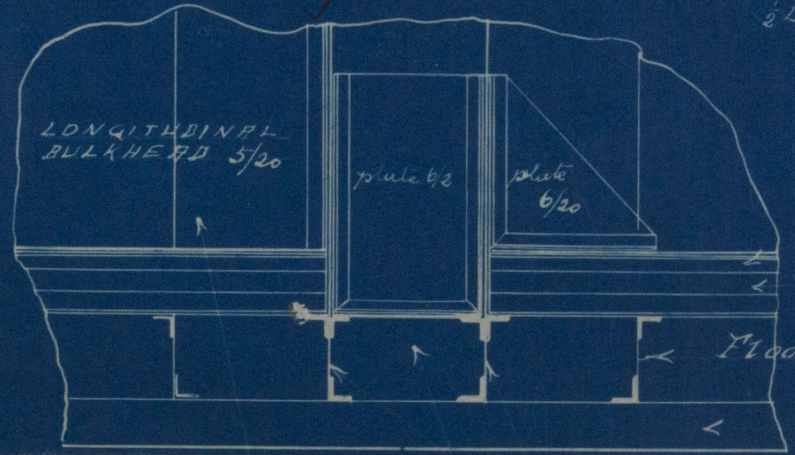


OIL SPACE WATER SPACE  

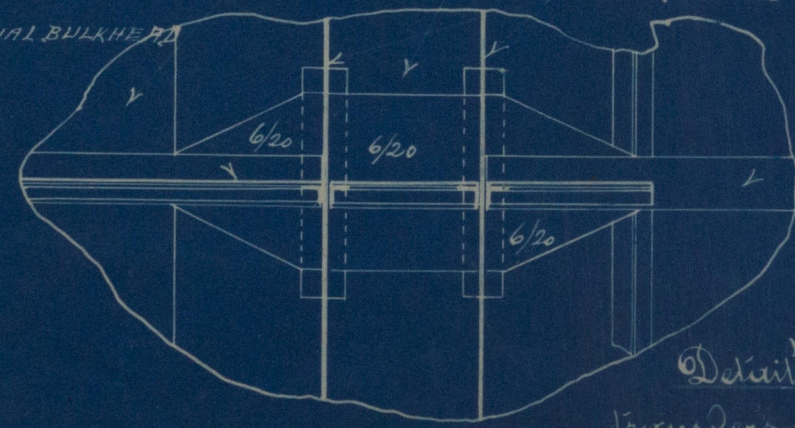

Detail of connection of centre keelson in the transverse bulkheads of water space, fore and aft.

Plan like submitted


Transverse Bulkheads in way of oil compartments  
Plating 9/20  
Vertical stiffeners 4 x 2 1/2 x 7/20 spaced 21" apart bracketed top and bottom  
Horizontal stiffeners 4 x 2 1/2 x 7/20 bracketed to side of keel and middle line bulkhead  
Middle line bulkhead 5/20, vertical stiffeners 4 x 2 1/2 x 7/20 bracketed top and bottom  
Frame bars to transverse bulkheads 4 x 4 x 7/20  
Single angles double riveted

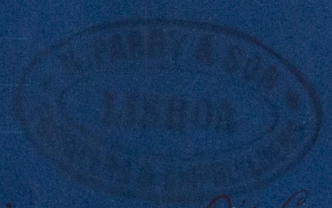

Lisbon 21-I-03

W 744-0064




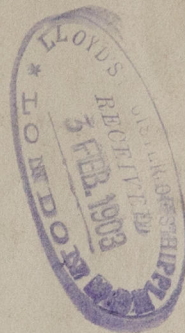

*H. Shipping Section*



*Moskato*  
*Lis #26*

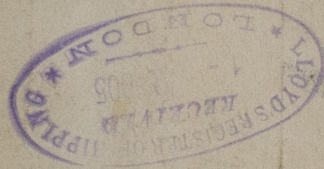

RETAIN



© 2020

Lloyd's Register  
Foundation

W744-0064