

N-5


Steel Sloop "Tres Maes"

SCHOONER "TRES MAES" PLAN ALTERATIONS ON DECK FOR FITTING THE  
COMPANION, KITCHEN, LAMPS & W.C.  
SCALE  $\frac{1}{4}" = 1'-0"$

WHERE THE RUST JOINT  
HAS BEEN APPLIED  
SCALE  $\frac{1}{4}" = 1'-0"$

LONGITUDINAL BULKHEAD


SECTION THROUGH A-B

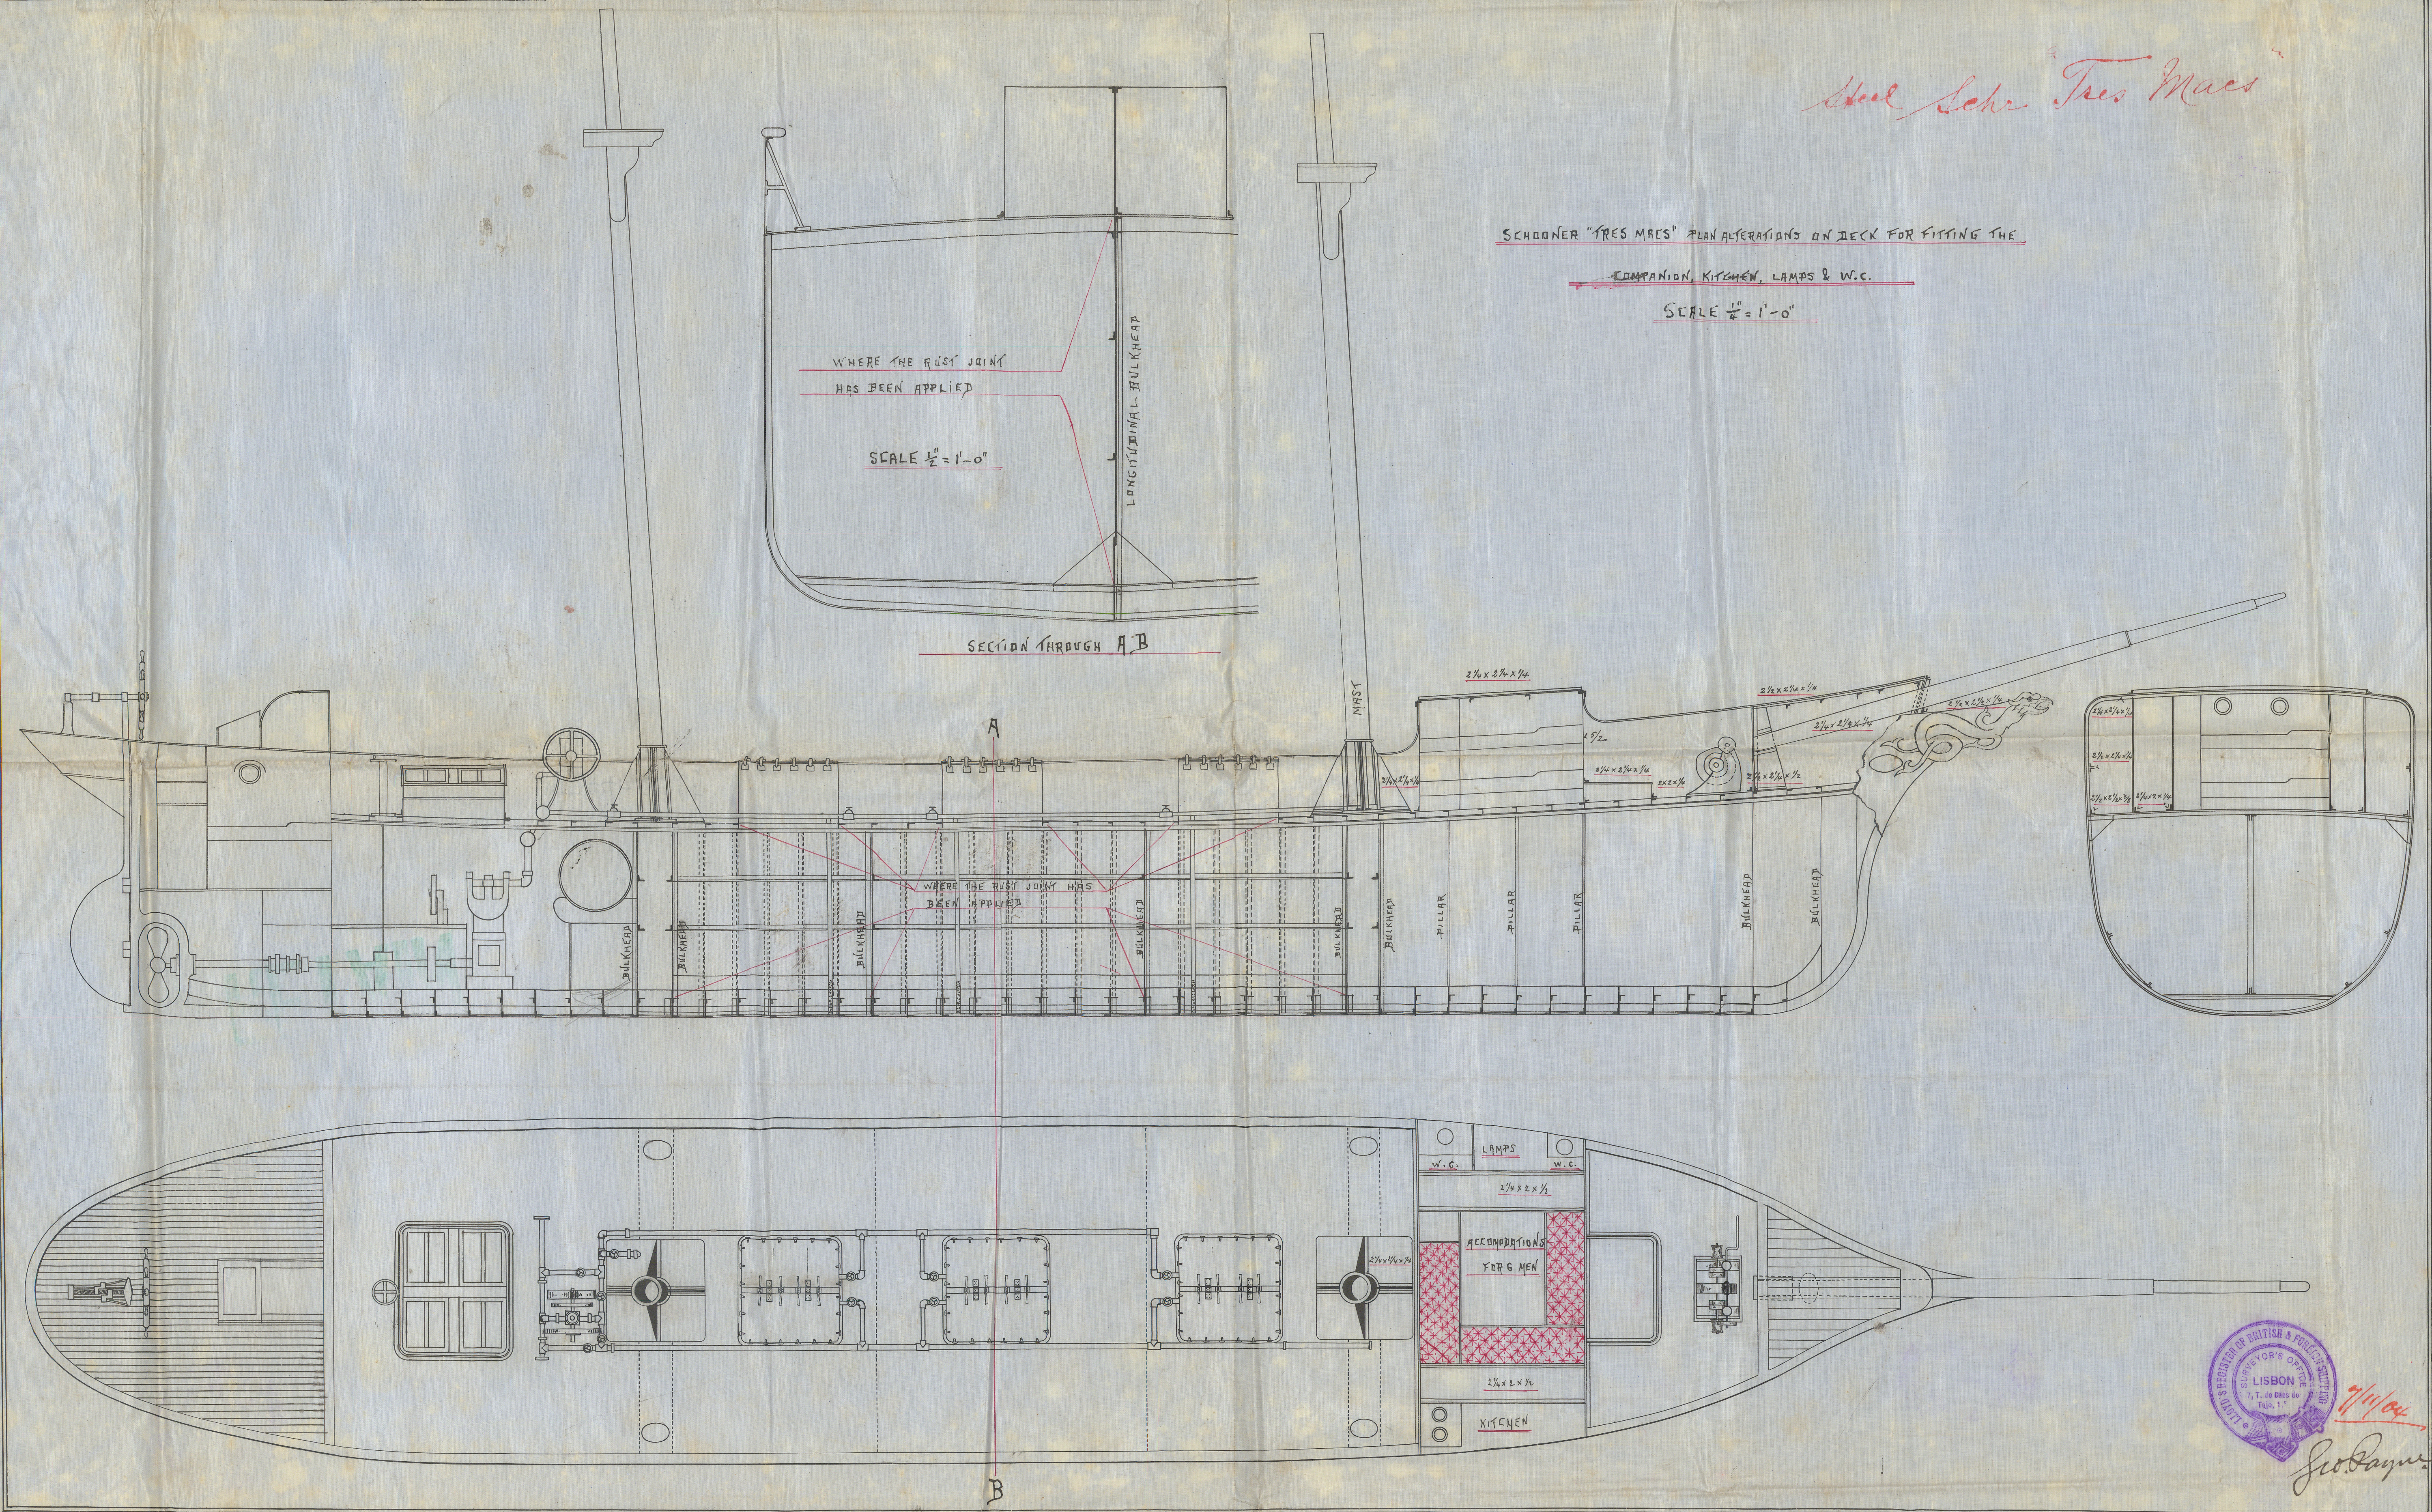

Geo. Payne



FILE 1A11W

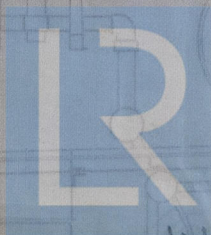

© 2020

Lloyd's Register  
Foundation

W744-0065