

7.12.05


"B"

Alternative Profile in Way of E & B Spaces

N<sup>o</sup> 309 S.S.

To class 100 A.1. Lloyds Spar D<sup>h</sup> Rule.

Scale 1/8" = 1' 0"

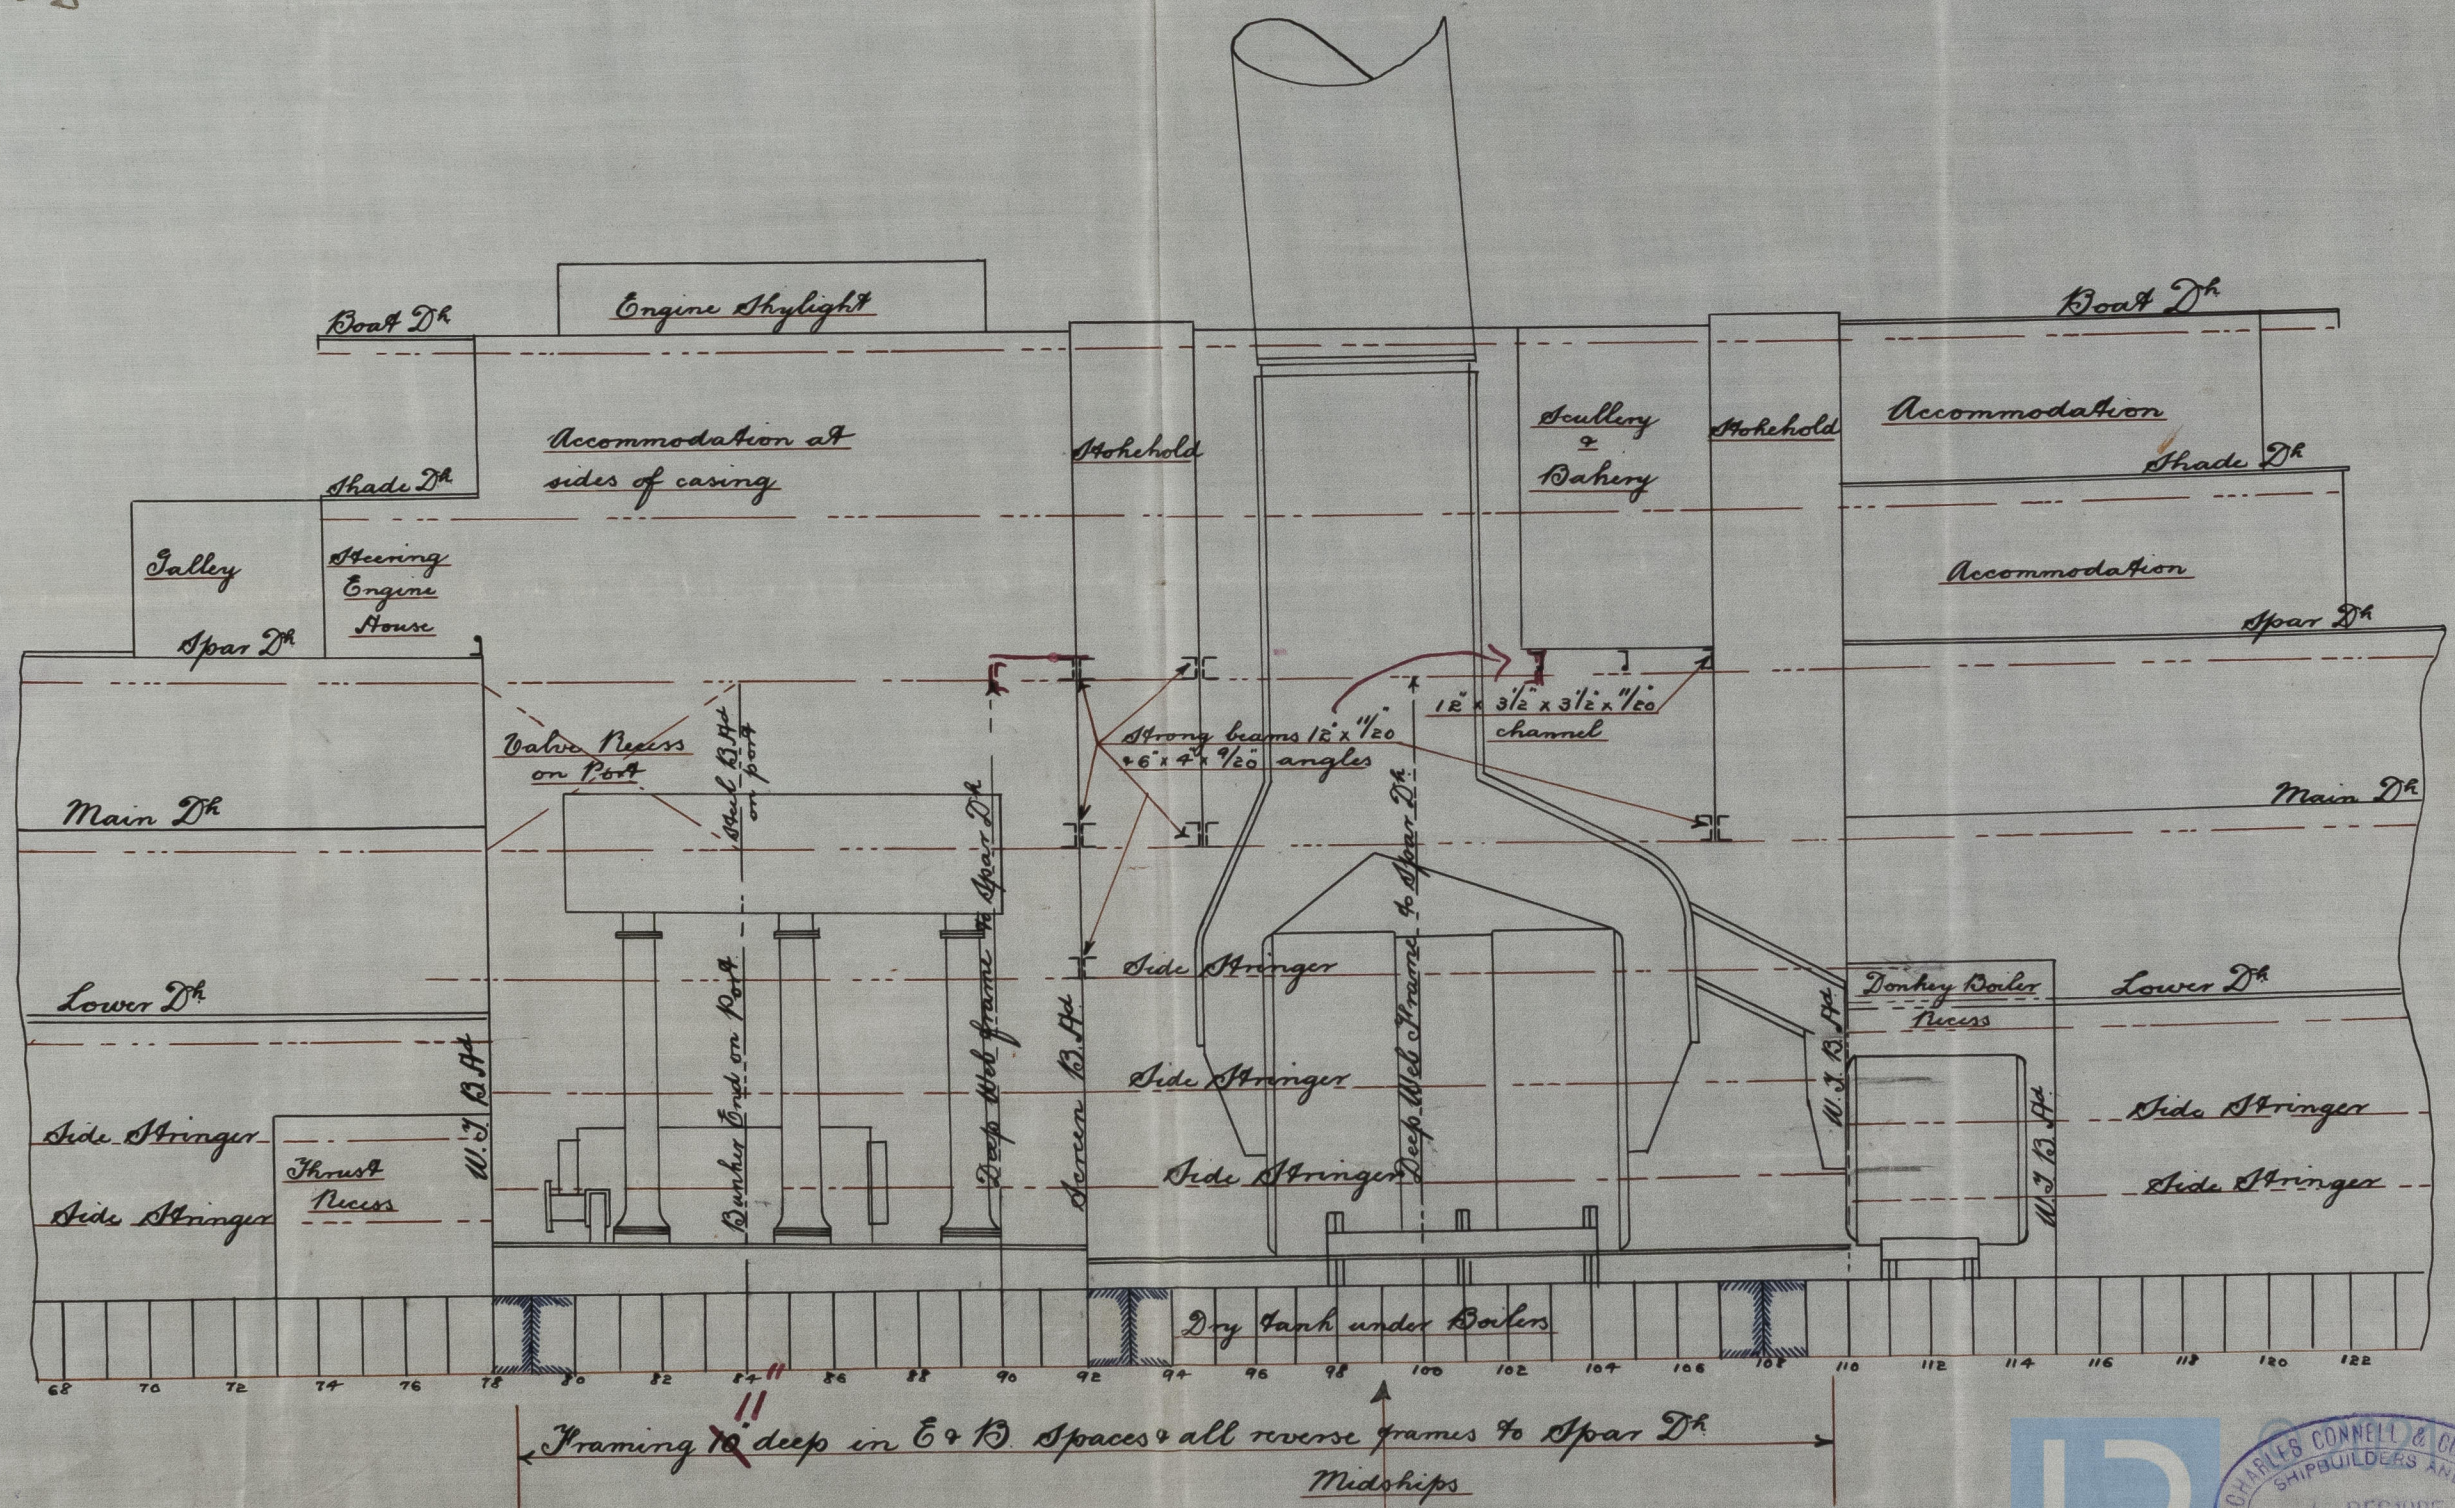

68  
70  
72  
74  
76  
78  
80  
82  
84  
86  
88  
90  
92  
94  
96  
98  
100  
102  
104  
106  
108  
110  
112  
114  
116  
118  
120  
122

7.12.05



No 309

W746-0170