

LLOYD'S REGISTER OF SHIPPING. Office. 22 JAN 1908

Lloyd's Register of British & Foreign Shipping.

(Report on Vessel No. 20166 Port Hull)
1/2 Hercules

No. 1996A SHIP FORGINGS OR CASTINGS.

I have to report that the undermentioned Iron or Steel Forgings or Castings, manufactured by Messrs T.S Forster & Sons of Sunderland for the Vessel No. 428, being built by Messrs Cochrane & Sons of Selly have been inspected by me as set forth below and found to be, so far as can be seen, Sound.

The words FORGINGS or CASTINGS, IRON or STEEL, should be struck out as may be required.

Mark on Forgings.



Lloyd's
No. 1996A
J.D.

Jervis Dale

Sunderland
21. 1. 08

	STERN FRAME.	RUDDER FRAME.	STEM.
Material*	<u>Scrap iron</u>	/	/
How made	<u>Forged & Smithed</u>	/	/
Dimensions	<u>6 X 3</u>	/	/
Progress on Inspection	<u>Forging & Smithing</u>	/	/
Date when Inspected	<u>24/12/07 2/1/08</u> <u>7/1/08 21/1/08</u>	/	/

SKETCHES OF FRAMES SHOWING POSITION AND DESCRIPTION OF WELDS OF FORGINGS, OR PARTICULARS OF TESTS APPLIED TO CASTINGS.

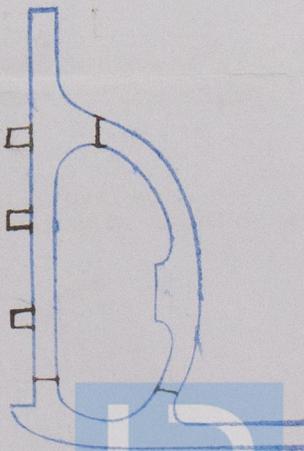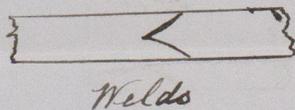

Fee (if any chargeable) £

To be paid at

* If of Iron, state whether scrap or puddled Iron.