

# MIDSHIP SECTION

STEEL SCREW TRAWLER

№ 428

DIM: 125'-0" B.P. x 22'-0" EX x 12'-10" DEPTH M-LD

SCALE  $\frac{1}{2}'' = \text{ONE FOOT.}$

ENGINE & BOILER CASING AS PREVIOUSLY APPROVED.

DECK PLATED IN WAY OF ENG & BOILER CASING

CLASS 100.A.1. AT LLOYDS.

## LLoyDS NUMERALS

1/2 GIRTH. 20.1

1/2 BREATH. 10:95.

DEPTH. 13.3.

44.35 1<sup>ST</sup>. NUMBER.

LENGTH PER RULE. 123.84.

5493 · 634 2<sup>ND</sup> NUMBER.

## PROPORTIONS

DEPTH TO LENGTH. 9:3"

BREADTH TO LENGTH. 5:6

## EQUIPMENT.

✓ 1<sup>st</sup>. BOWER. 5½ CWT. Ex Stock


2<sup>NO</sup> - - - 5

3<sup>ro</sup> - - - 2<sup>3/4</sup> .

105 FATHOMS 1/16 STD LINK CABLE.

60 - - - 6" HAWSER.

60 --- 4 1/2" WARP.

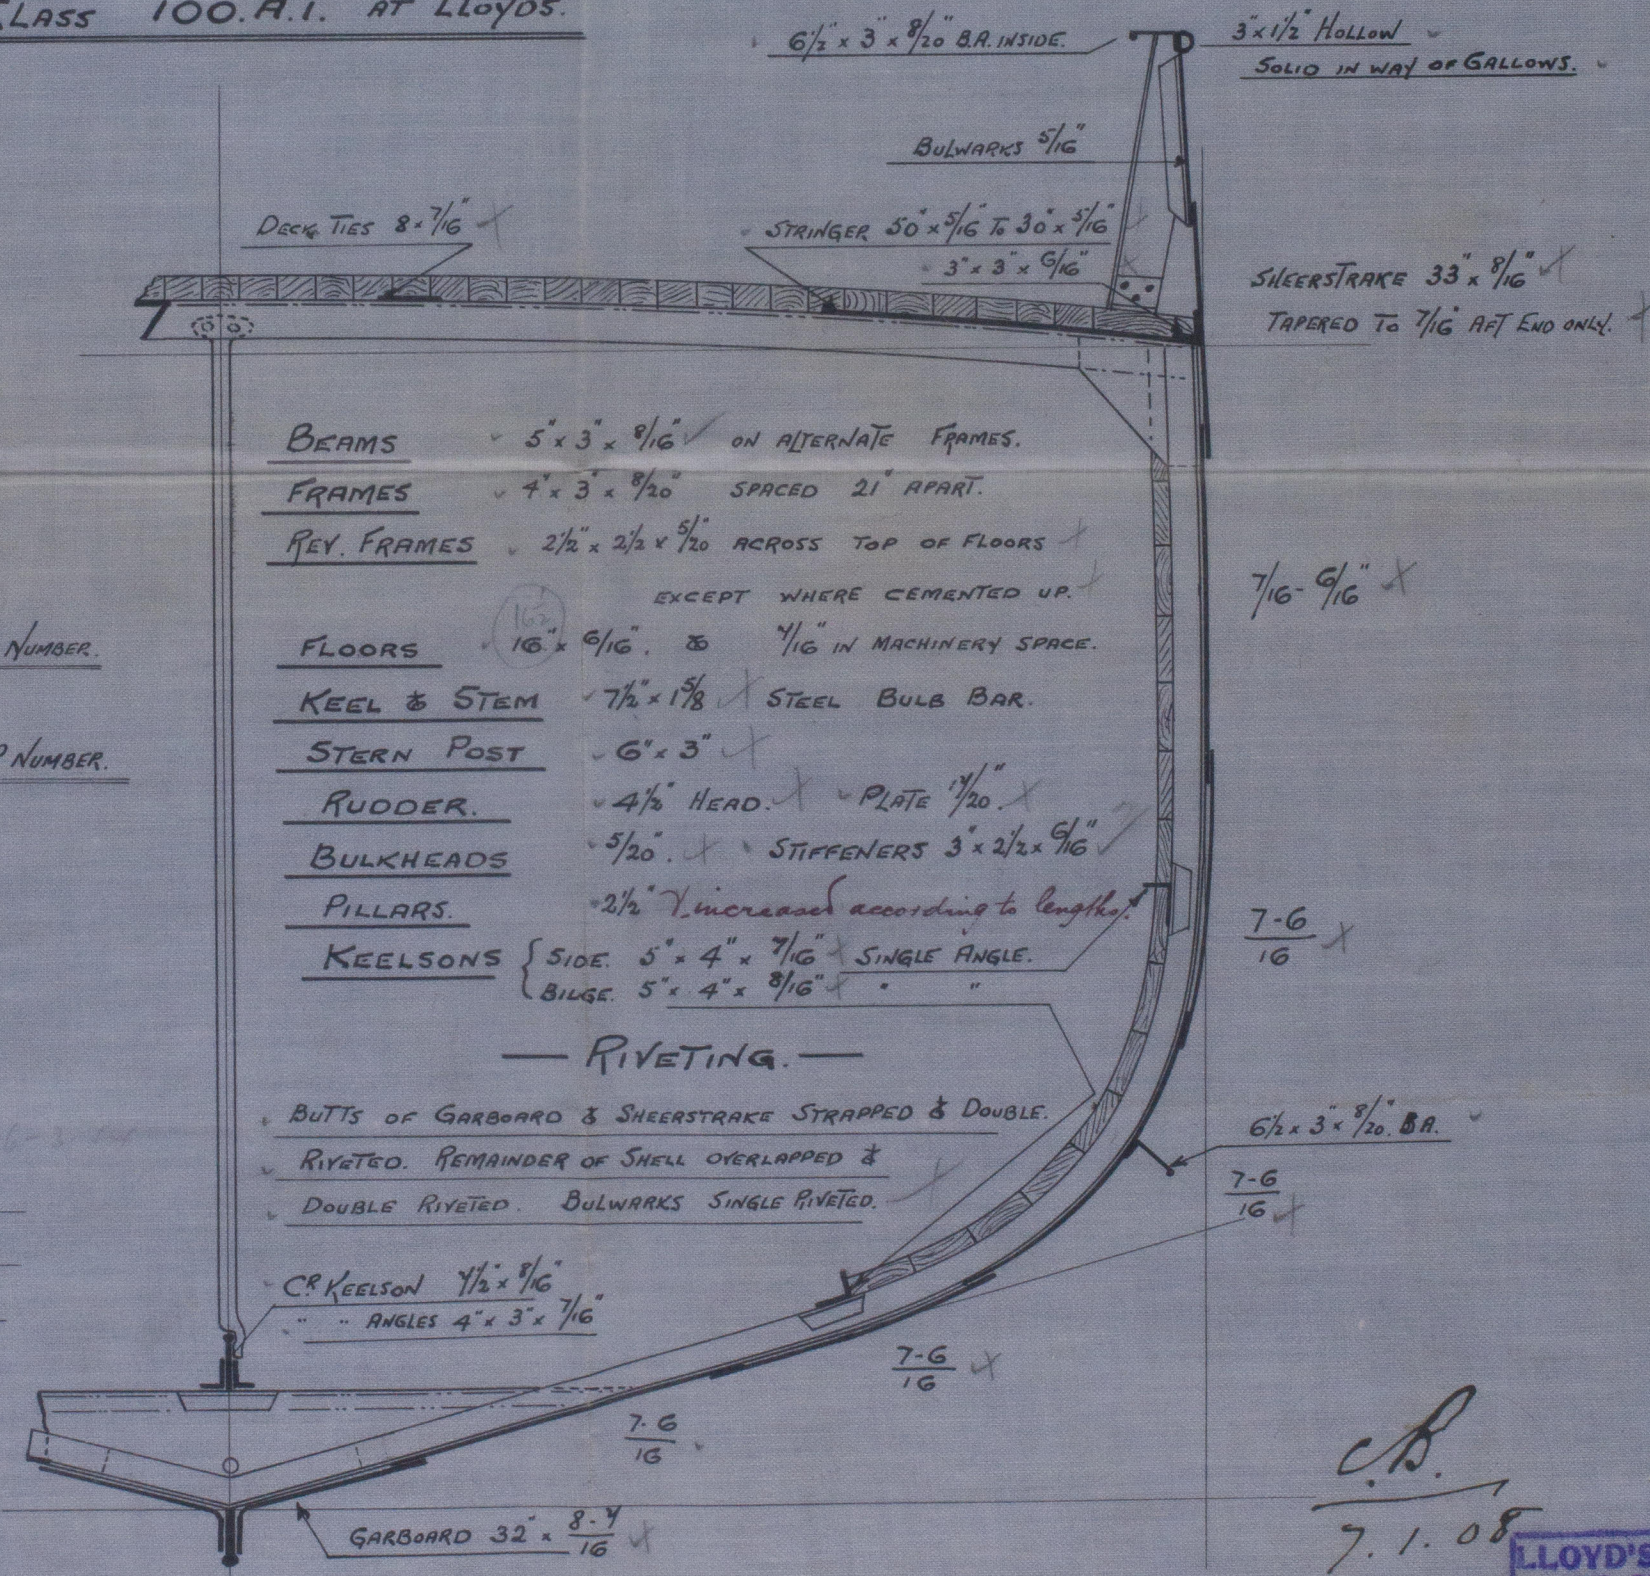

LLOYD'S REGISTER  
OF SHIPPING  
3 JAN 1908  
+ HULL +





Messrs  
Cochrane & Sons  
No 4 28

— Midship Section —

% Texes  
Hull Rpt No. 20.166



RETAIN



© 2020

Lloyd's Register  
Foundation