

7.12.08.


# PROFILE & DECK PLAN

STEEL SCREW TRAWLER.


N<sup>o</sup>. 428

SCALE  $\frac{1}{4}$ " = 1 FOOT


DIMS. 125'-0" x 22'-0" x 12'-10" MOULDED.

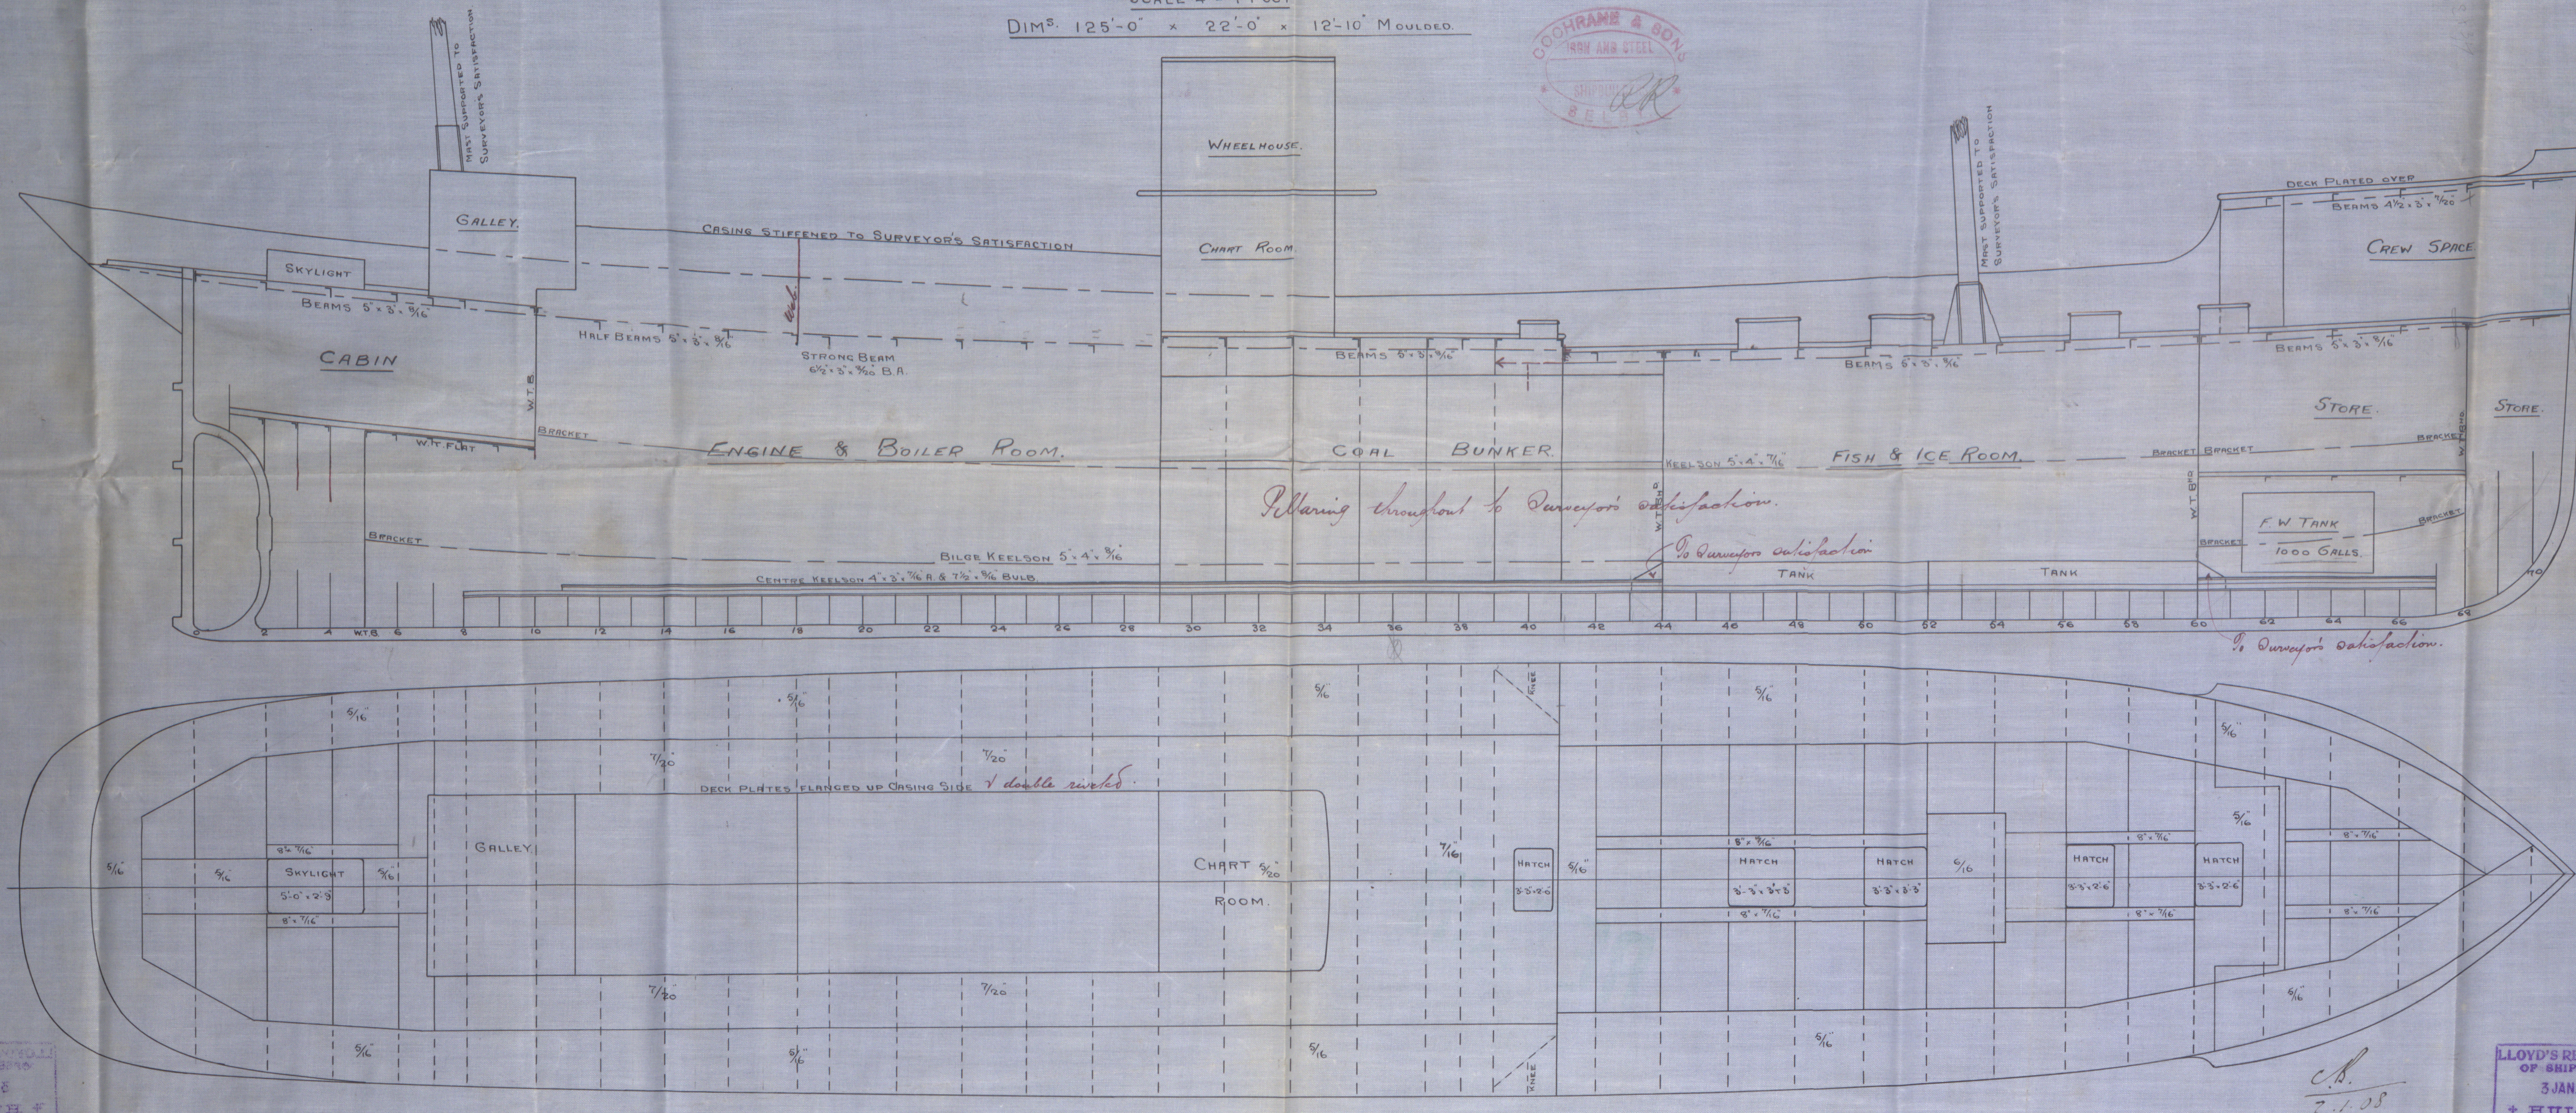

C.B.  
7.1.08

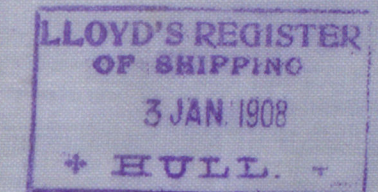


Plating throughout to Surveyor's satisfaction.

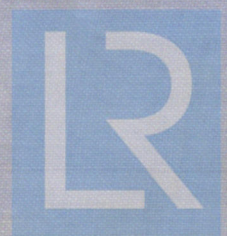

© 2020  
Lloyd's Register  
Foundation




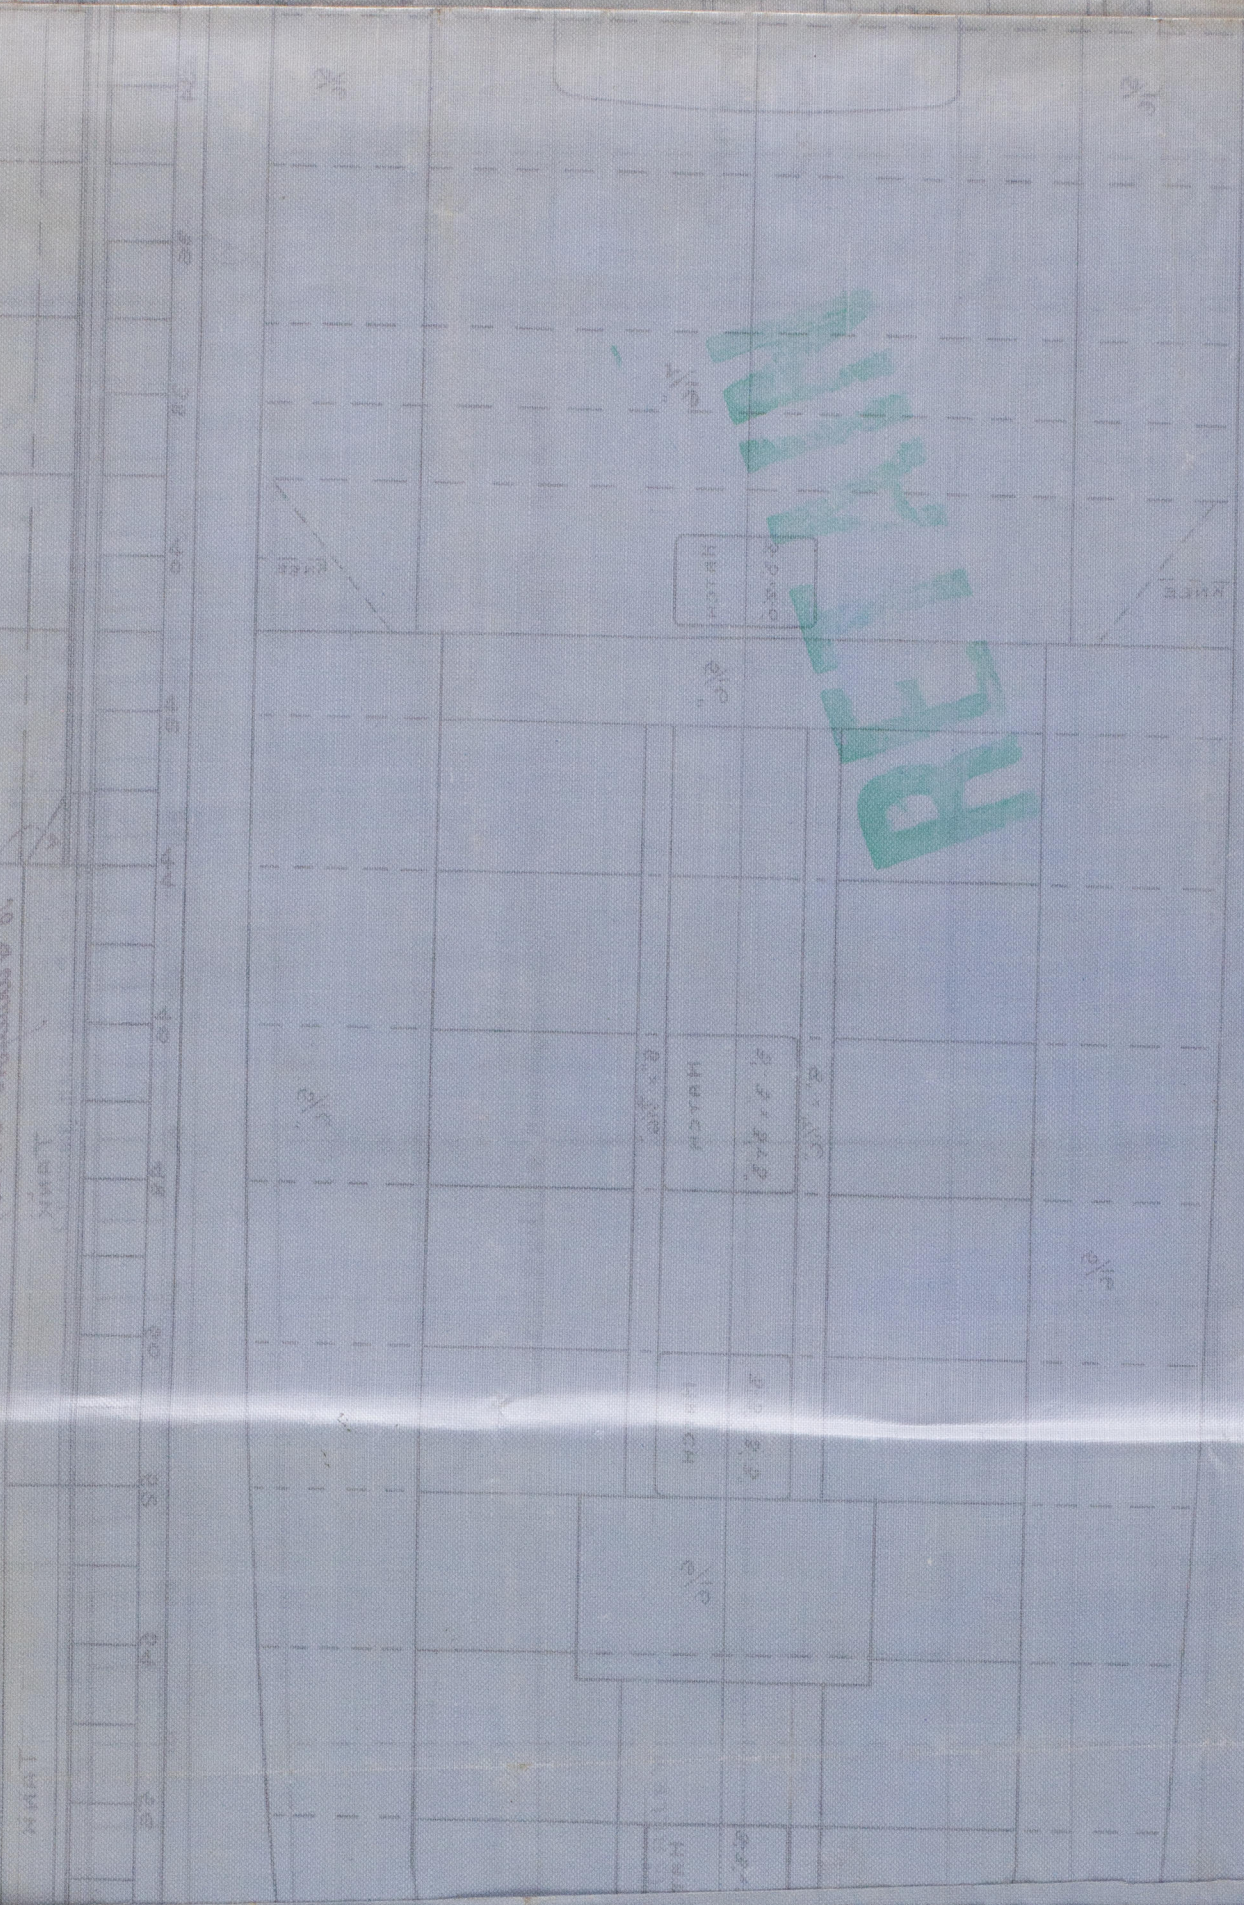

*Messrs  
Cochrane & Sons  
No 425  
Profile & Deck Plan —  
of 'Xerxes'  
Hull Report No. 20.166*

W747-0136

RETA



© 2020  
Lloyd's Register  
Foundation

2108E