

3. 1. 07.


S.S. N° 403 & 4.
MIDSHIP SECTION

DIMENSIONS. $136'-8'' \times 22'-10\frac{1}{2}''_{MLD} \times 13'-0''_{MLD}$.

SCALE $\frac{1}{2}$ = ONE FOOT.

-TO CLASS 100 A1. FOR FISHING PURPOSES.

ENGINE & BOILER CASING AS PREVIOUSLY APPROVED.
DECK PLATED OVER IN WAY OF MACHINERY.

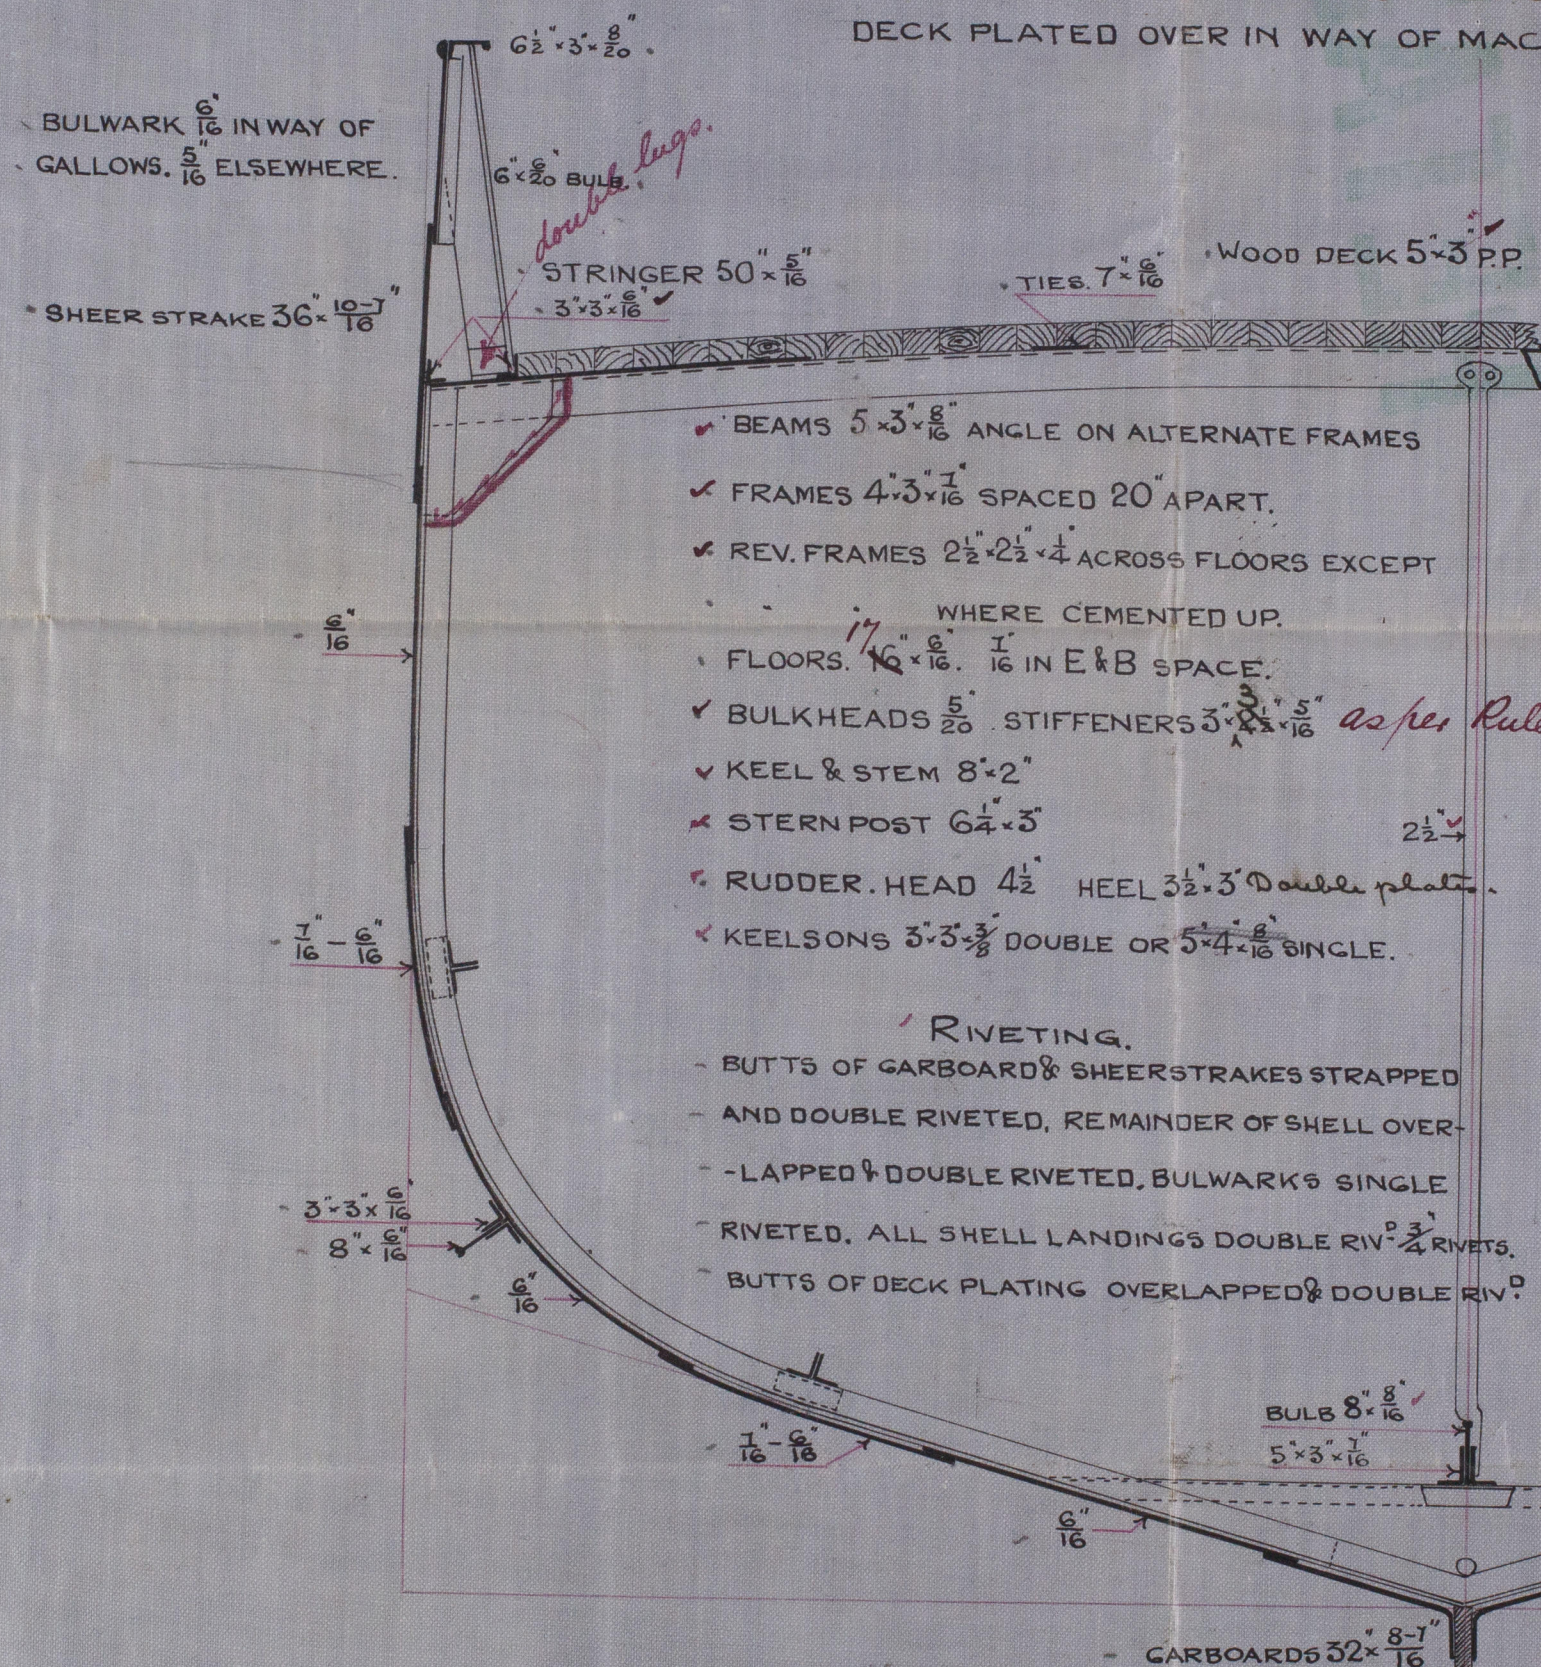

- NUMERALS.

1/2 BREADTH	11.44 ✓
1/2 GIRTH	20.52 ✓
DEPTH	13.48 ✓
1 ST NUMERAL	45.44 ✓
	135.49 ✓
2 ND NUMERAL.	6156.6 ✓

- PROPORTIONS

$$\frac{L}{B} = 5.92 \checkmark$$
$$\frac{L}{D} = 10.05 \checkmark$$

- EQUIPMENT

- ✓ - 1 BOWER ANCHOR 6 CWT EX STOCK OR $\frac{1}{2}$ CWT. STOCKLESS.
✓ - 1 " " 5 $\frac{1}{2}$ " " "
✓ - 1 " " 3 " " "
✓ 120 FATHOMS 1 $\frac{2}{16}$ " STUD LINK CABLE.
✓ 60 " 6" HAWSER
✓ 60 " 5" WARP.

C.B.
3. 1. 02


Cochrane & Sons.

No. 403 ~~404~~.

Midship Section.

s/s "Tokio"

Hull Report No. 19383.

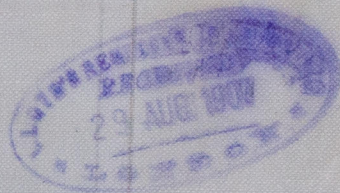

SECTION.

No. 403 ~~404~~.

© 2021

Lloyd's Register
Foundation

W 744-0064