

PROFILE & DECK PLAN.



STEEL SCREW TRAWLERS

Nos 403 & 4.

$$\begin{array}{r} -8 \times 23 - 0 \times 13 - 0 \end{array}$$

Dim's $136'-8'' \times 23'-0'' \times 13'-0''$ MOULDED.

SCALE $\frac{1}{4}'' = 1 \text{ FOOT.}$

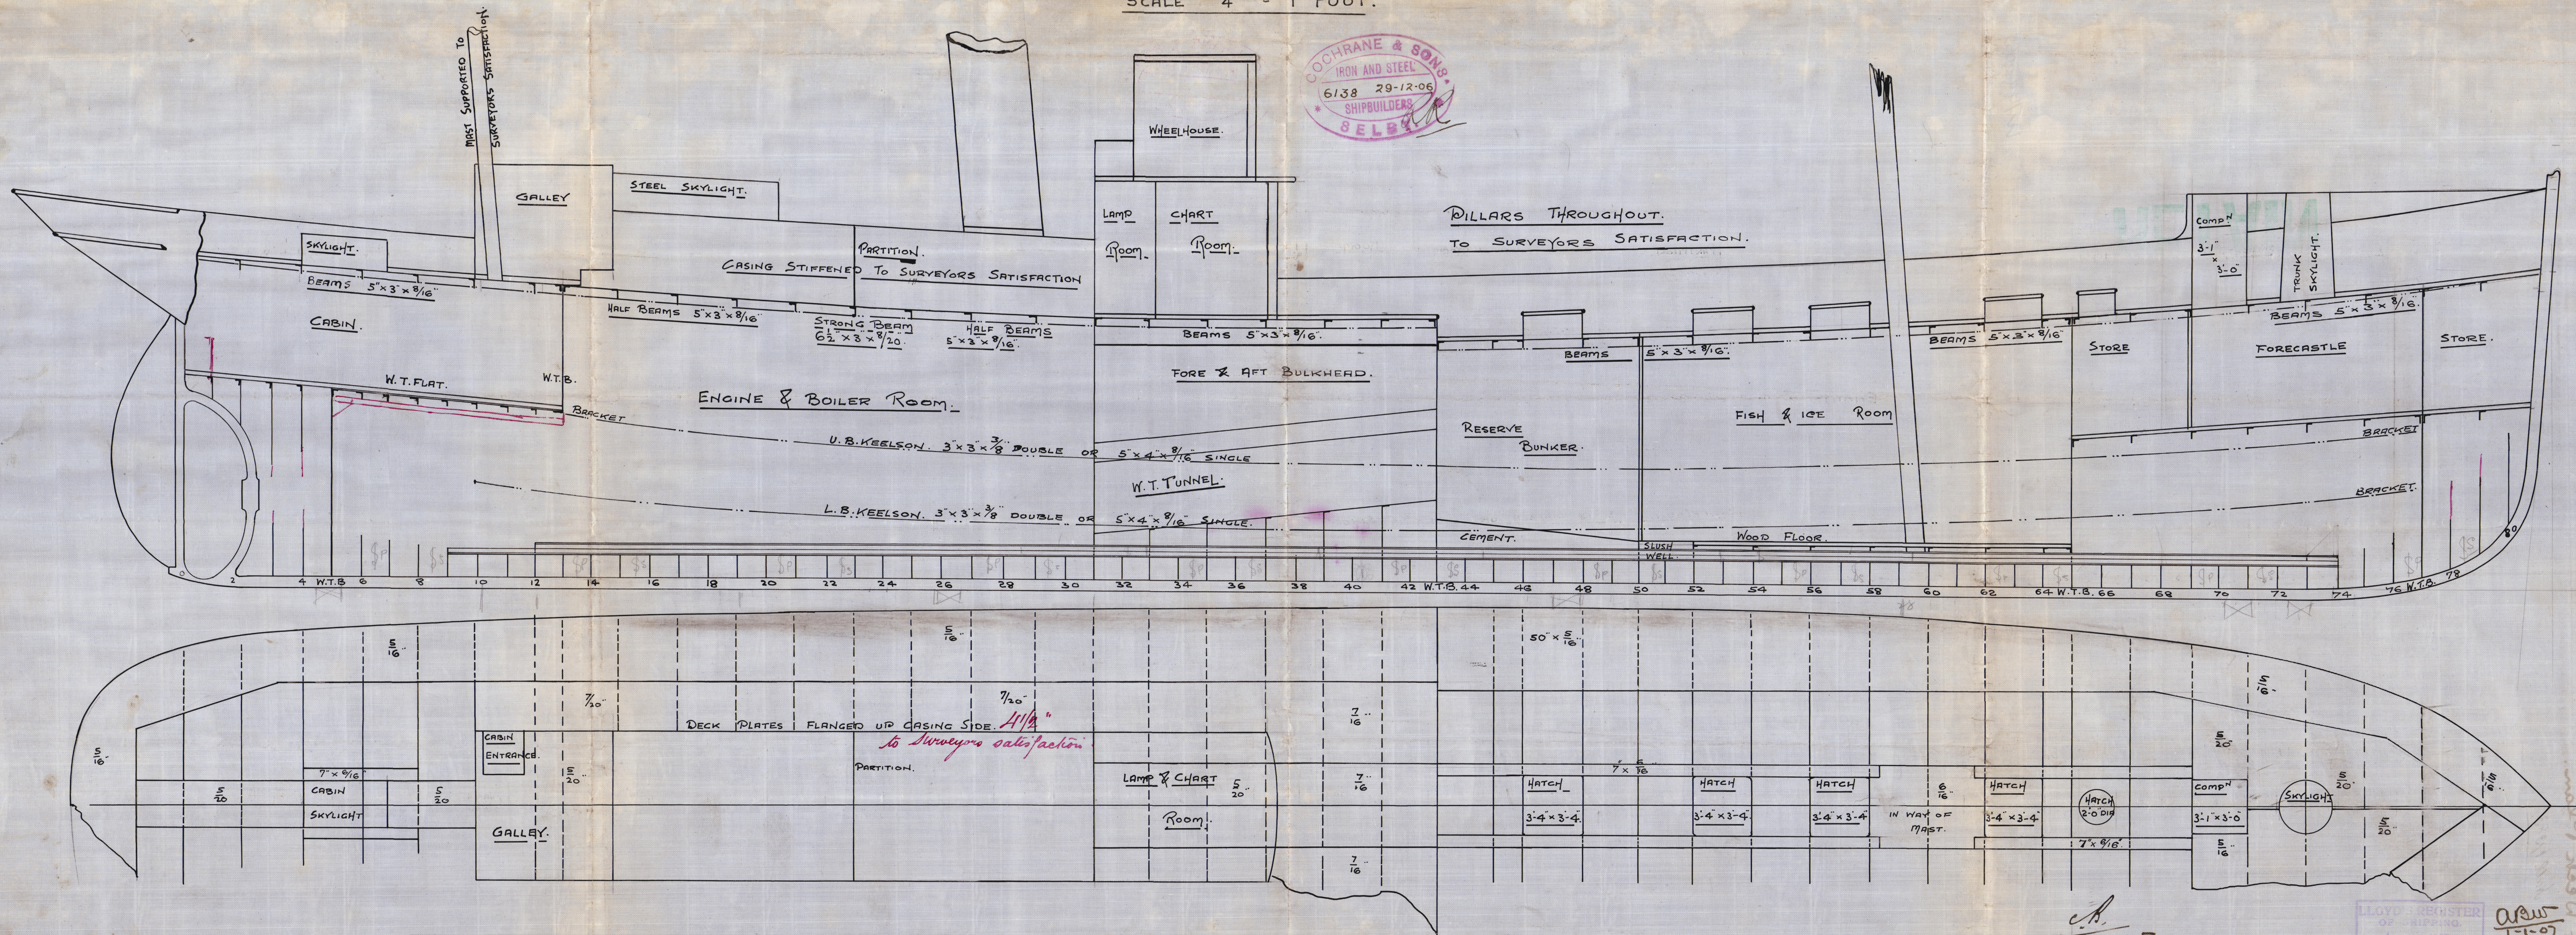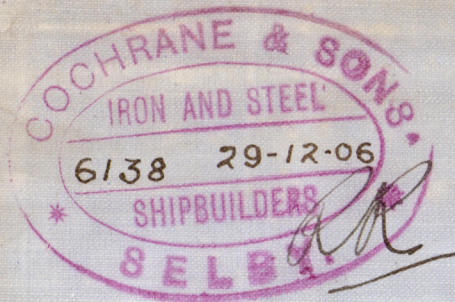

C.B.
3.4.07

ans
1-1-07

© 2021
Lloyd's Register
Foundation

© 2021

Cochrane & Sons.
No 403 ~~404~~.
Midship Section.

s/s "Tokio"
Hull Report No. 19383.



RETAIN

MIDSHIP SECTION
No 403



W744-0064

