


26-5-03



Deckplan for new building Steel screw Steamer N^o 246
Class 100 A I to Lloyd's

scale 1/4" = one foot.

 


C.B.
29.5.03.
Capt. A. Vrijk.

Pass. Brechin gear.

Deck plans

L.L. 246.

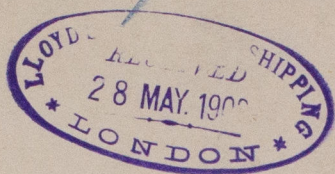

8 1/2 x 9 1/20 -



Steamer. *Thelma.*

Rotterdam Report 3798.

Deck Plan.

RETAIN



© 2021

Lloyd's Register
Foundation
W750-0082