

26-5-03

Longitudinal Section of Engine & Boiler space.

showing position of Engine & Boiler.


S.S. 246.

Scale $\frac{1}{4}$ inch = one Foot.

Shipbuilding Works.

Capelle a/yssel.

Holland.

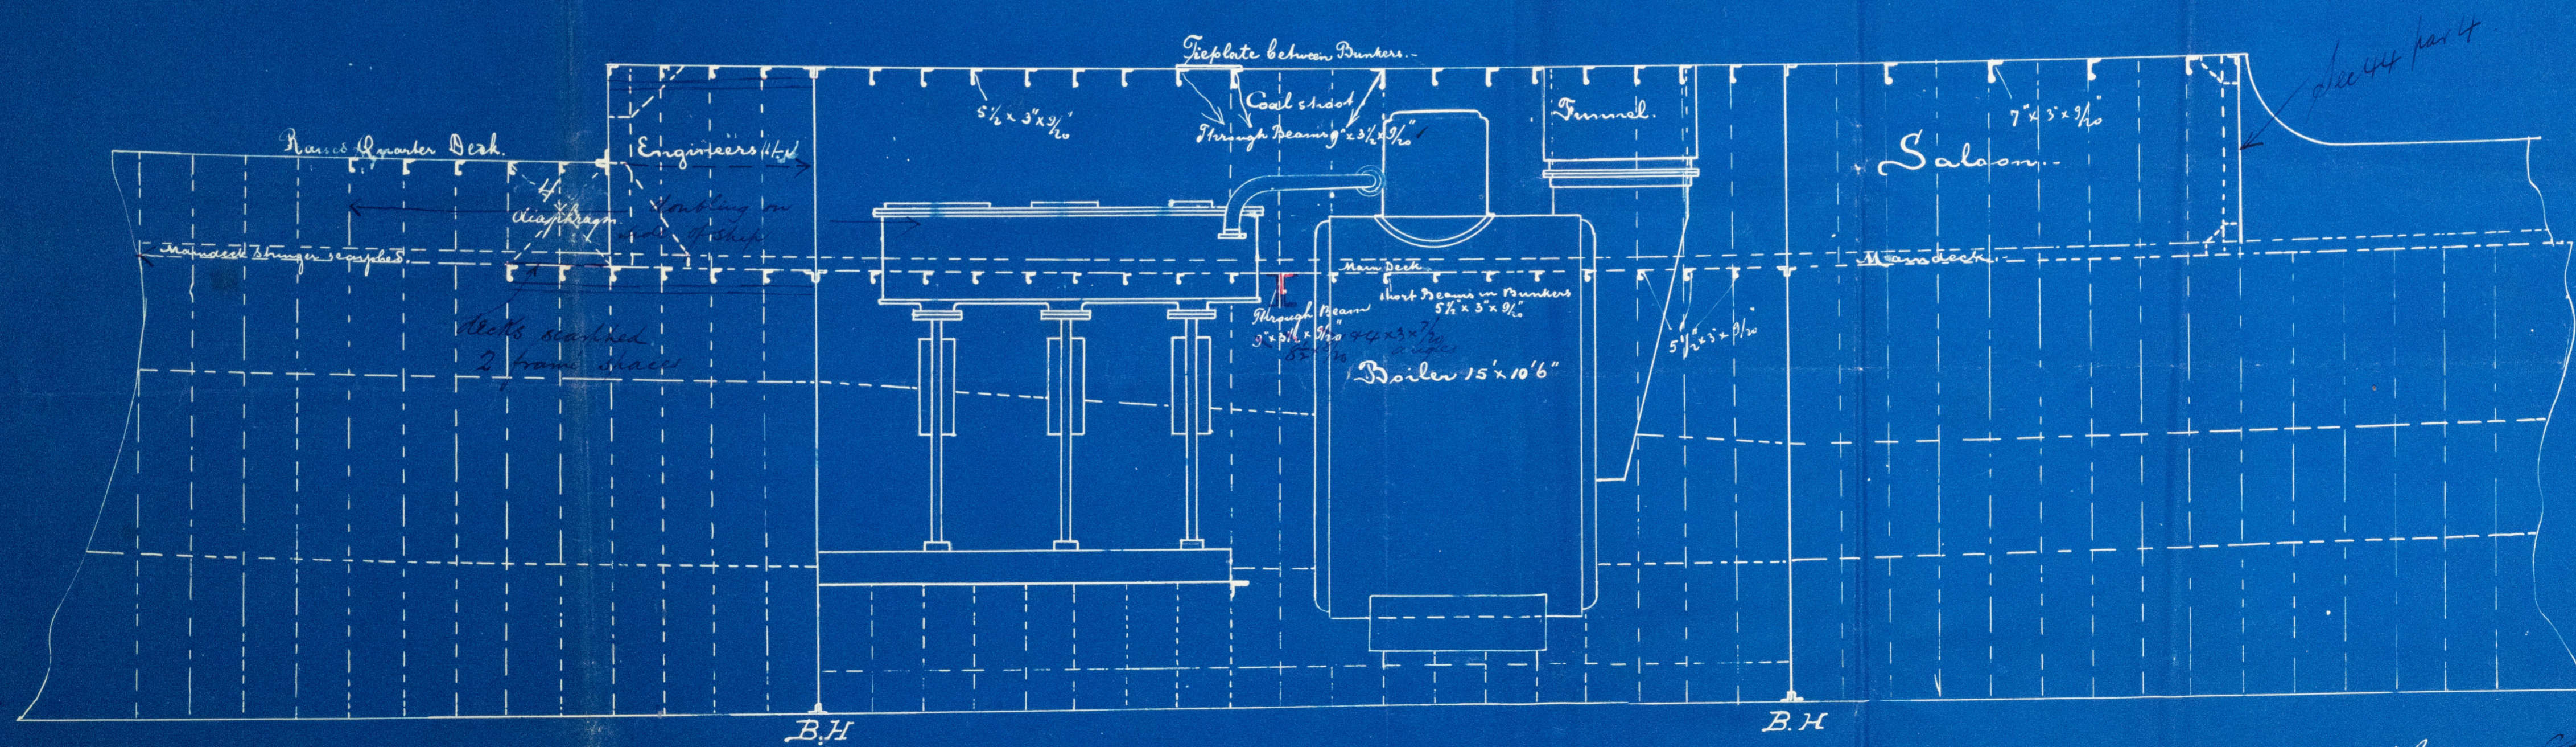

Drawn
1/10/03

C.S.

29-5-03

R

Navy's Register
150-0013