

sp *Larkary*Received at *Middlesex* Office, *8 June 1891*

Lloyd's Register of British and Foreign Shipping.

(Report on Vessel No. *3153* Port *Middlesbrough*)No. *6148*

SHIP FORGINGS OR CASTINGS.

I have to report that the undermentioned Iron ~~or Steel~~ Forgings ~~or Castings~~,
 manufactured by *Messrs. The Walsaydon Forge Co.*
 of *Walsaydon-on-Lyne* for the Vessel No. *628*, being built
 by *Messrs. Richardson, Duck & Co. Stockton-on-Tees*
 have been inspected by me as set forth below, and found to be, so far as can be seen,
Sound.

*The position of the welds are
 Indicated by the letter O.*


Mark on Forgings.

Lloyd's

No. *10486*
H. C.*W Campbell.**Newcastle 7/6/01.*

| | STERN FRAME. | RUDDER FRAME. | STEM. |
|------------------------|--------------|---------------------------------------|-------|
| Material* | ✓ | <i>Scrap.</i> | ✓ |
| How made | | <i>Forged & Smithed.</i> | |
| Dimensions | | <i>92.</i> | |
| Progress on Inspection | | <i>Smithing.</i> | |
| Date when Inspected | | <i>May 26. 24. x</i> <i>30. 01</i> | |

SKETCHES OF FRAMES SHOWING POSITION AND DESCRIPTION OF WELDS OF FORGINGS, OR PARTICULARS OF
 TESTS APPLIED TO CASTINGS.

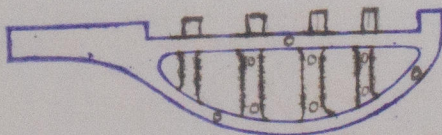

Fee (if any chargeable) £

To be paid at



© 2021

Lloyd's Register
Foundation

* If of Iron, state whether scrap or puddled Iron.

W751-0014