


# MIDSHIP SECTION.

SCALE 1/2" = 1 FOOT.

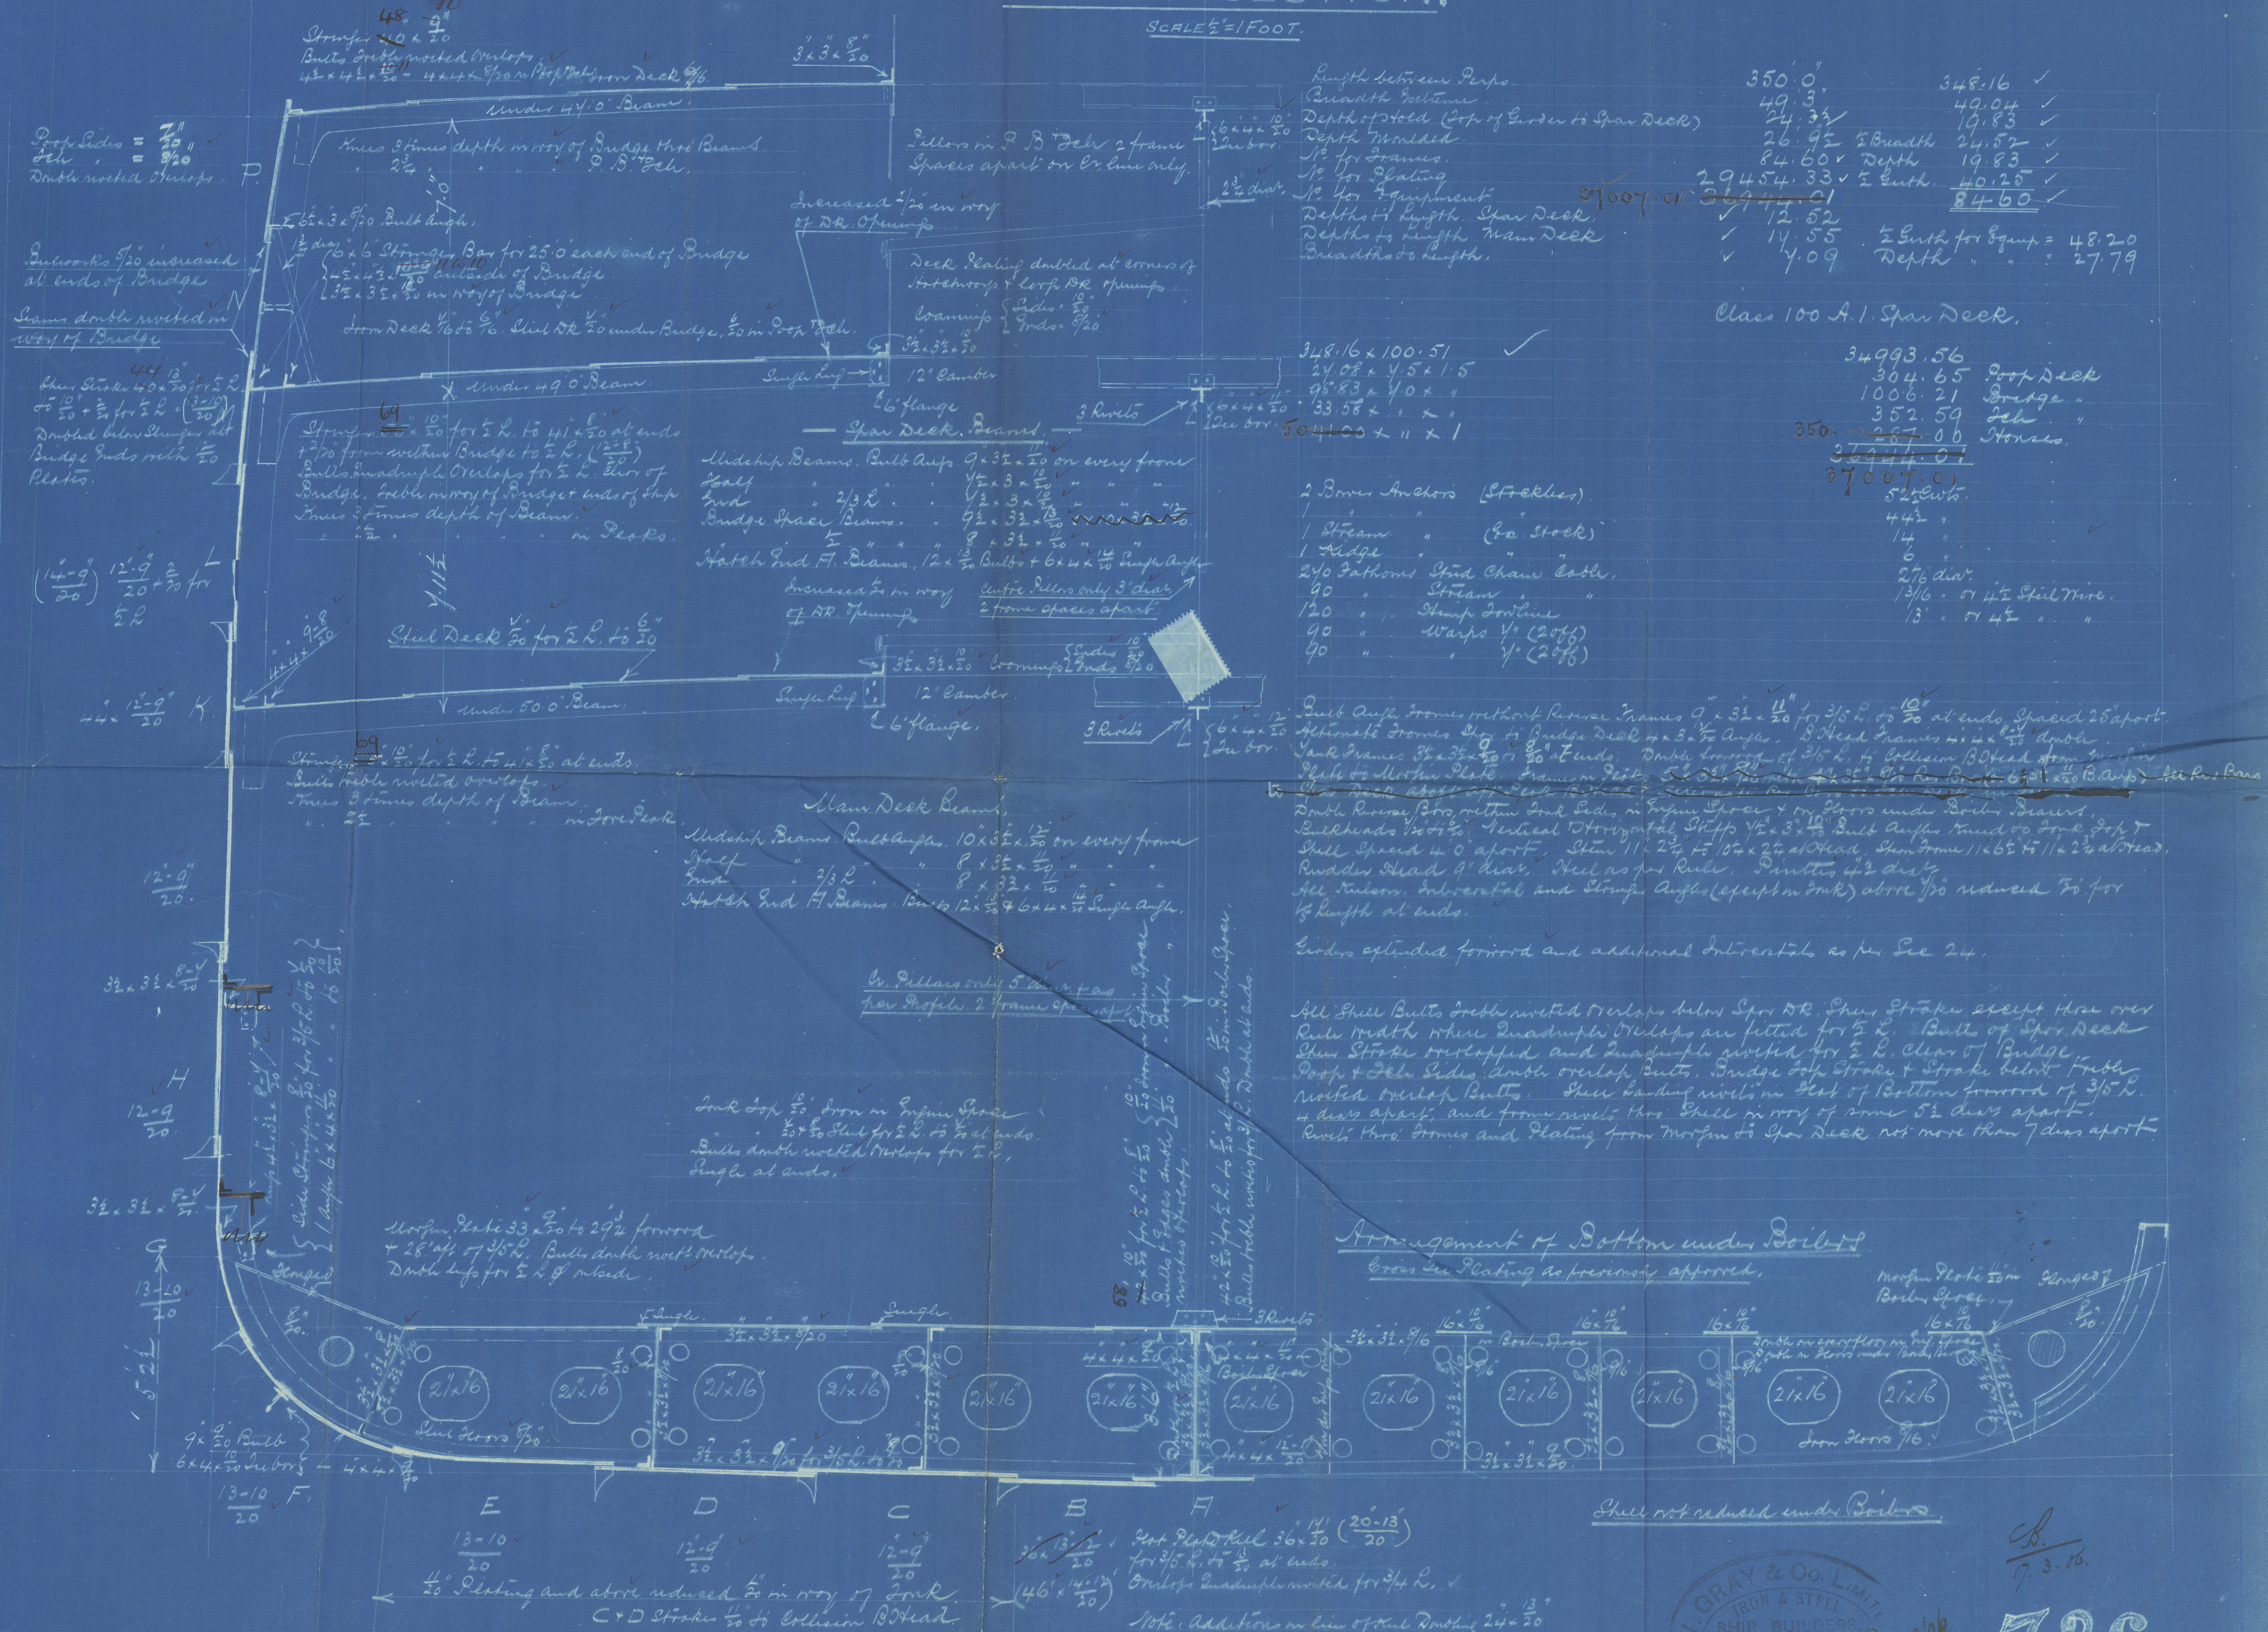

736.





W Gray & Co Ltd  
No 736


Midship Section

SS "Tangistan"

Hbl kpt to



RETAIN

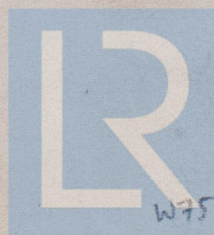

© 2021

Lloyd's Register  
Foundation

W751-0129