

Combustion Chambers 82

Sub Plates	33
------------	----

Total 4 6 6 Sqr. ft.

Total Grate Surface 38 Sqr. Ft.


Working Pressure 90 lbs. per sq. inch.

1 off shoes

June 22/06

Plate 44.6 %

Rivet 80.3 %

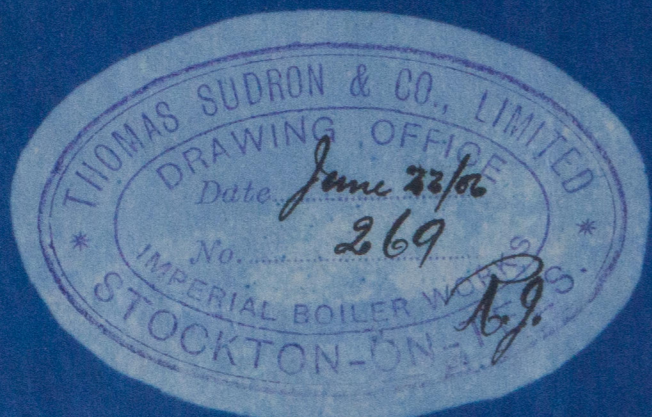

10'-0" Outside sea

J. S. S. & Co.

2147

For W. S. & Co. 7/8 716

90 lb m r

Prob report No. 4440

vs. "Janyiskew"

App. Report No. 13100

No.	3762
LLOYD'S TEST.	
	180 lbs.
	14.9.06
	C.J.H.

31 Plates



REMAIN



© 2021

Lloyd's Register
Foundation

W751-0131