

13.4.04
8.6.04
14.6.04

IRVINE'S
SHIP BUILDING
AND
DRY DOCKS CO LTD
WEST HARTLEPOOL


-PROFILE-

S S 331'-0" x 48'-0" x 24'-0"

SCALE 1/8" = 1 FOOT

not to be used
for
other
purposes
than
as
shown
on
this
drawing

REVIEW

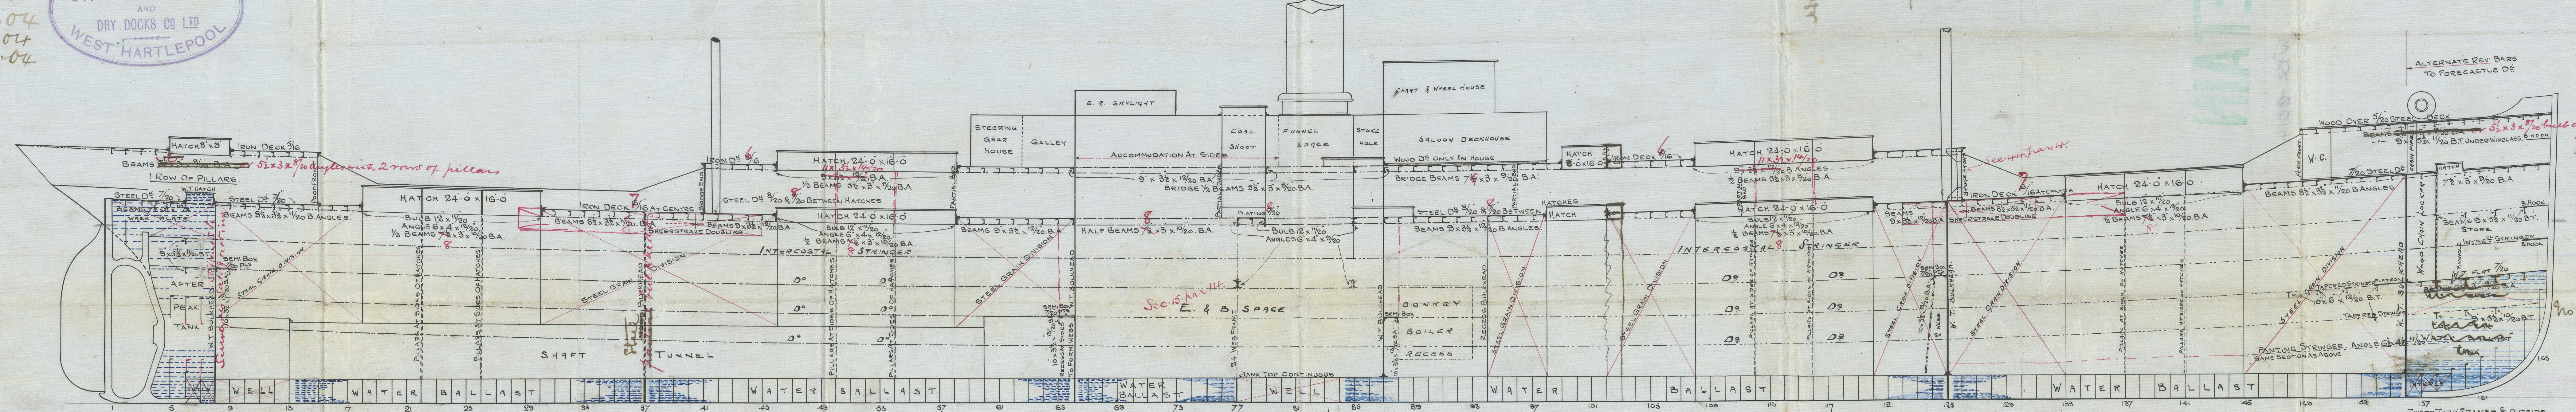

-S.S. 139-

-S.S. 139-

Irvine & Butts Ltd

no 139

Profile

SS^u Kinglor

Hpl. Report No. 12498

RETAIN



W752-0014

© 2020

Lloyd's Register
Foundation