

S.S. 139. MIDSHIP SECTION.

STEEL SCREW STEAMER.


SCALE $\frac{1}{2}$ = ONE FOOT

LENGTH B.P. 331' 0"
BREADTH EXTREME 48' 0"
DEPTH MOULDED 24' 0"

EQUIPMENT.

2 BOWER ANCHORS STOCKLESS EACH 47½ CWTs
1 " " " " " " 40½ " "
1 STREAM ANCHOR EX STOCK 11½ " "
1 KEDGE " " 5½ " "
270 FATHOMS 2" STUD CHAIN CABLE
90 " " 1½" STREAM CHAIN OR 4½" STEEL WIRE.
120 " " 4" STEEL WIRE TOWLINE.
2 @ 90 " " 7" HAWSER
2 @ 90 " " 7" WARP

13.4.04
8.6.04
14.6.04
LLOYD'S NUMERALS —
LENGTH PER RULE 329' 33"
HALF BEAM MOULDED 23' 92"
DEPTH OF HOLD & FLOORS 24' 96"
HALF GIRTH 45' 02"
FRAME NUMBER 93' 90 & 86' 90
PLATING NUMBER 30924 & 28618
EQUIPMENT NUMBER 94212 33738 WITH HOUSES
DEPTHS IN LENGTH 13' 15"
BREADTHS IN LENGTH 6' 88"
CLASS 100 A.1.

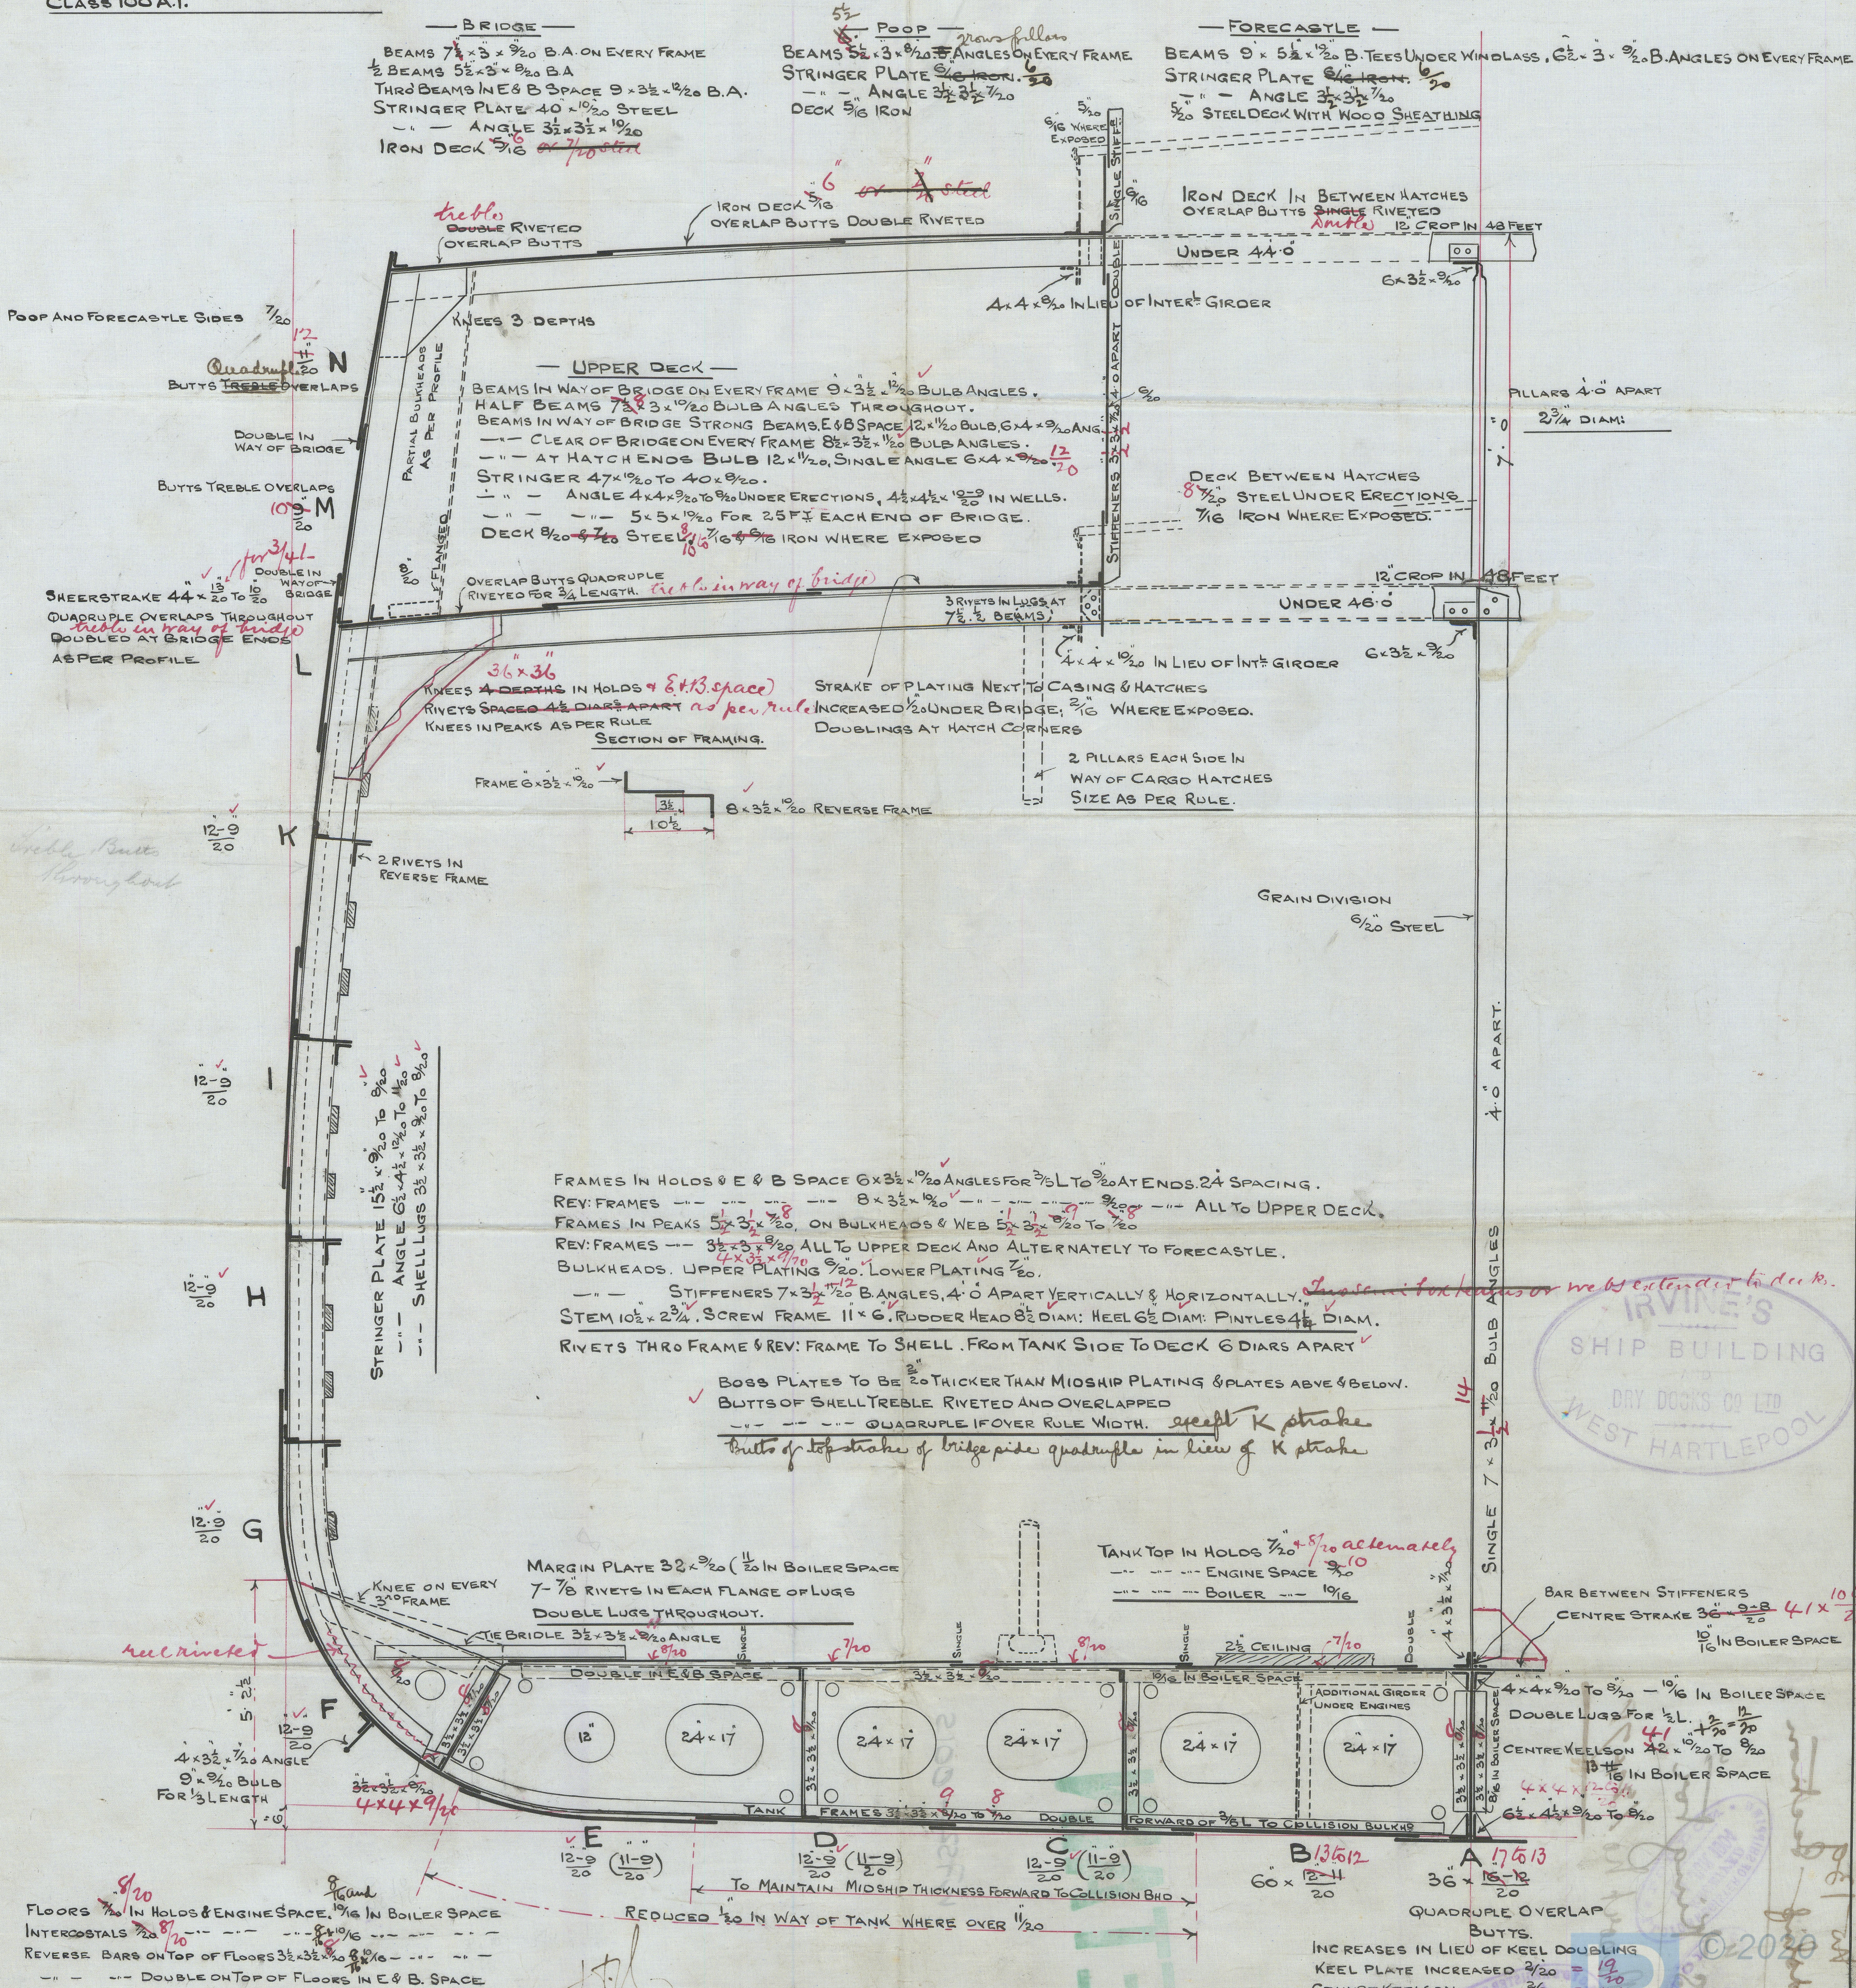

IRVINE'S
SHIP BUILDING
AND
DRY DOCKS CO LTD
WEST HARTLEPOOL

Irwin's Sket & Co

No 139

Midship Section

SS King box

Hpl Report No. 12478

RETAIN

R

© 2020

Lloyd's Register
Foundation