

7.6.11

800
200
200

PROFILE AND DECK PLAN


STEEL SCREW TRAWLER

No 508


DIMS 136'8" BP x 23'0" EX x 13'0" MLD

SCALE 1/4" = ONE FOOT.

PLAN NO. 390
FOR ENCLOSURE TO
Messrs Lloyd's Surveyors
Hull
FROM
DOUGHERTY & SONS
SHIPBUILDERS LTD
DATE 2/6/11 R.R.

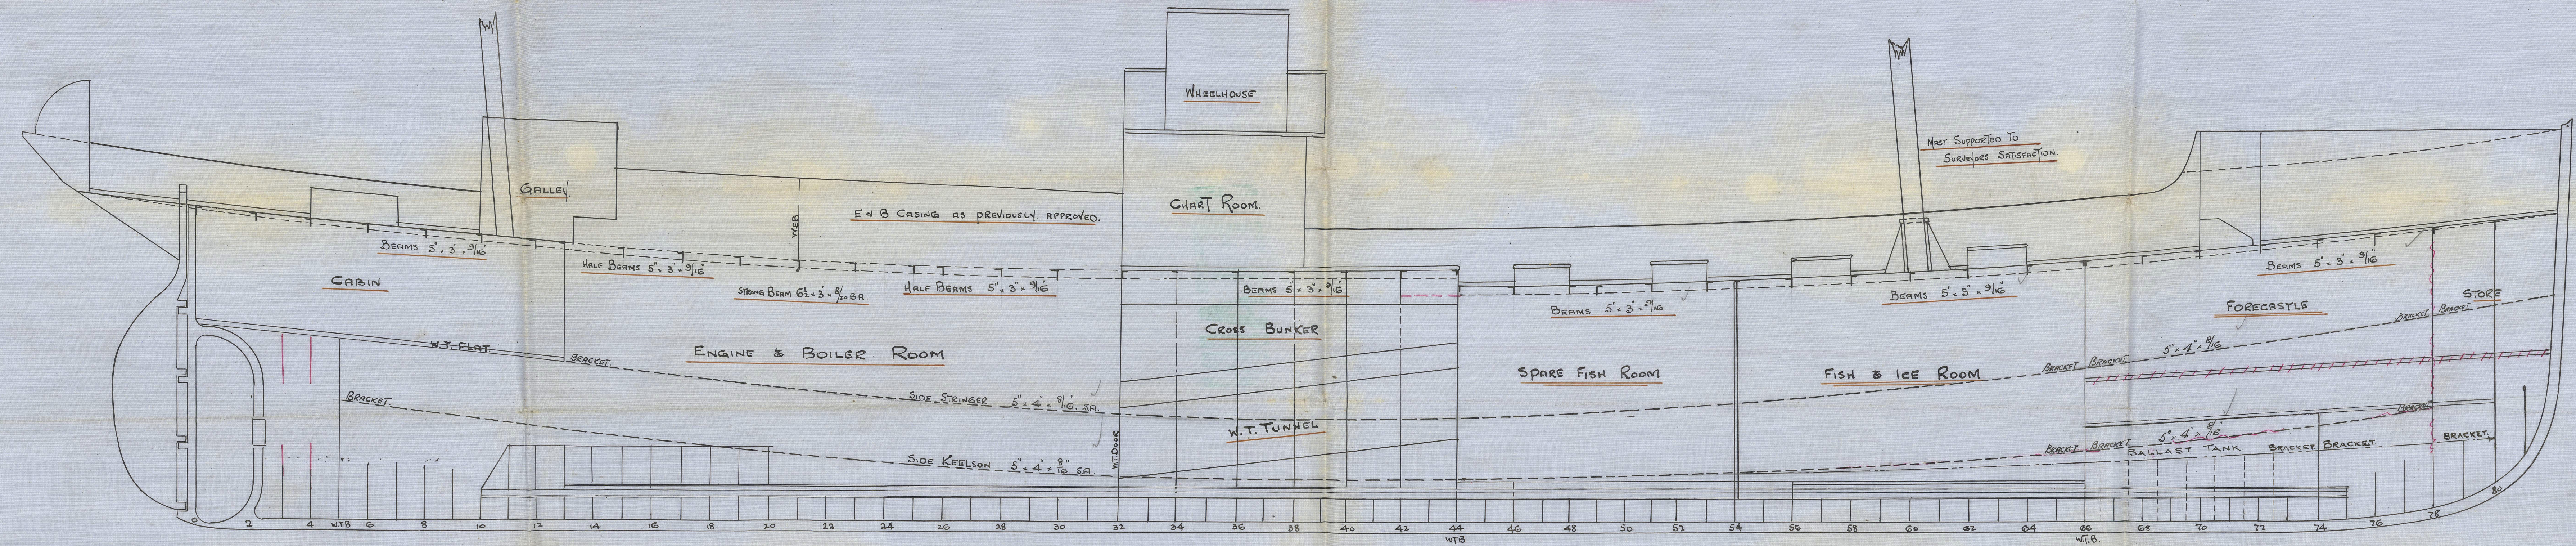



PILLARS TO SURVEYORS SATISFACTION.

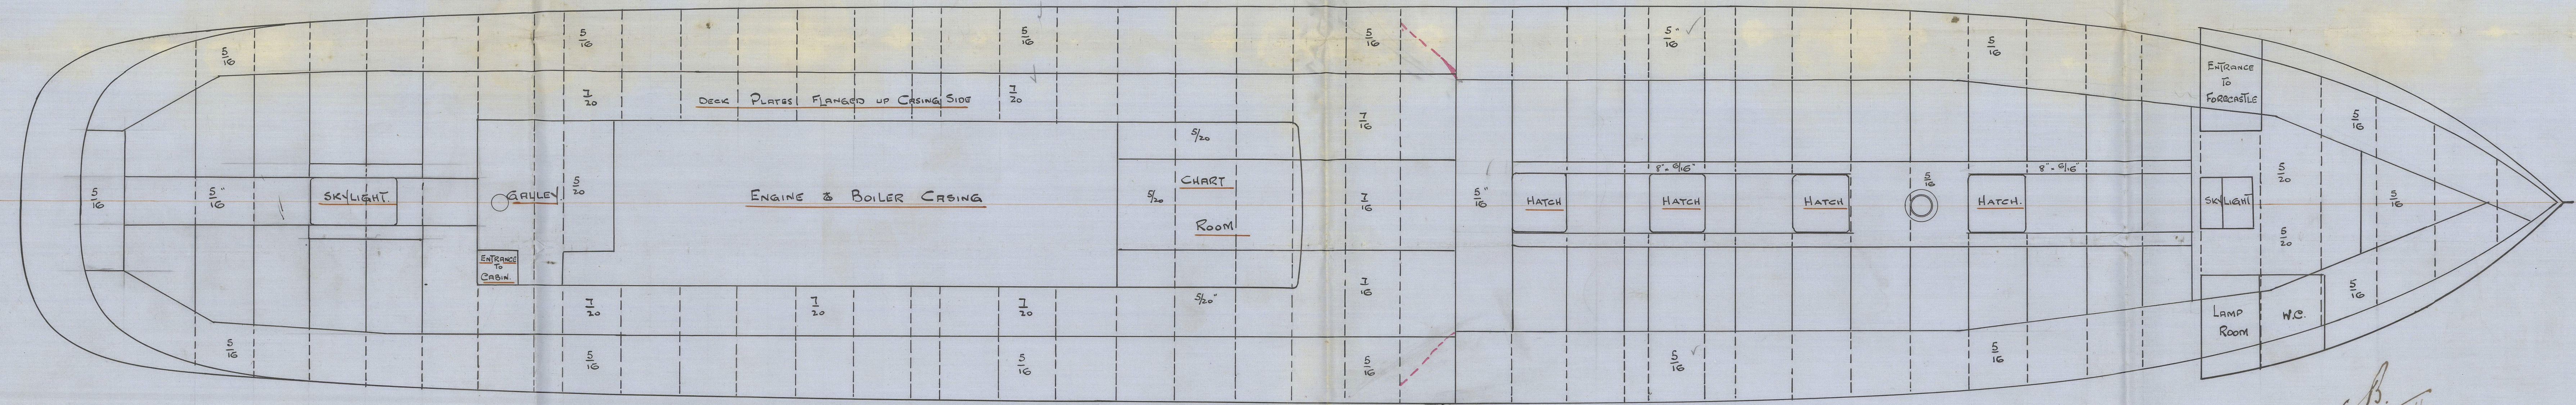

Profile + Deck

Bochvane's 508

L. Skuli Fogati Hull Npt 98!
24526

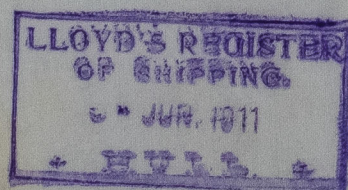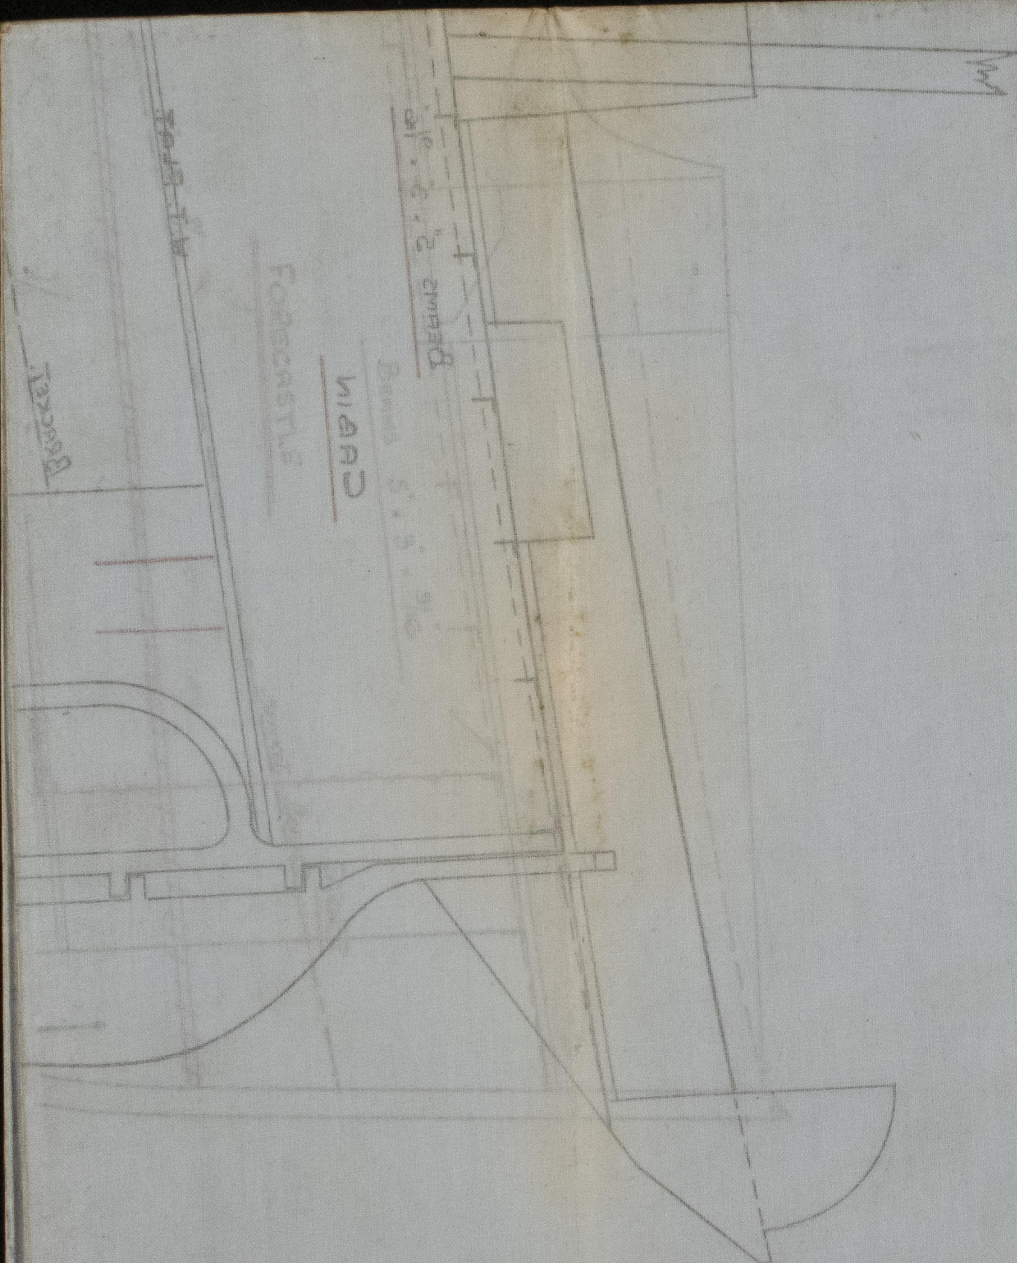

W753-0037



© 2021

Lloyd's Register
Foundation