

7.6.11

MIDSHIP SECTION

No 508


STEEL SCREW TRAWLER.

DIMS 136'-8" x 23'-0" EX x 13'-0" DEPTH MLO

SCALE $\frac{1}{2}$ " = ONE FOOT

TO CLASS 100.A.1. AT LLOYDS FOR FISHING PURPOSES.
ENGINE & BOILER CRISING AS PREVIOUSLY APPROVED.

PLAN No 391
FOR ENCLOSURE TO
Messrs Lloyd's Surveyors
Hull
FROM
DOCHRANE & SONS
SHIPBUILDERS, SELE
DATE 2/6/11 RK

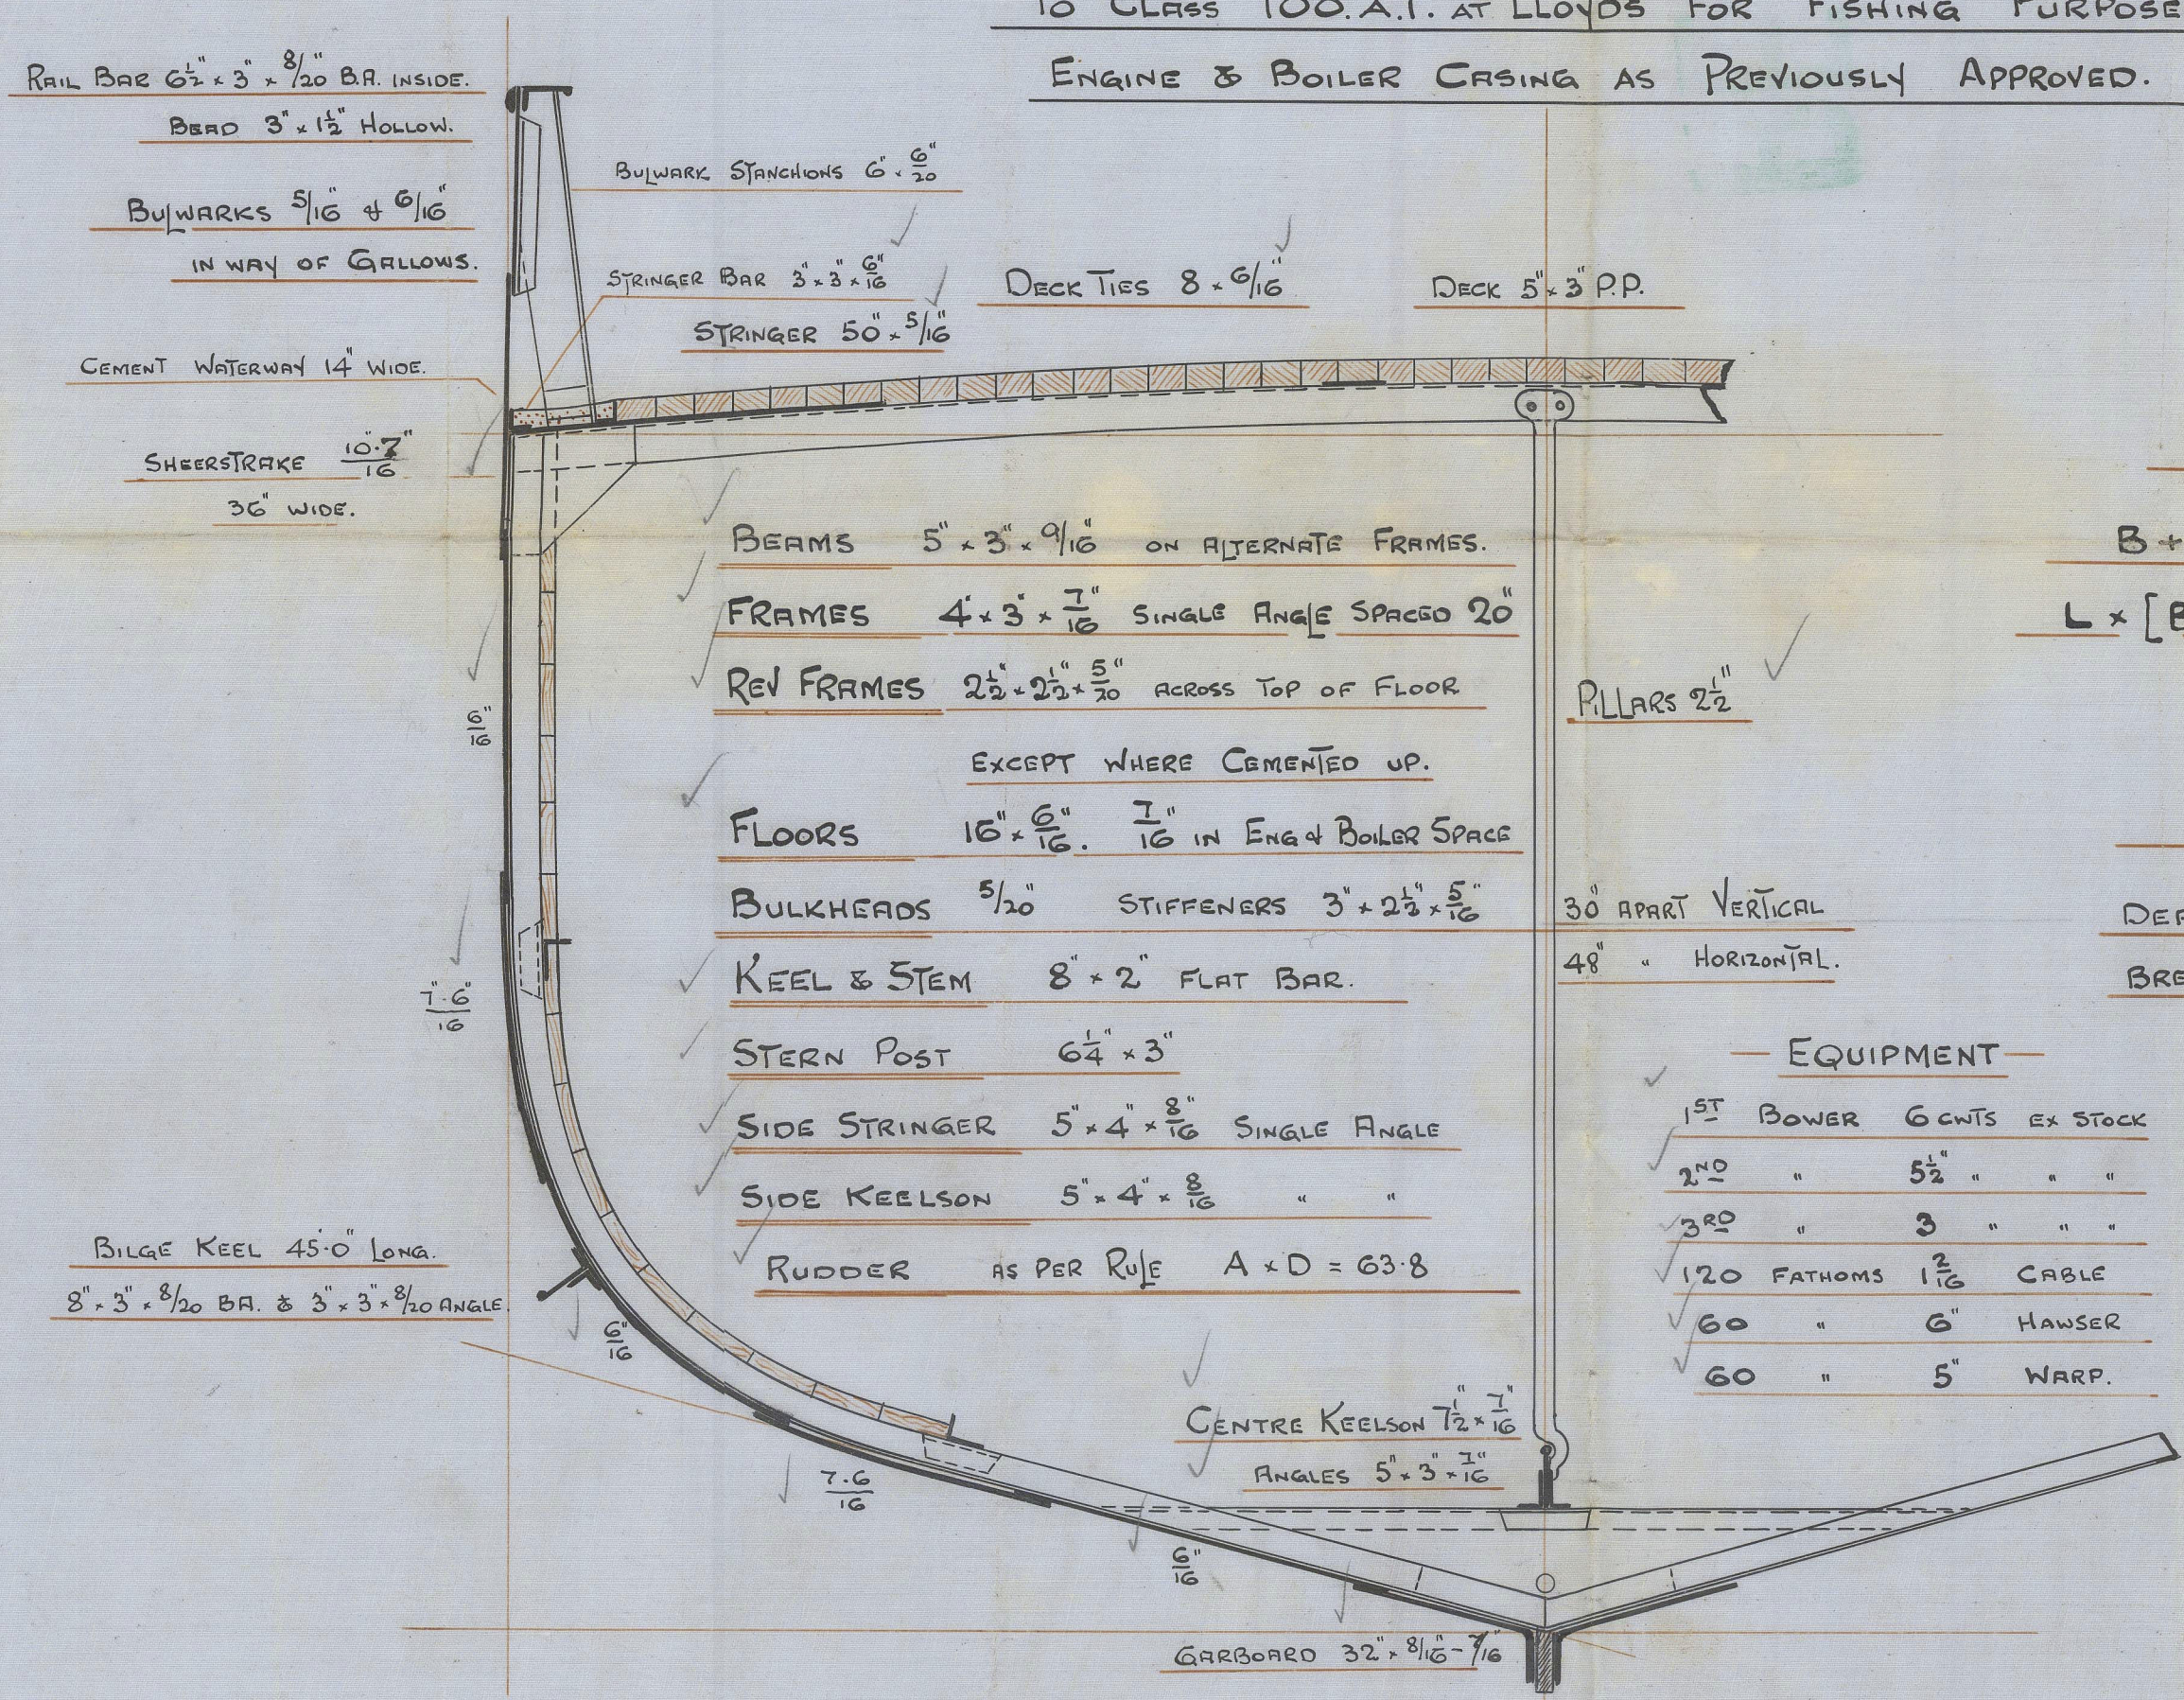

NUMERALS

B + D 35.87
L x [B + D] 4902.

PROPORTIONS

DEPTH TO LENGTH. 10.51
BREADTH TO LENGTH. 5.97

EQUIPMENT

1ST BOWER 6 CWTs EX STOCK
2ND " $5\frac{1}{2}$ " " "
3RD " 3 " " "
120 FATHOMS $1\frac{3}{8}$ CABLE
60 " 6" HAWSER
60 " 5" WARP.

RIVETING.

BUTTS OF SHELL PLATING LAPPED AND
DOUBLE RIVETED EXCEPT GARBOARD AND
SHEERSTRAKE WHICH ARE TO BE STRAPPED.
LANDINGS DOUBLE RIVETED. BULWARKS
SINGLE RIVETED. BUTTS OF STRINGER & TIES
OVERLAPPED & DOUBLE RIVETED.

7.6.11.












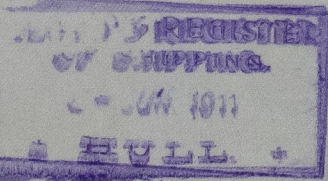

Midship Section

bolhvanis 508

1/2 Skuli Bogiti Hull Ppt No: 24526