

— OF A —
— SINGLE DECKED SCREW STEAMER. —

DIMENSIONS.

LENGTH ----- 358-0
BREADTH M^{LD} ----- 50-0
DEPTH M^{LD} ----- 24-0

CLASS 100. A. 1. —

SCALE $\frac{1}{2}$ " = ONE FOOT.

-LLOYD'S NUMERALS.

Breadth m^d ----- 50.00
Depth m^d ----- 24.00

Transverse No. 74.00
358

Longitudinal No. 26492.C

Depths to Length 14.91 Main Deck
 --- do --- 11.19 Bridge Deck

— Anchors & Cables —

Equipment No 28488-80

✓ 1st Power ex stock 42 cws, 1st stockless 52½ cws
2nd " " " 42 " " " 52½ " "
3rd " " " 35½ " " " 44½ " "
Stream " " " 14 " " "
Ridge " " " 6 " " "
✓ 20 fathoms Mud chain cable 2 1/8"
70 " " Stream chain 1 1/8" or 4 1/2" Steel wire.


— Hawsers & Warps. —

✓ 120 fathoms Towline ~~12~~ 4½ Steel Wire.
2-90 " Hawser 7"
2-90 " Warp 7"

Poop side plating .36
 -- Stringer plate 33 x .34
 -- " " Angle 3/2 x 3/2 x .34
 -- Deck plating .25 Steel, wood sheathed 5-3 P.

$\frac{7}{8}$ "le Side plating .40
 - " Stringer plate 33 x .34
 - " " Angle $\frac{3}{4}$ x $3\frac{1}{2}$ x .34
 - " Deck plating .30 Steel

Butts of Posts $\frac{7}{8}$ "le side plating ✓
 overlapped & double riveted, beams single riveted

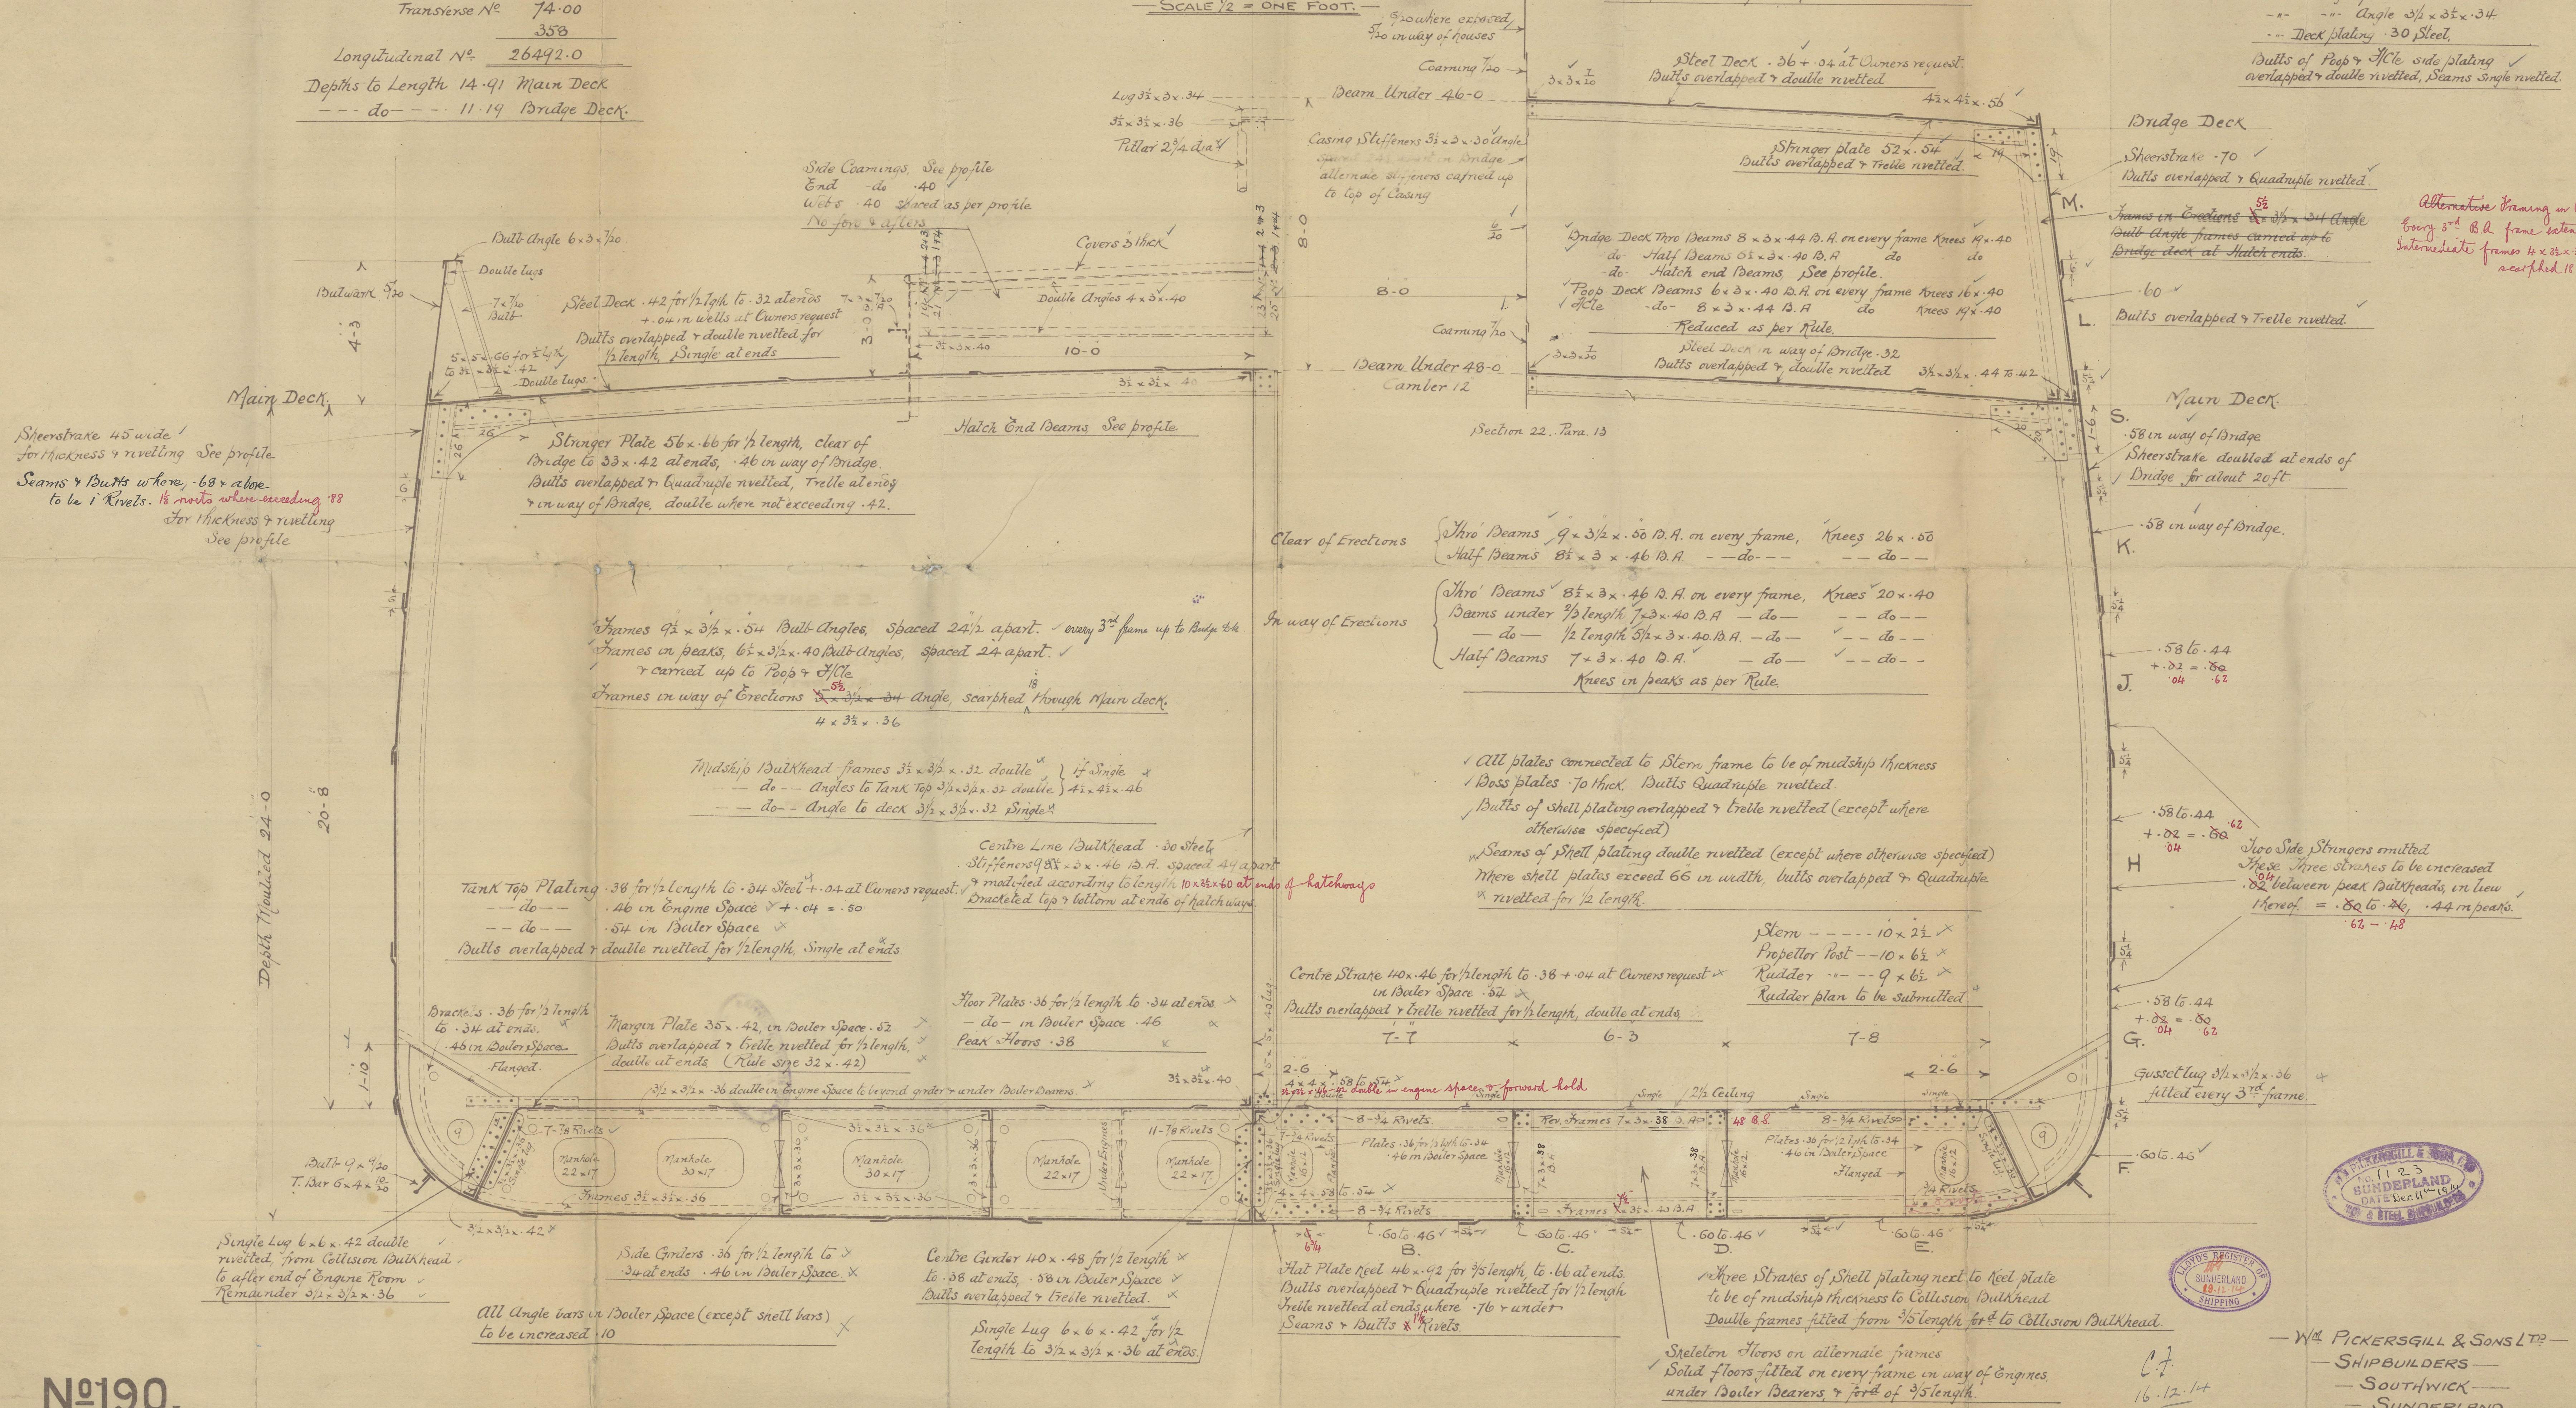

№190.

LLOYD'S REGISTER OF
SUNDERLAND
10-12-14


— W^m PICKERSGILL & SONS LTD —
— SHIPBUILDERS —
— SOUTHWICK —
— SUNDERLAND. —

S.S. SNEATON

MIDSHIP SECTION

PICKERSGILLS N^o 190

SLO RPT N^o 26575

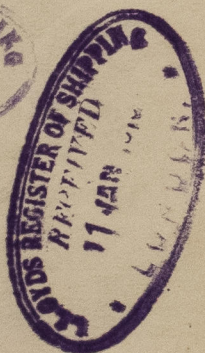

© 2021

Lloyd's Register
W753-0161
Foundation