

# STAAL DONKEY-KJEDEL.


SCALA 1"=1'-ENG. MAAL.

KONSTRUERET EFTER "NORSK" VERITAS' REGLER FOR ET ARBEIDSTRYK AF 90 LBS. PR. □"

HEDEFLADE i 6STK RØR	= 97,0 #
02 i INDRE KJEDEL	= 115,5 #
02 i SKORSTEN	= 7,0 #
SAMLET HEDEFLADE	219,5 #
RISTFLADE	= 23,5 #

Tubes = 97,0 #  
 fire box = 115,5 #  
 upstake = 7,0 #  
 Total = 219,5 #  
 Rust arm = 23,5 #

a.B.  
 27/10/15

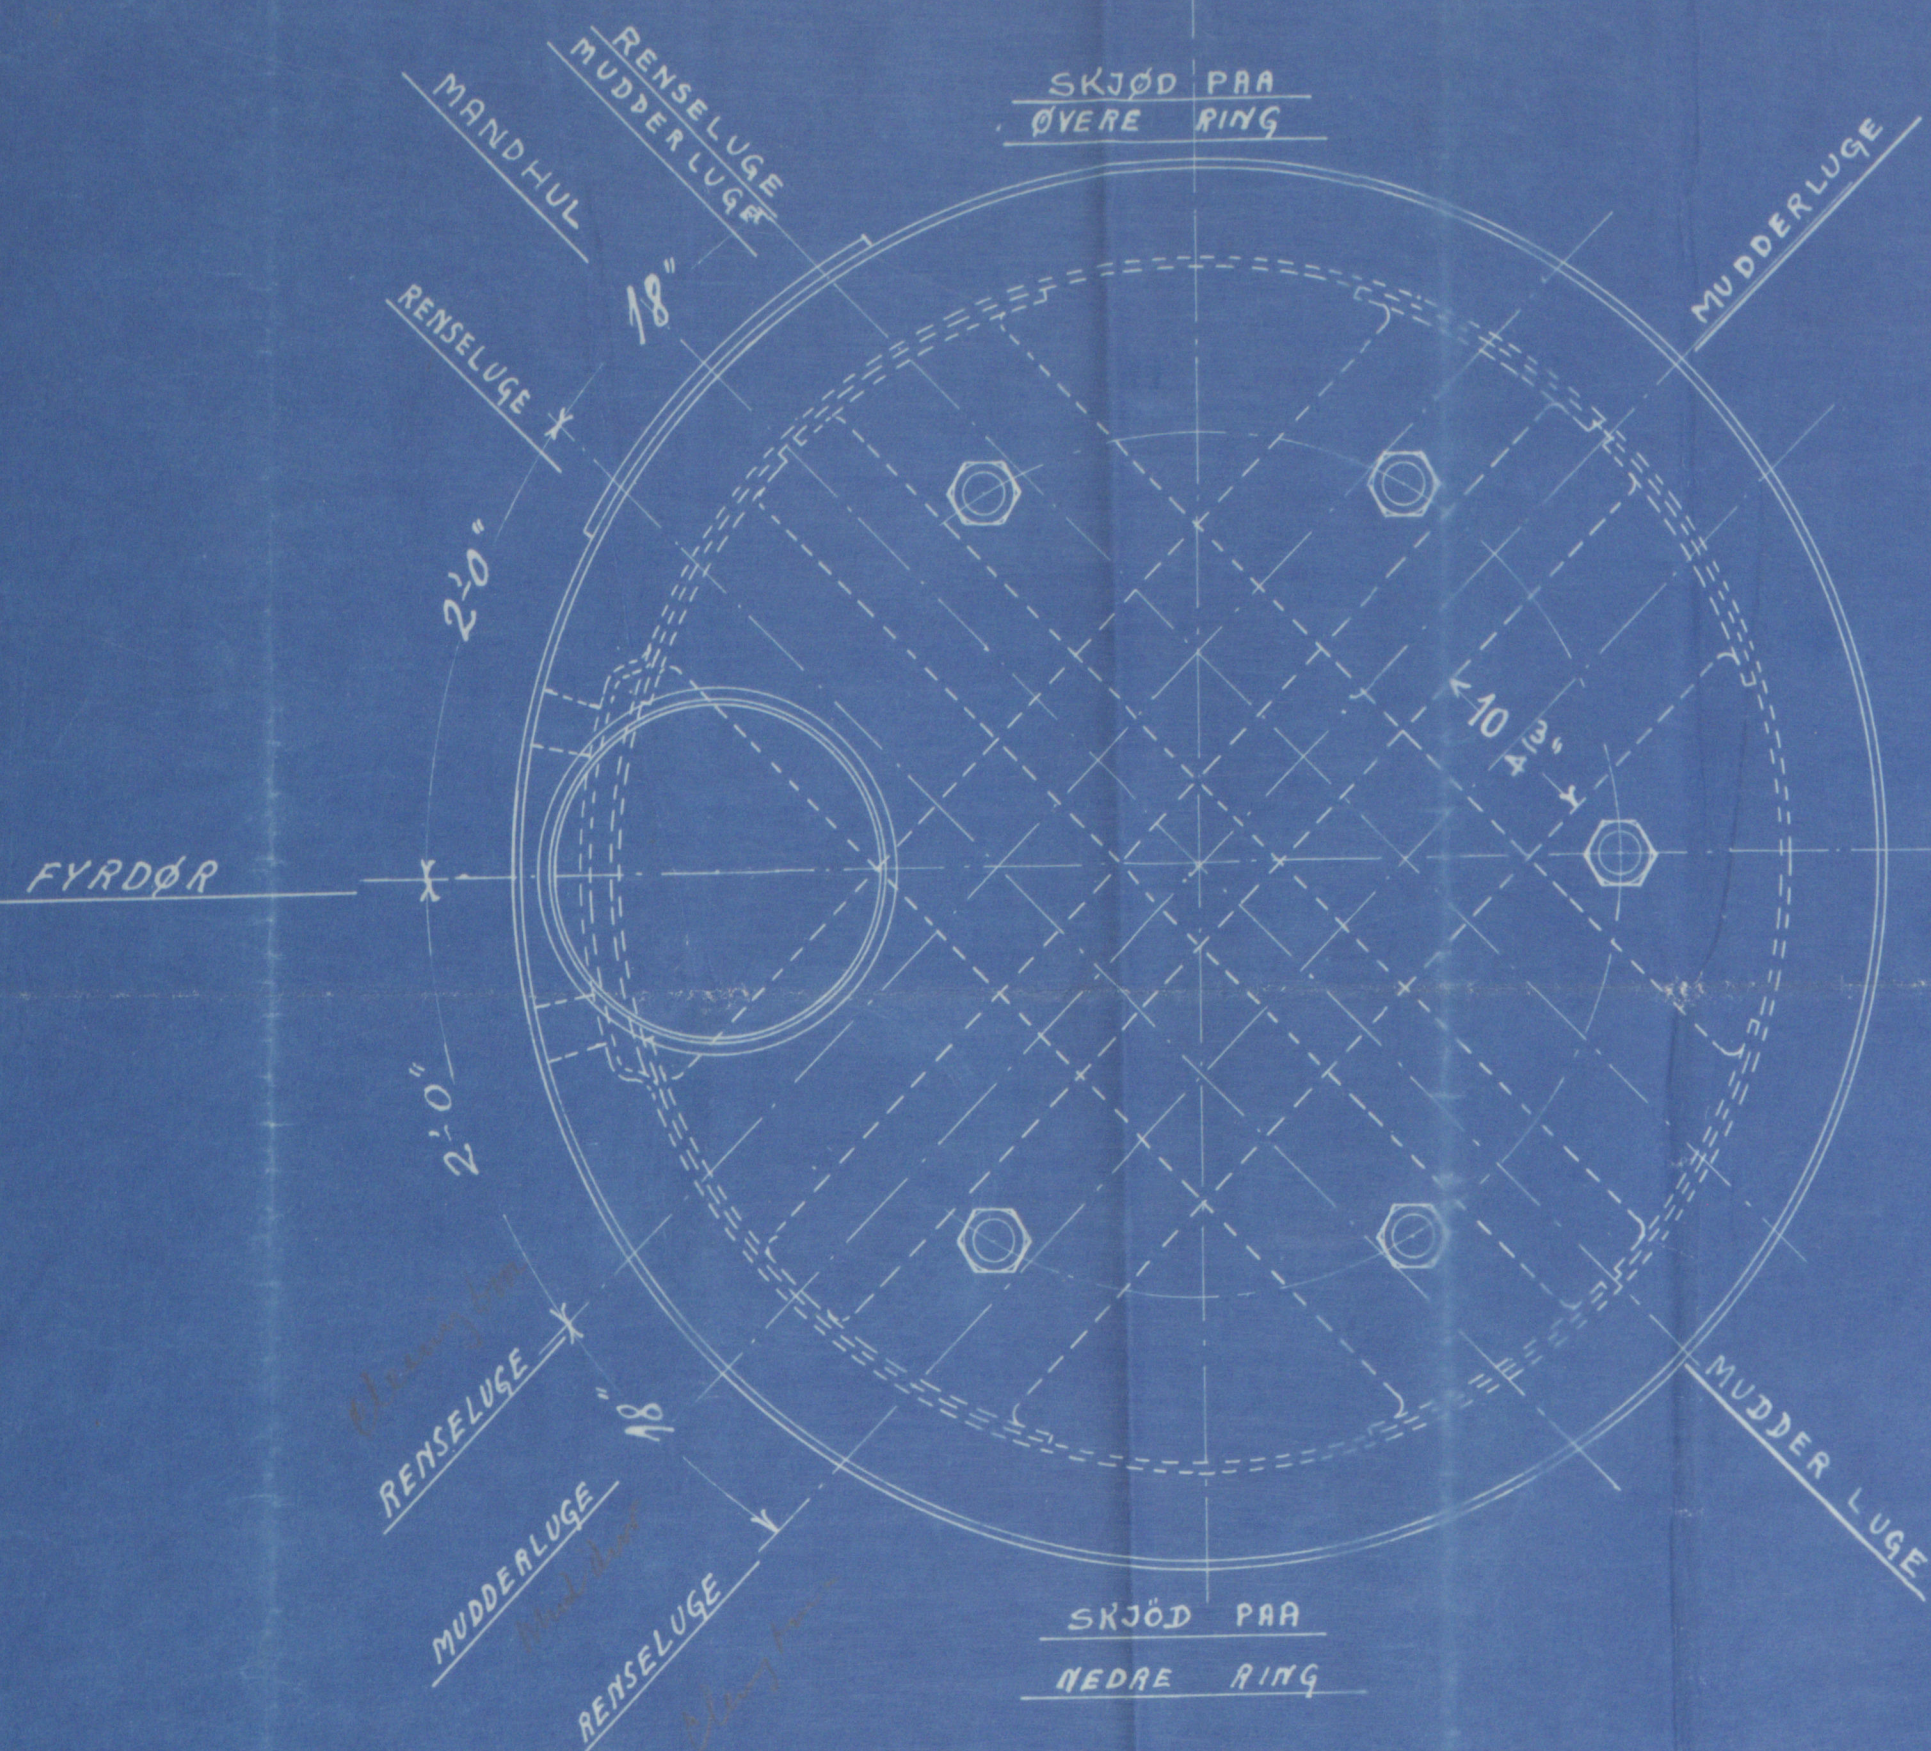

STK. 1  
 ORDRE N<sup>o</sup> 8526  
 KJEDEL N<sup>o</sup> 726  
 BAAD N<sup>o</sup> 165 - SPIRAL  
 19/1-06.









W755-0178

RETAIN

*5/5 - SPIRAL*

*Donkey Boiler*  
*original*

WEST HARTLEPOOL. *15169.*

RETAIN



*No* \_\_\_\_\_

*14 mds Test*  
*160 lbs*

*16/10/15 A.B.*

