


HORIZONTAL MULTITUBULAR STEEL BOILER 10'-0" DIAM. BY 10'-0" LONG. LLOYDS SURVEY 100 LBS. W.P.



FOR MESSRS RICHARDSON DUCK & CO STOCKTON-ON-TEES. S.S. NO 588.

SCALE 1" = 1 FOOT.

-3867-

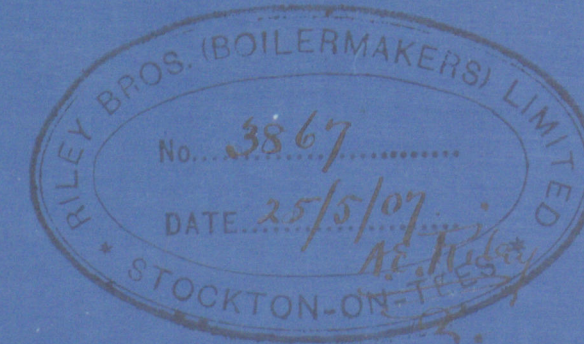

28/5/07

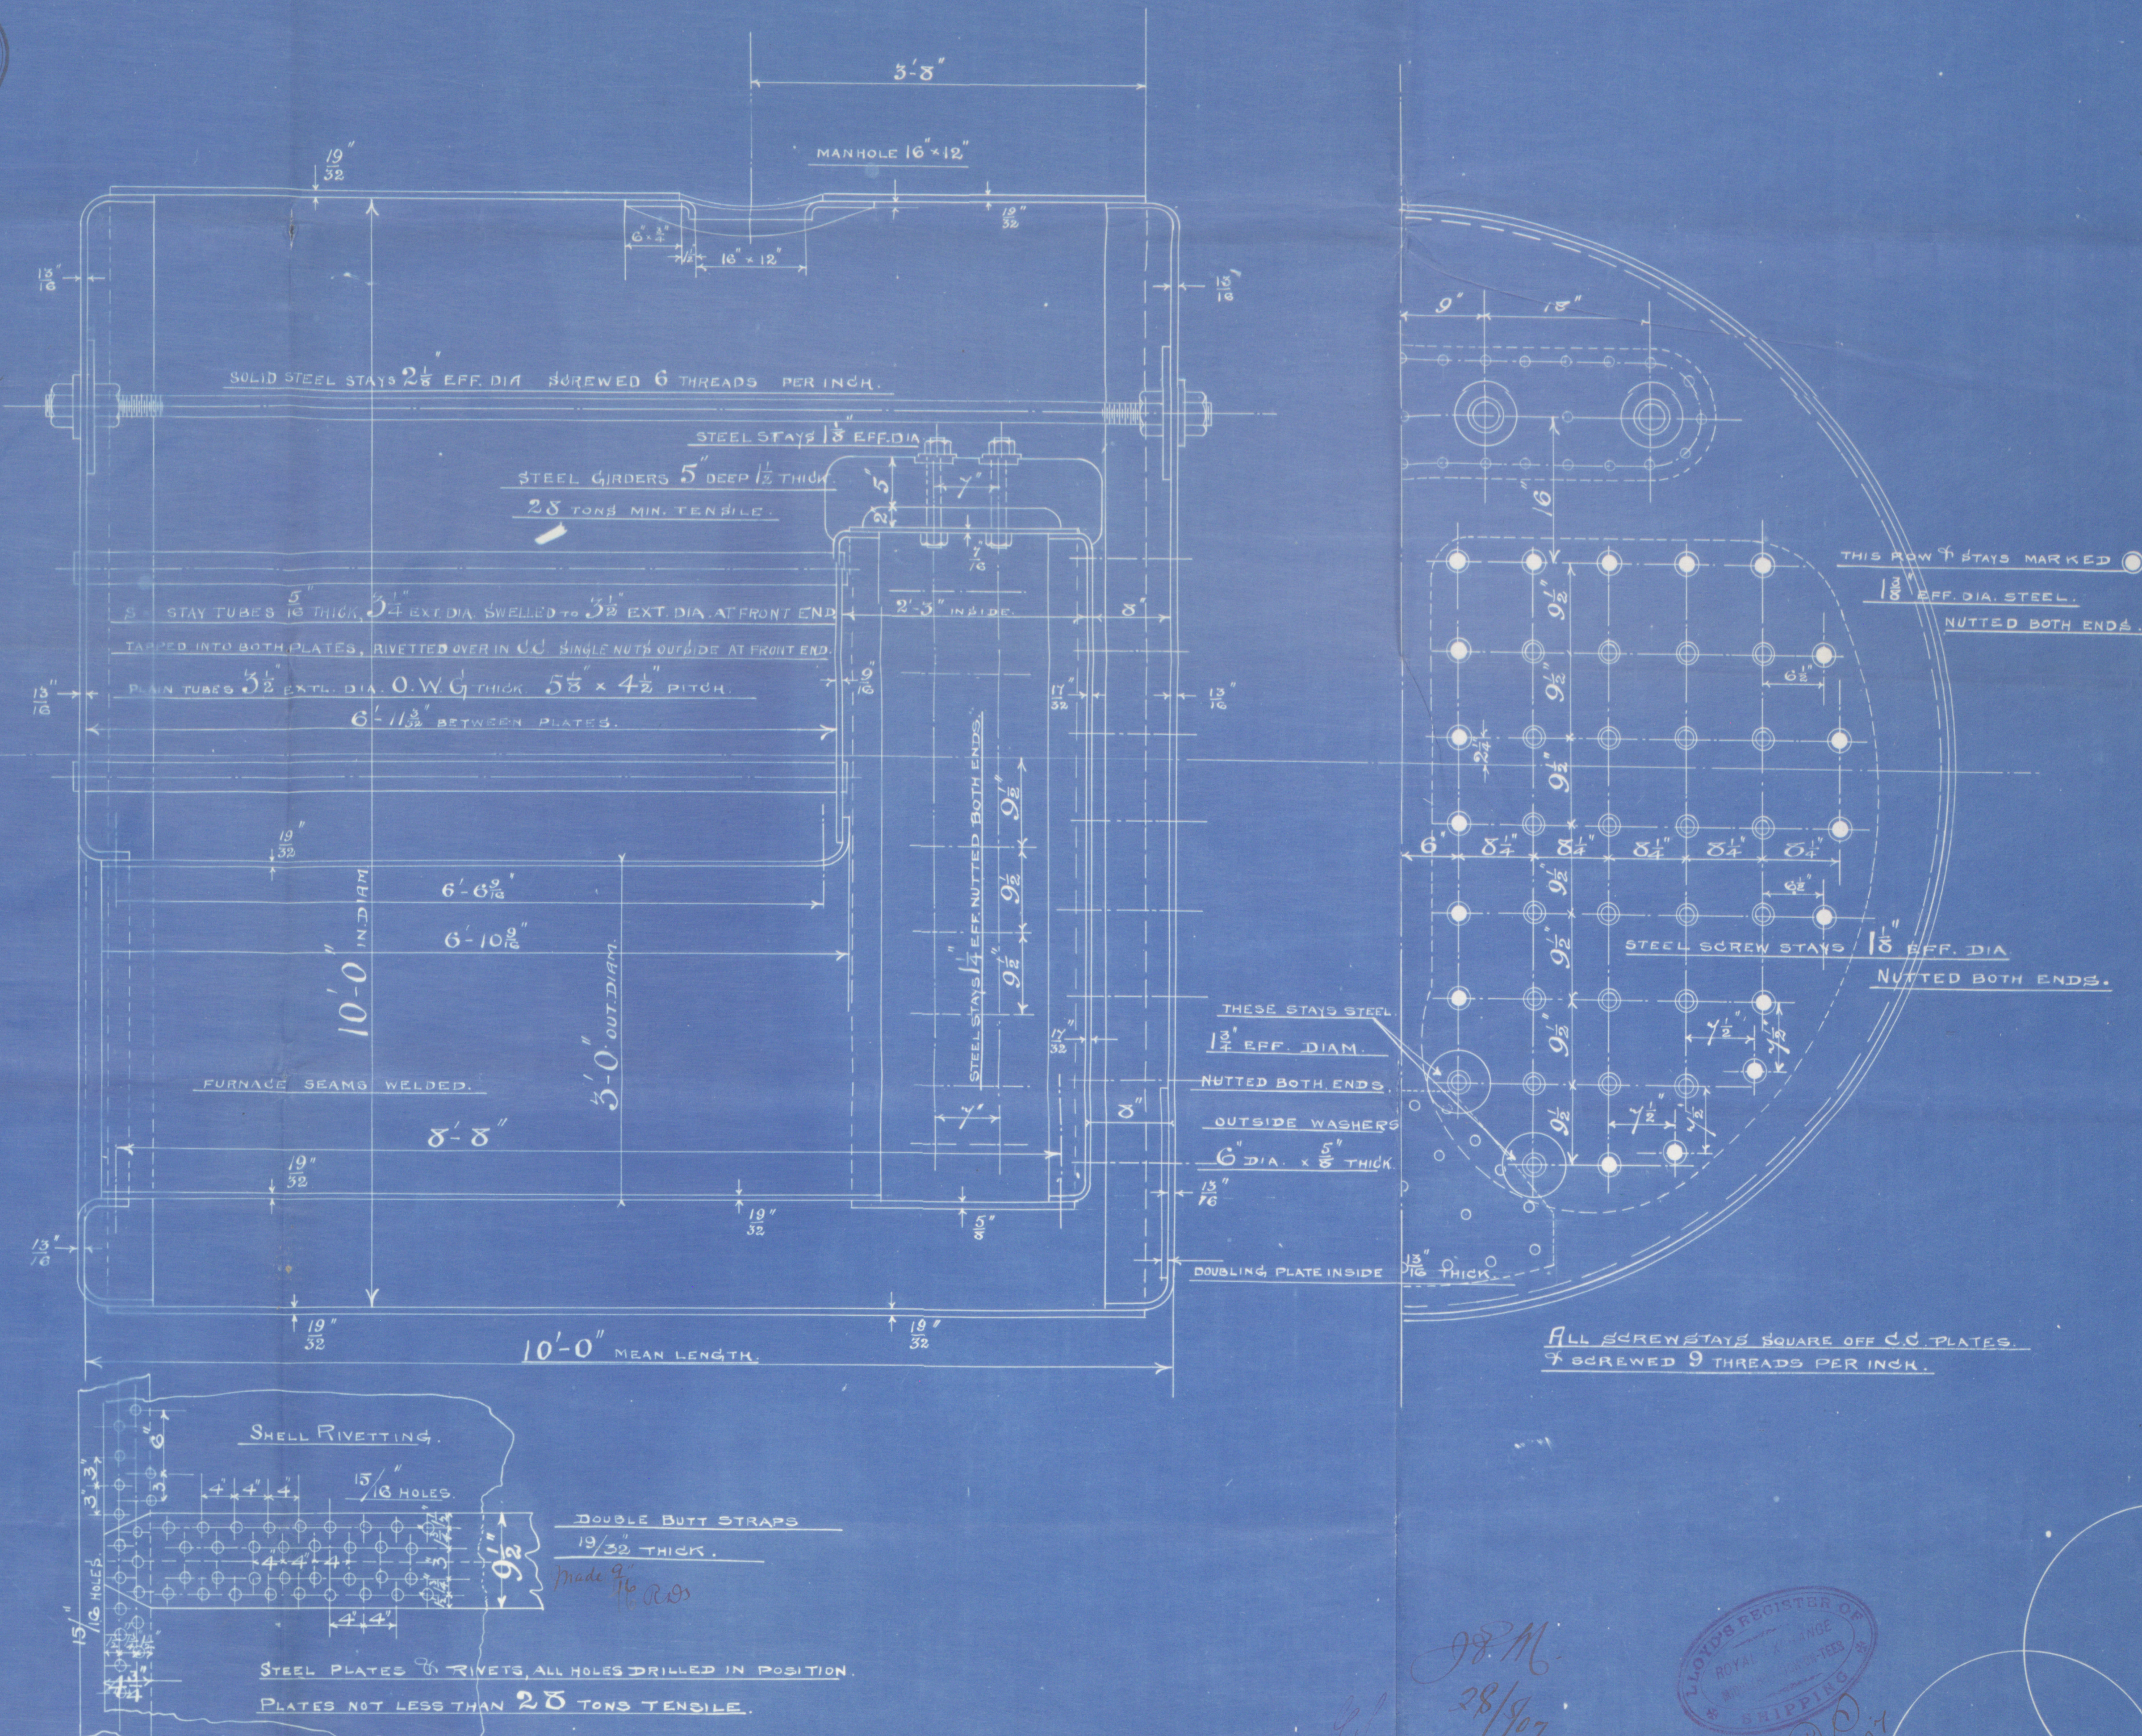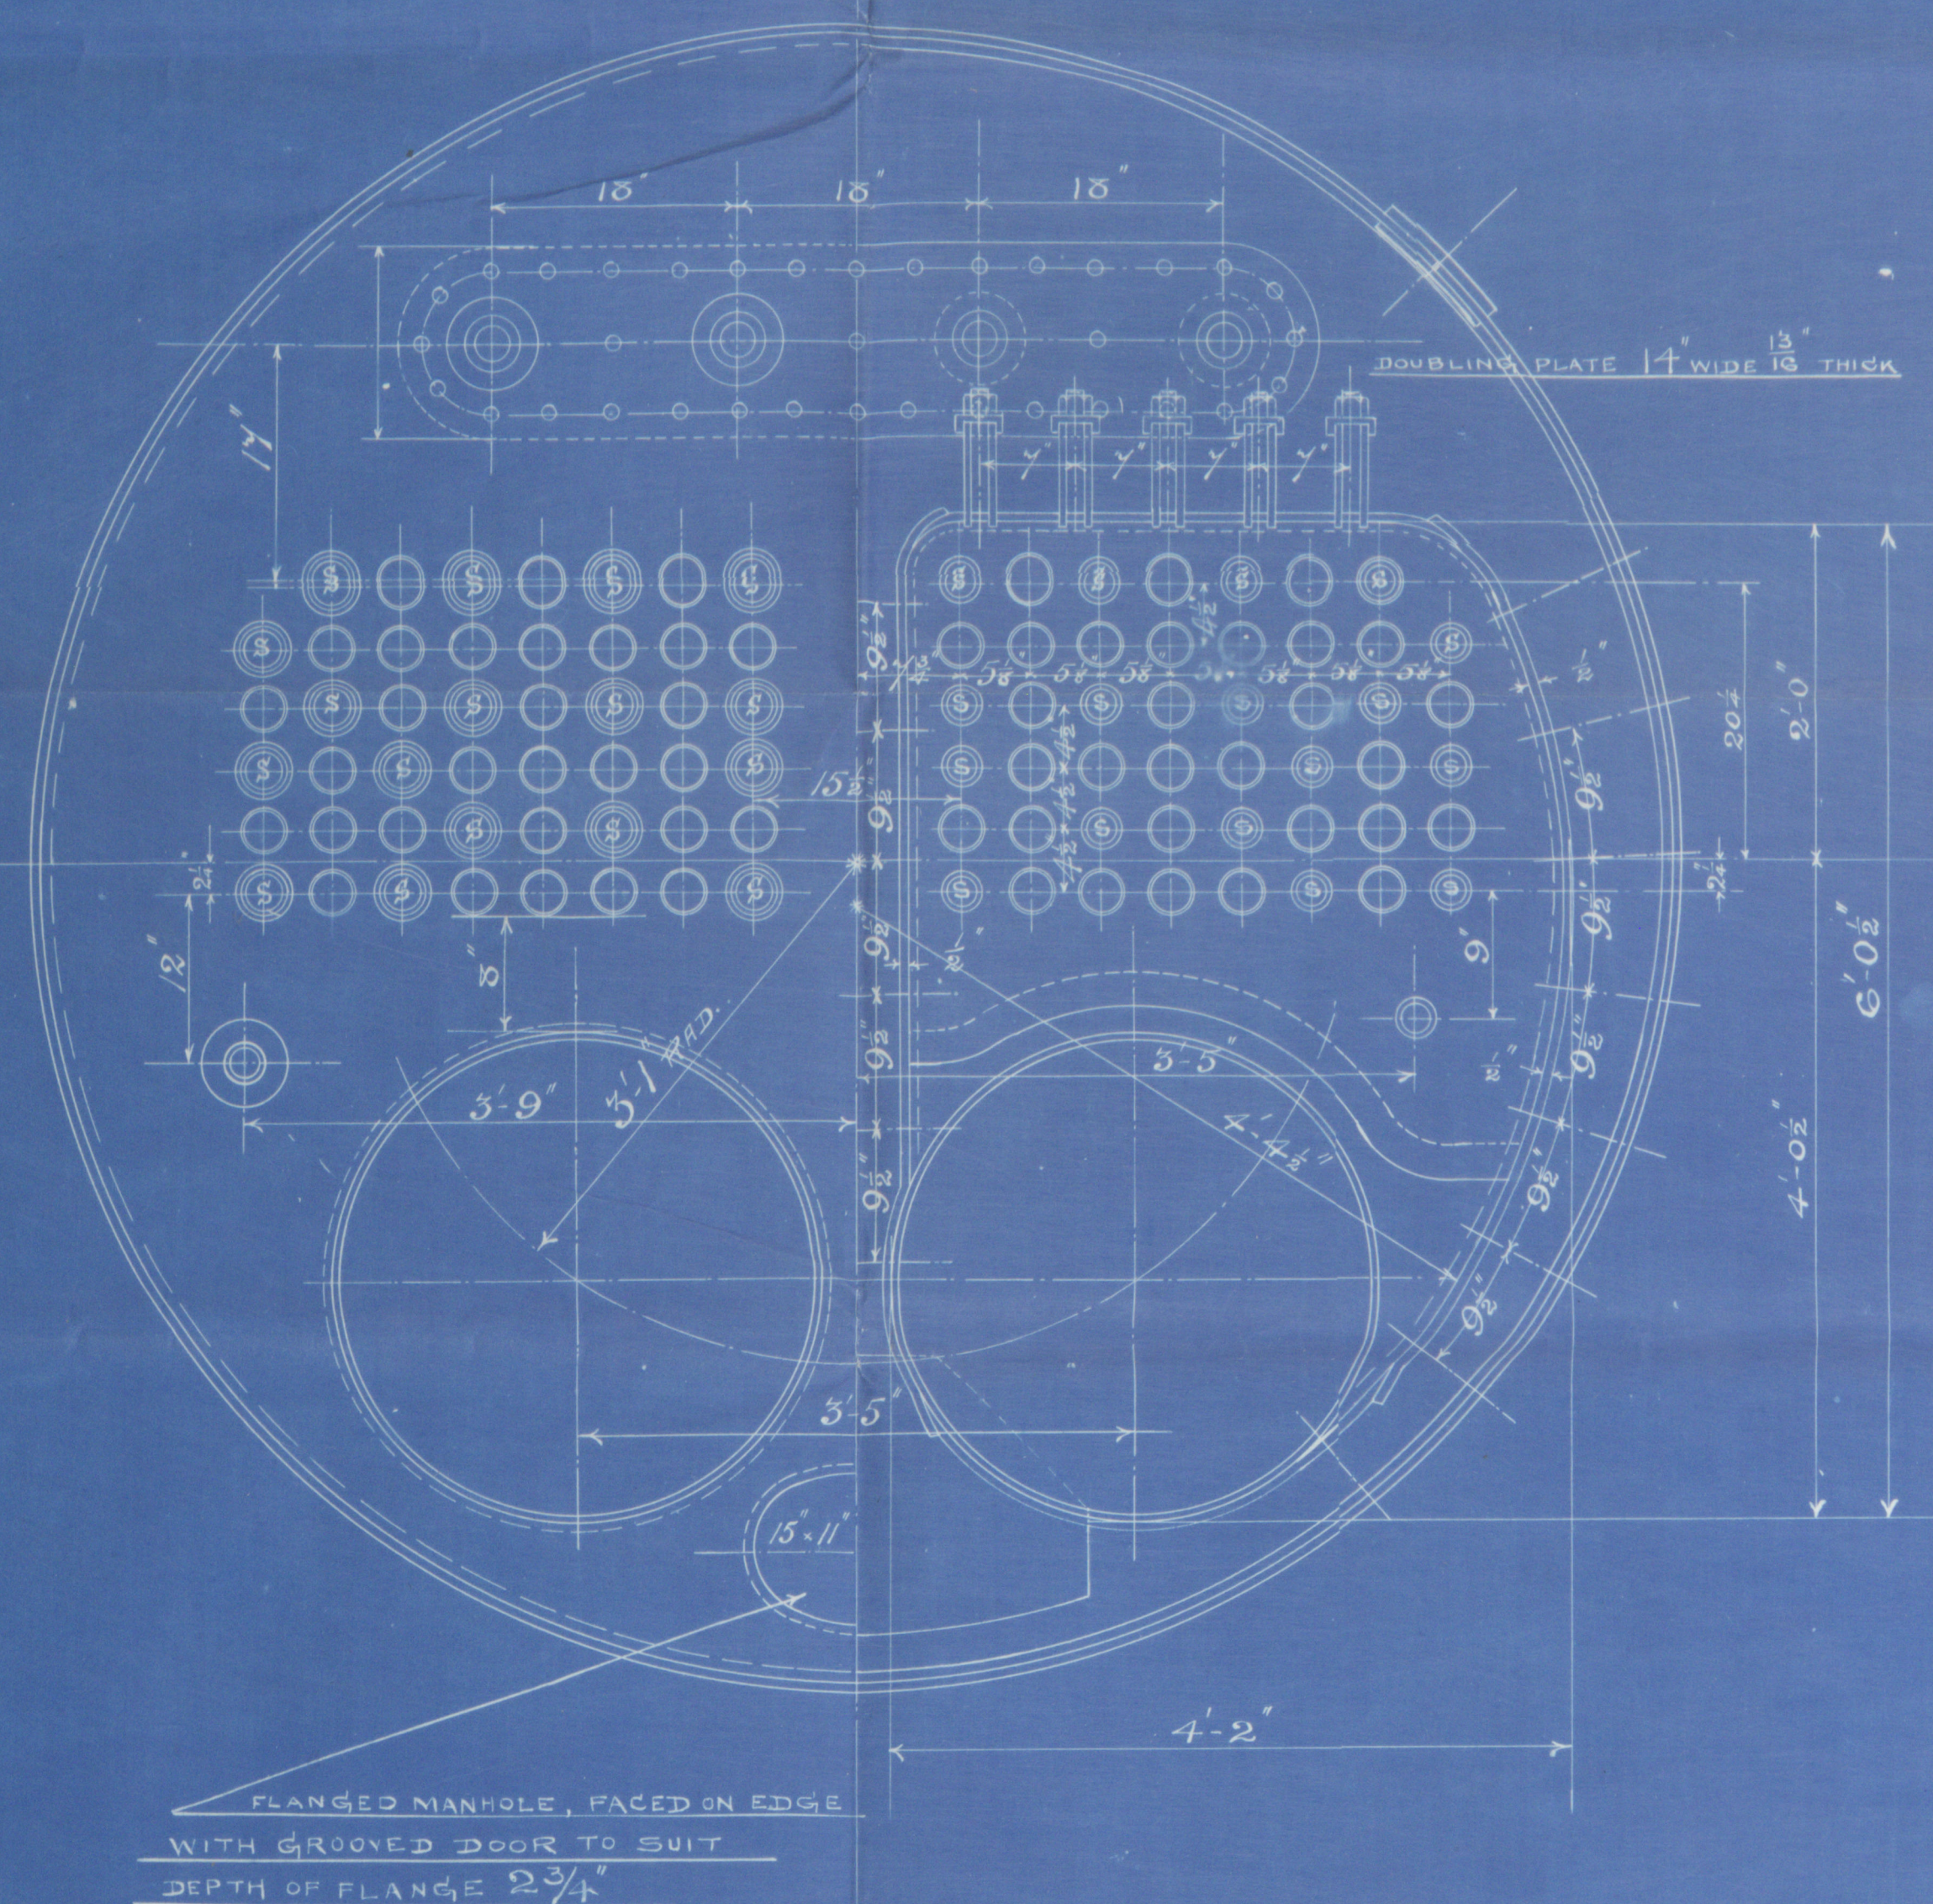

28/5/07

27-5-07





Donkey Boiler  
No 3867

Riley Bros Ltd



Richardson Duck  
& Co

S S No 588

1/2 Snowdonian

Prob report No. 5257

No.	3985
LLOYD'S TEST	
200 lbs.	
2-8-04 R.D.S.	

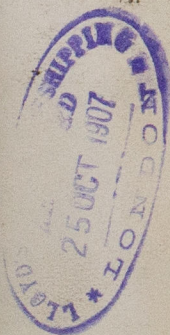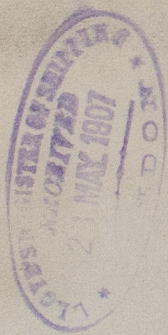

Lloyd's Engineers Surveyors



© 2020

Lloyd's Register  
Foundation

W755-0214