





STEEL BOILER 9'-6" DIA 9'-0" LONG 90 LBS W.P.

LLOYDS

4465

1/5/12

RILEY BROS. (BOILERMAKERS) LTD.
STOCKTON ON TEES.

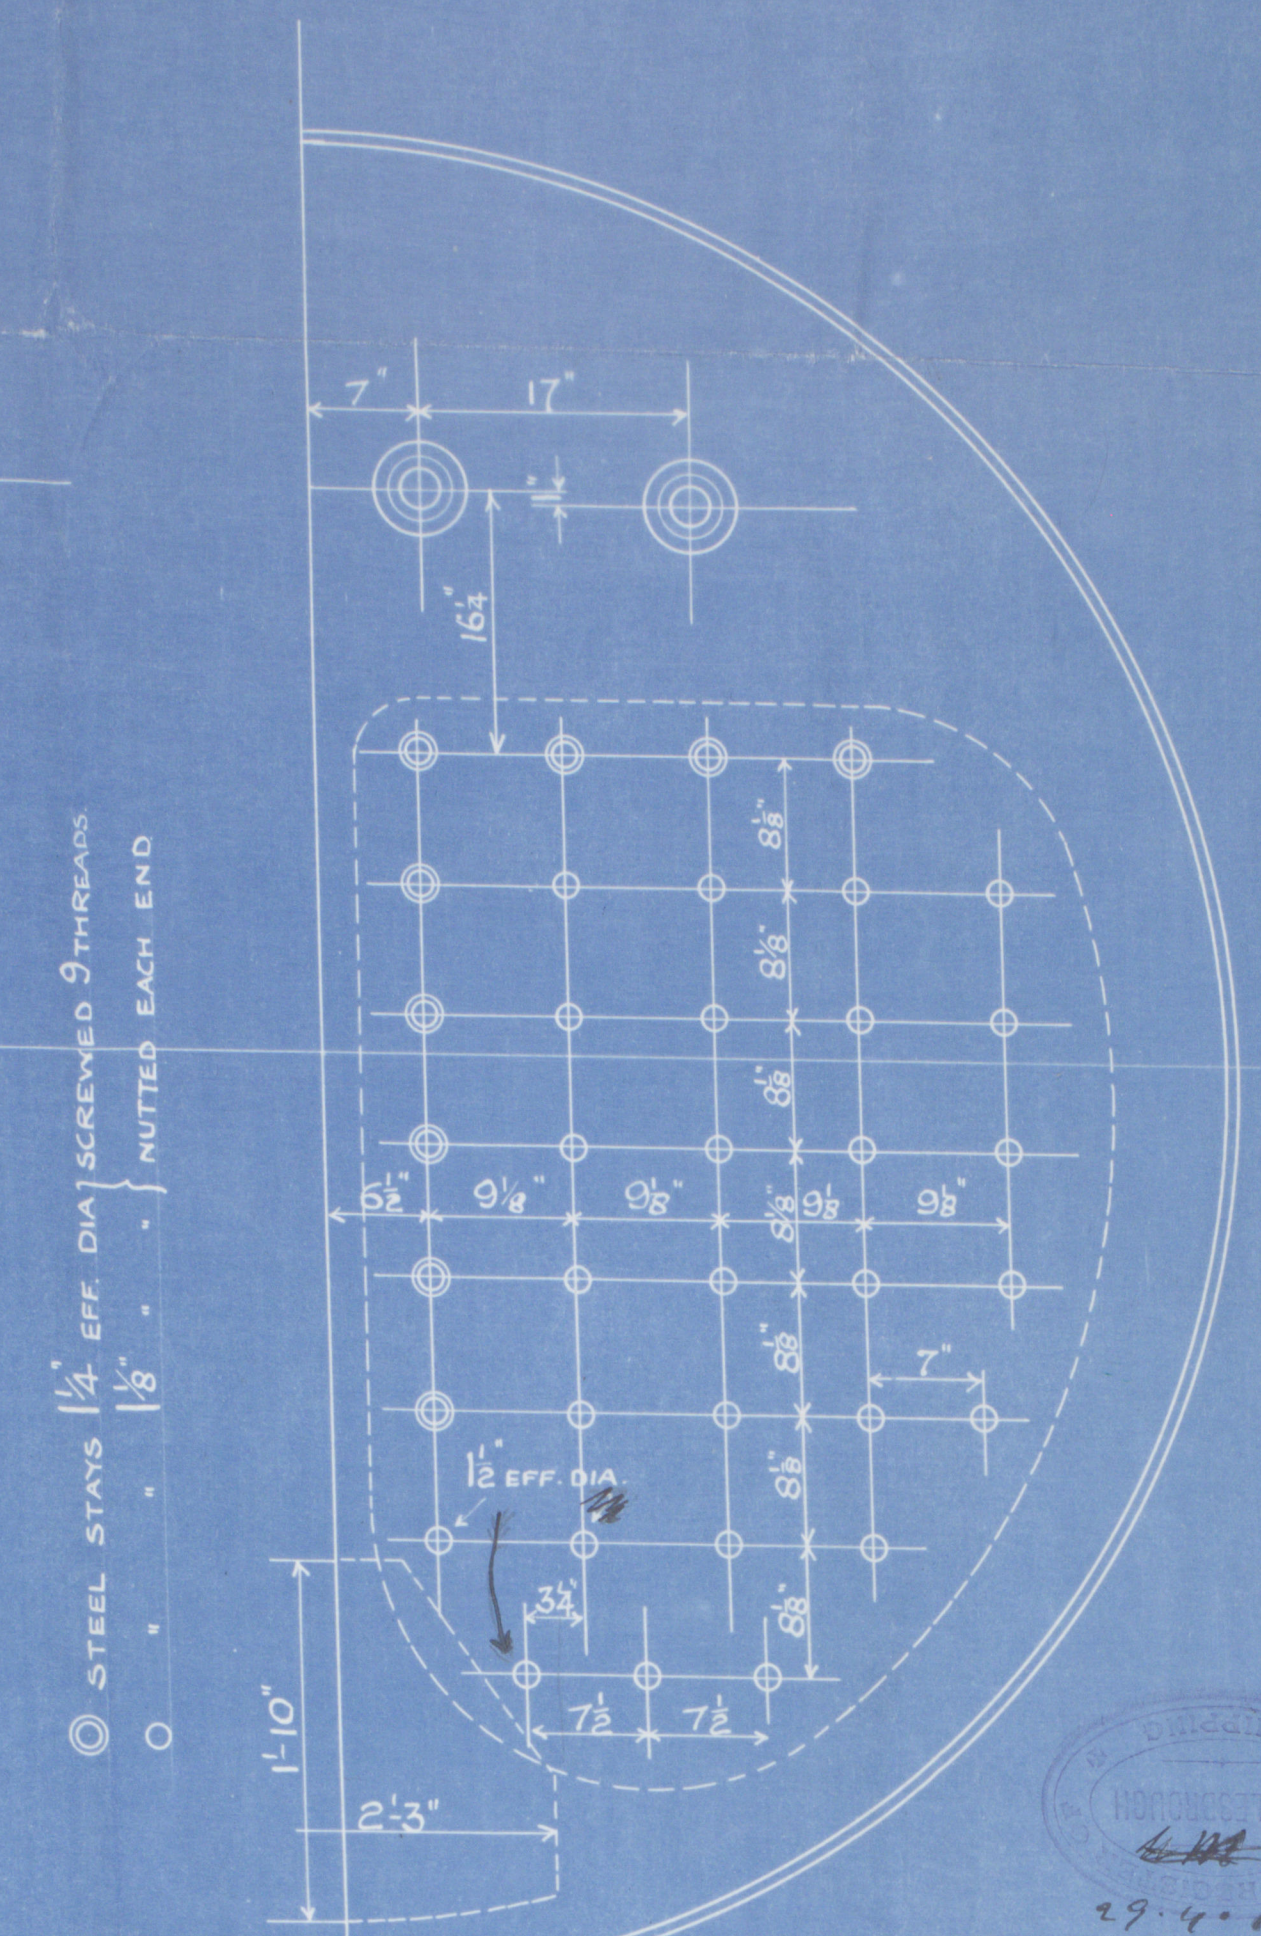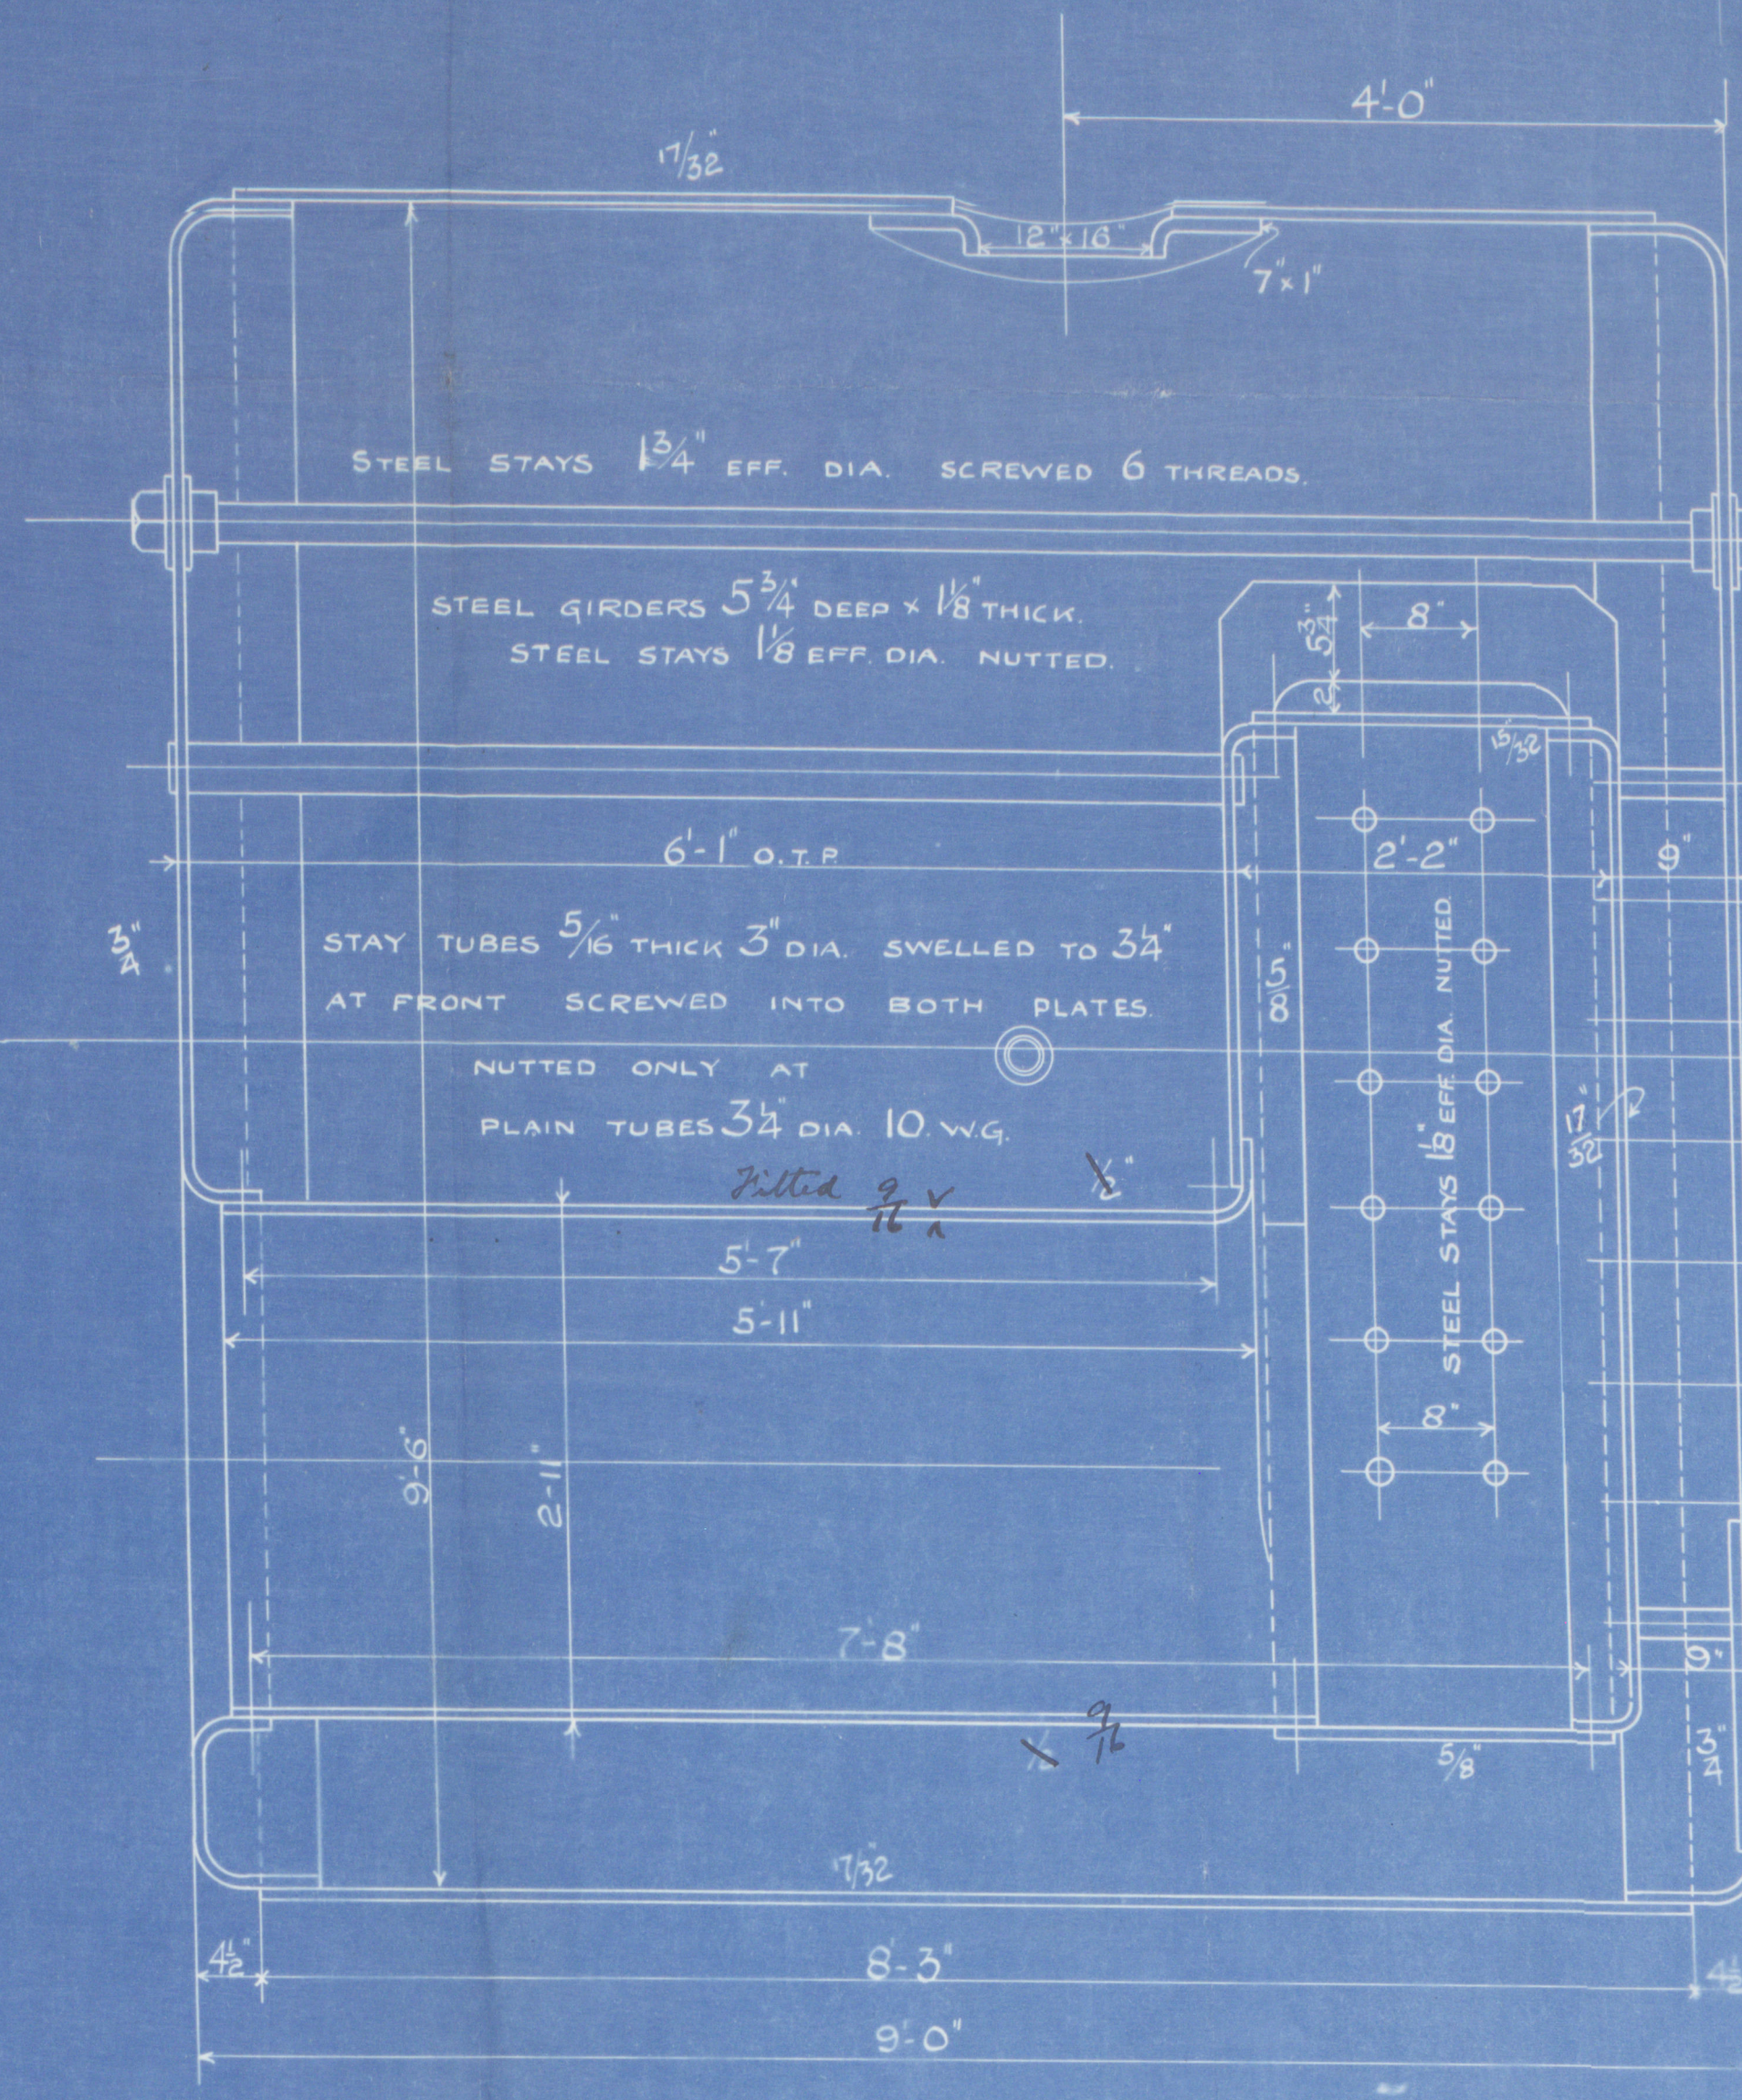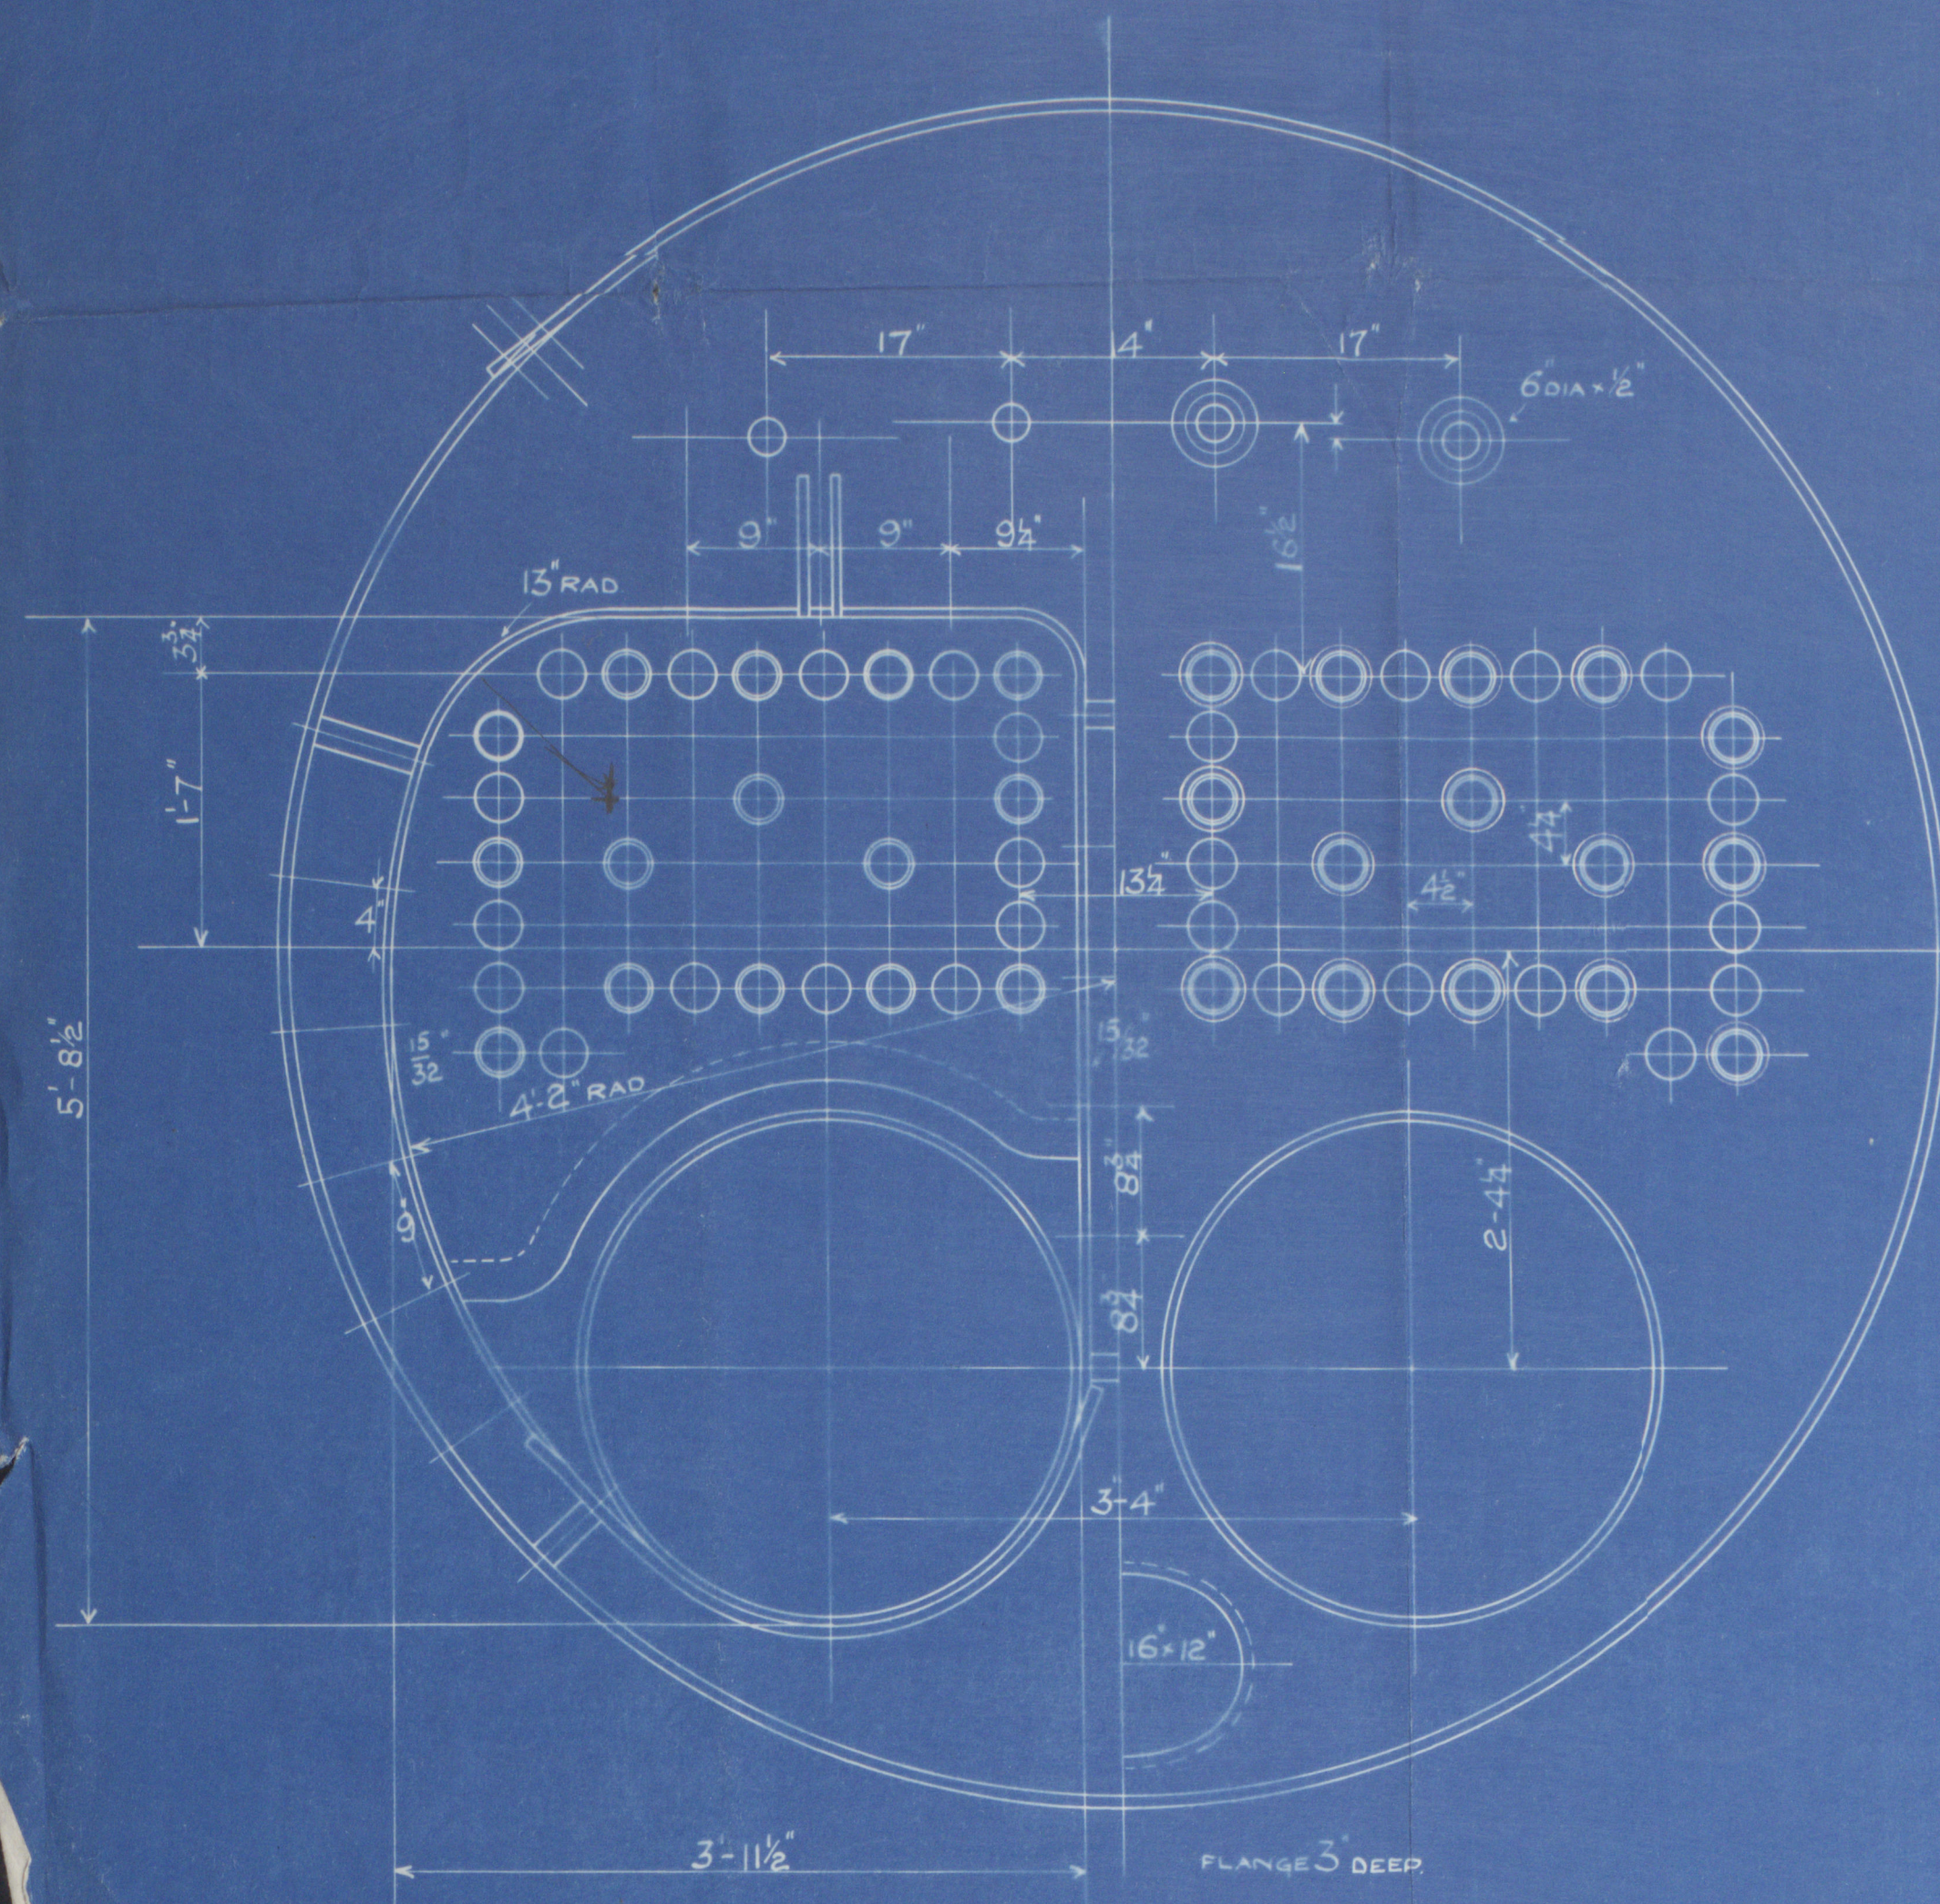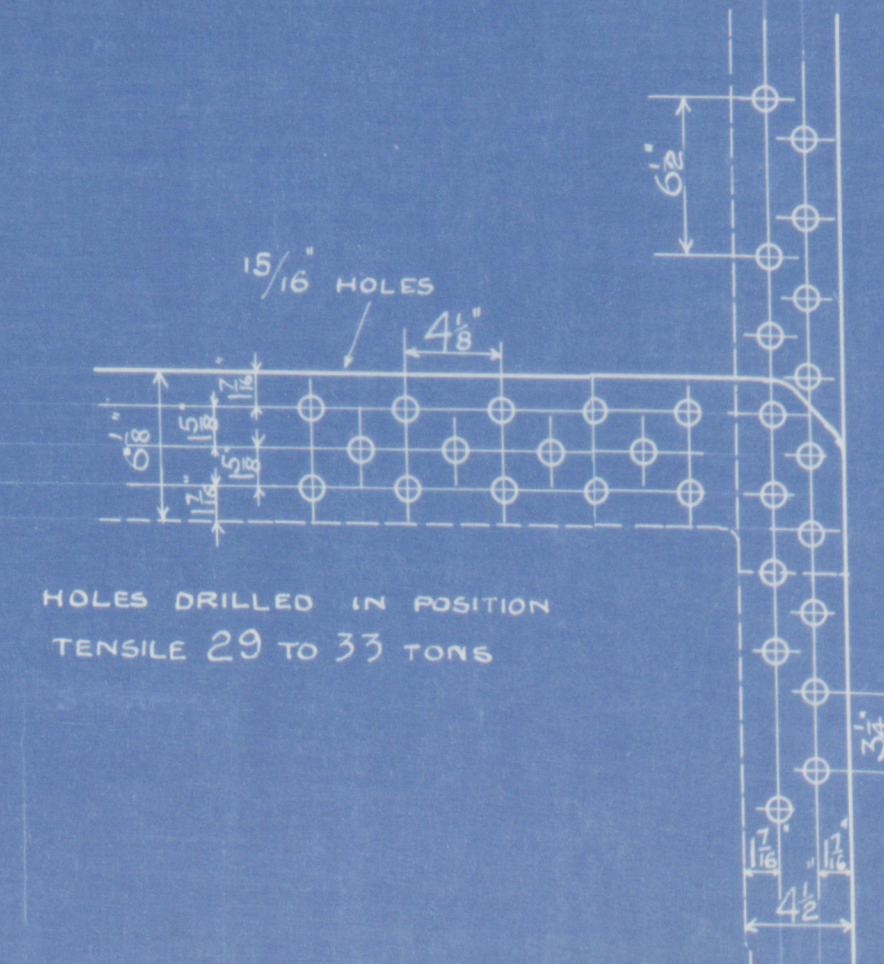

© STEEL STAYS 1/4" EFF. DIA. SCREWED 9 THREADS.
NUTTED EACH END


APR 1/5/12

H.S. 750 SQ. FT.

G.A. 28.4 SQ. FT. (5-0 BAR)




© 2020

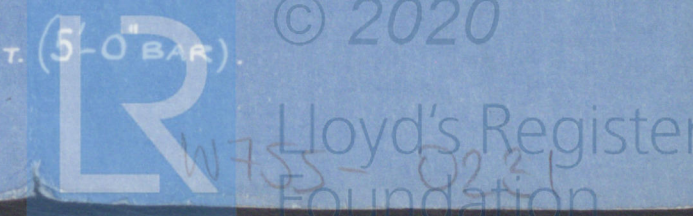


Messrs Riley Bros Ltd
Boiler 4465
for

Messrs R. Thompson & Sons Ltd
S. P. No. 277
Working Press 90 lbs.

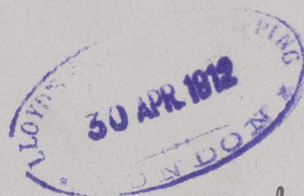

No.	4962
LLOYD'S TEST	
180	lbs.
16.10.12 - NM	

Heat Report
7/18

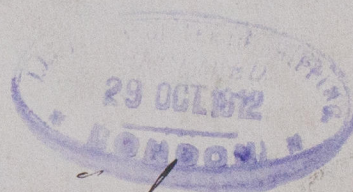

Cocoa

Std. Rpt. No. 25560



© 2020

Lloyd's Register
W755-0231
Foundation