


ROBERT THOMPSON & SONS, LTD
IRON AND STEEL SHIPBUILDERS AND
REPAIRERS,
SOUTHWICK YARD
SUNDERLAND.

26.4.12
3.9.12

BEAM ARRANGEMENT

S.S. N° 277

SCALE 1/8" = 1 FOOT

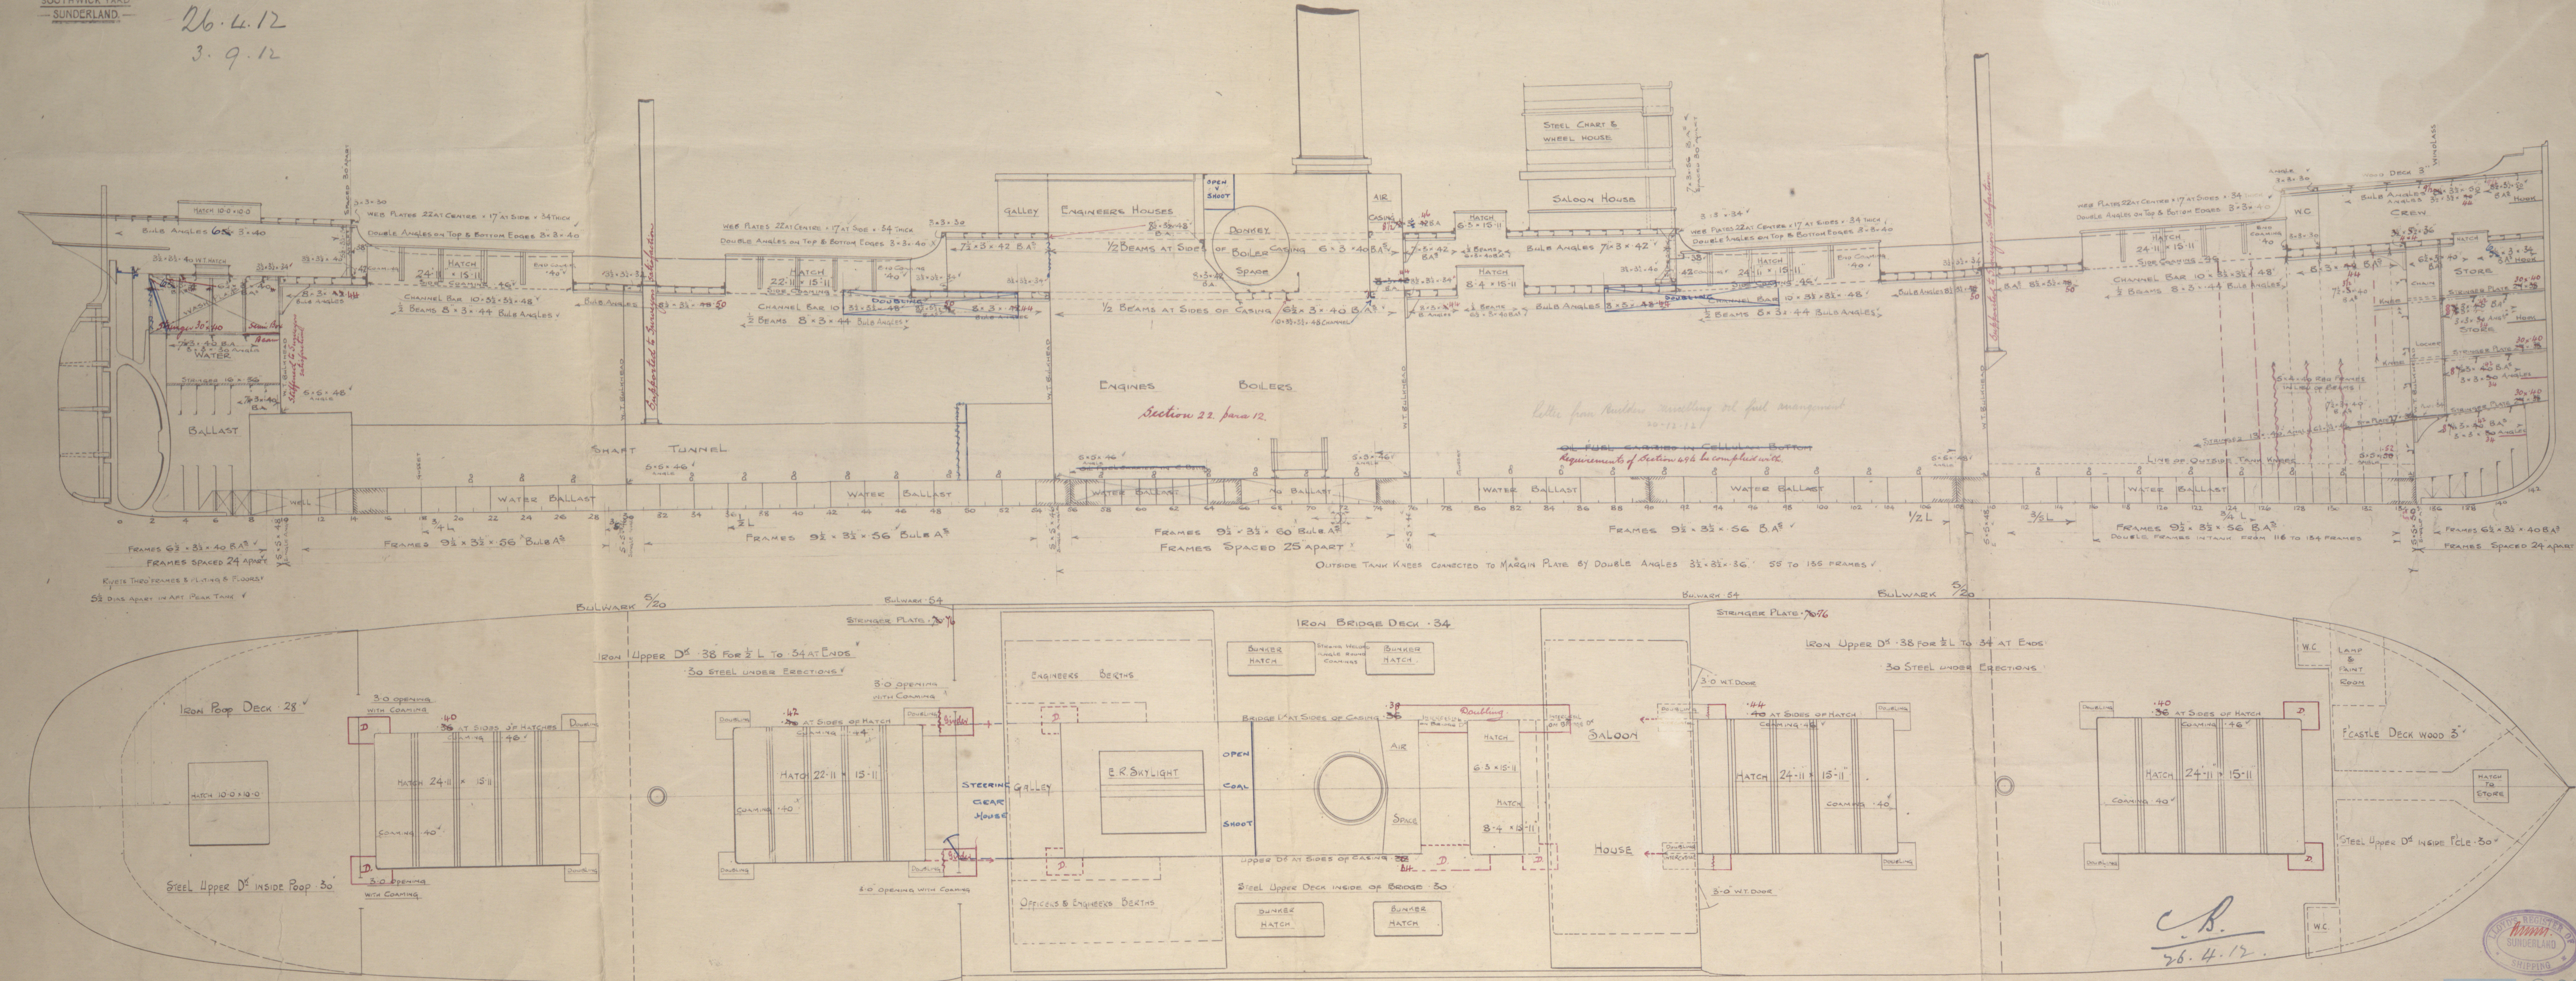

© 2020
Lloyd's Register
W755 Foundation

"SOCCOA"

Sld. Rpt. No 25560

Profile &
Deck Plan

No. 277

R. Thompson
& Sons Ltd



© 2020

Lloyd's Register
Foundation