

18.3.13

PLAN No. 3422
FOR ENCLOSURE TO
Lloyd's Register
Hull FROM
COCHRANE & SONS, LTD.
SHIPBUILDERS, SELBY.
DATE 26/2/13 *PSW*

MIDSHIP SECTION


STEEL SCREW FLEETERS

N^{os} 562

DIMS 112'-0" B.P. x 22'-6" M.L.D. x 13'-2" M.L.D.

SCALE $\frac{1}{2}$ INCH

TO CLASS 100AL FOR FISHING PURPOSES DECK PLATED OVER
IN WAY OF MACHINERY SPACE. ENGINE & BOILER CASING AS
PREVIOUSLY APPROVED

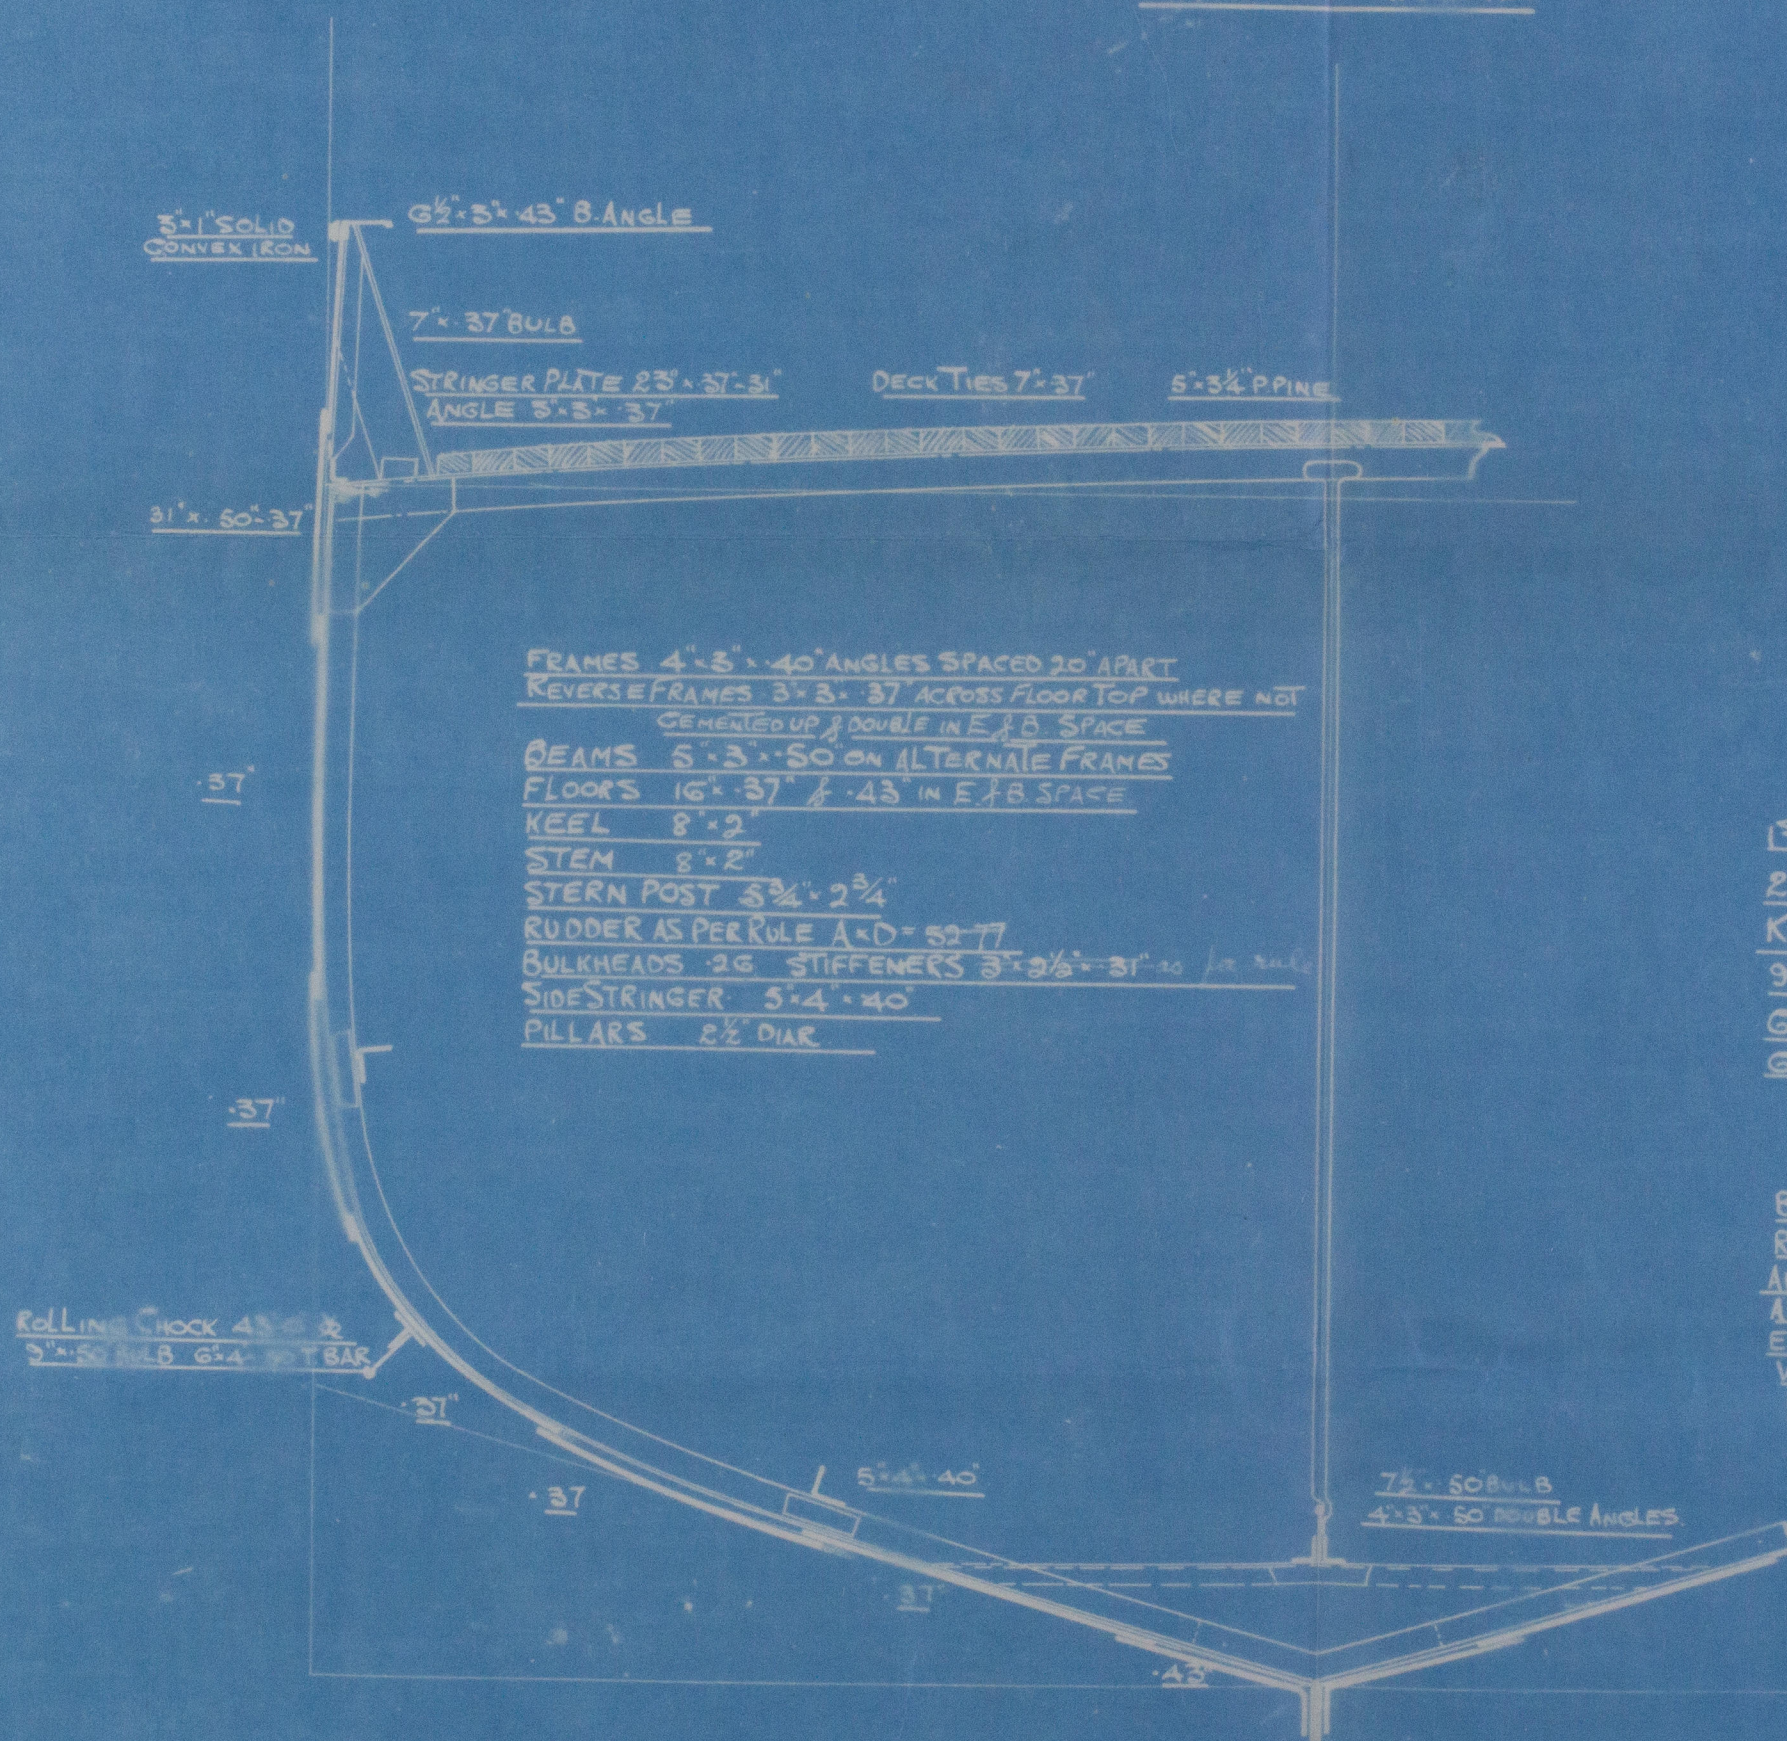

NUMERALS

B+D = 35.53
L x (B+D) = 3979.36

PROPORTIONS

H/D = 8.51
B/L = 5.006

EQUIPMENT

1st BOWER ANCHOR 5 CWTs EX STOCK
2nd " " 4 1/2 " " "
KEDGE " 2 1/2 " "
90 FATHOMS 1" CHAIN
GO " 5 1/2" HAWSER
GO " 4" WARP

RIVETING

BUTTS OF SHELL PLATING TO BE LAPPED & DOUBLE
RIVETED EXCEPT GARBOARD & SHEERSTAKE WHICH
ARE TO BE STRAPPED & DOUBLE RIVETED
ALL SINGLE RIVETED LANDINGS EXCEPT LOWER
EDGE OF SHEERSTAKE & TOP EDGE OF GARBOARD
WHICH ARE DOUBLE RIVETED
BULWARKS SINGLE RIVETED

(signed)

Jul
17.3.13



© 2021

Lloyd's Register
Foundation

WT56-0044

Cochran & Sons.
Nos 561. 562. 587. 588.

Duplicate.

Midship Section

1/2 Bridlington Hull Report No. 26774

" Speeton " " 26818.

RETAIN

RETAIN



© 2021

Lloyd's Register
Foundation

W756-0044