



21.12.04

—N° 495—

—PROFILE & DECK PLAN—



—108' 4" B.P. 22' 6" EX. 11' 6" HOLD—

—1" = 1 FT.—

—TO CLASS 100 R.L. FOR FISHING PURPOSES—



—SEE SECTION FOR SCANTLING S.—

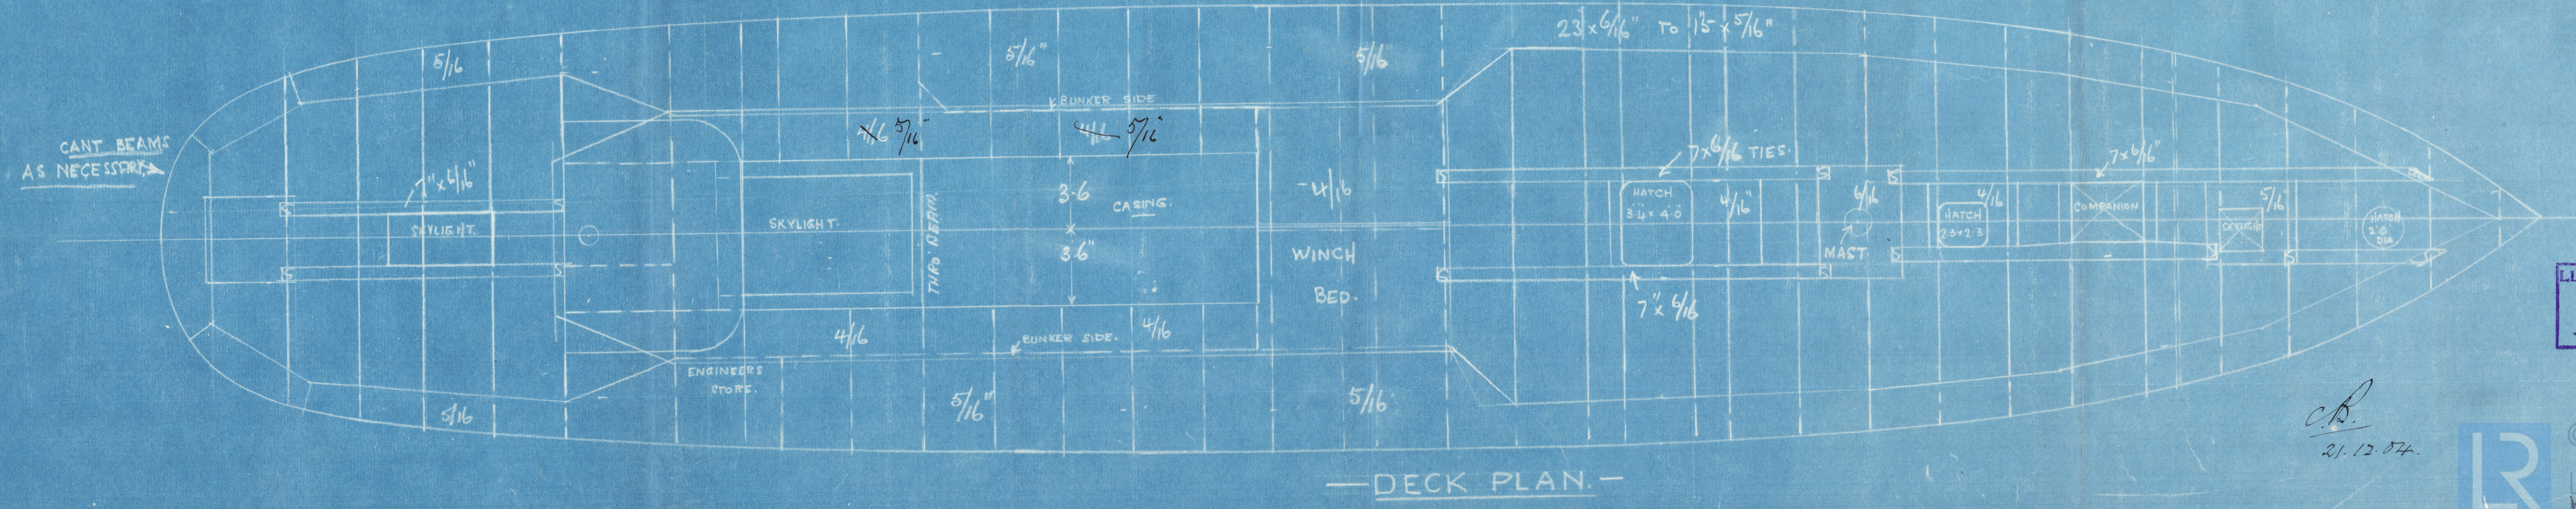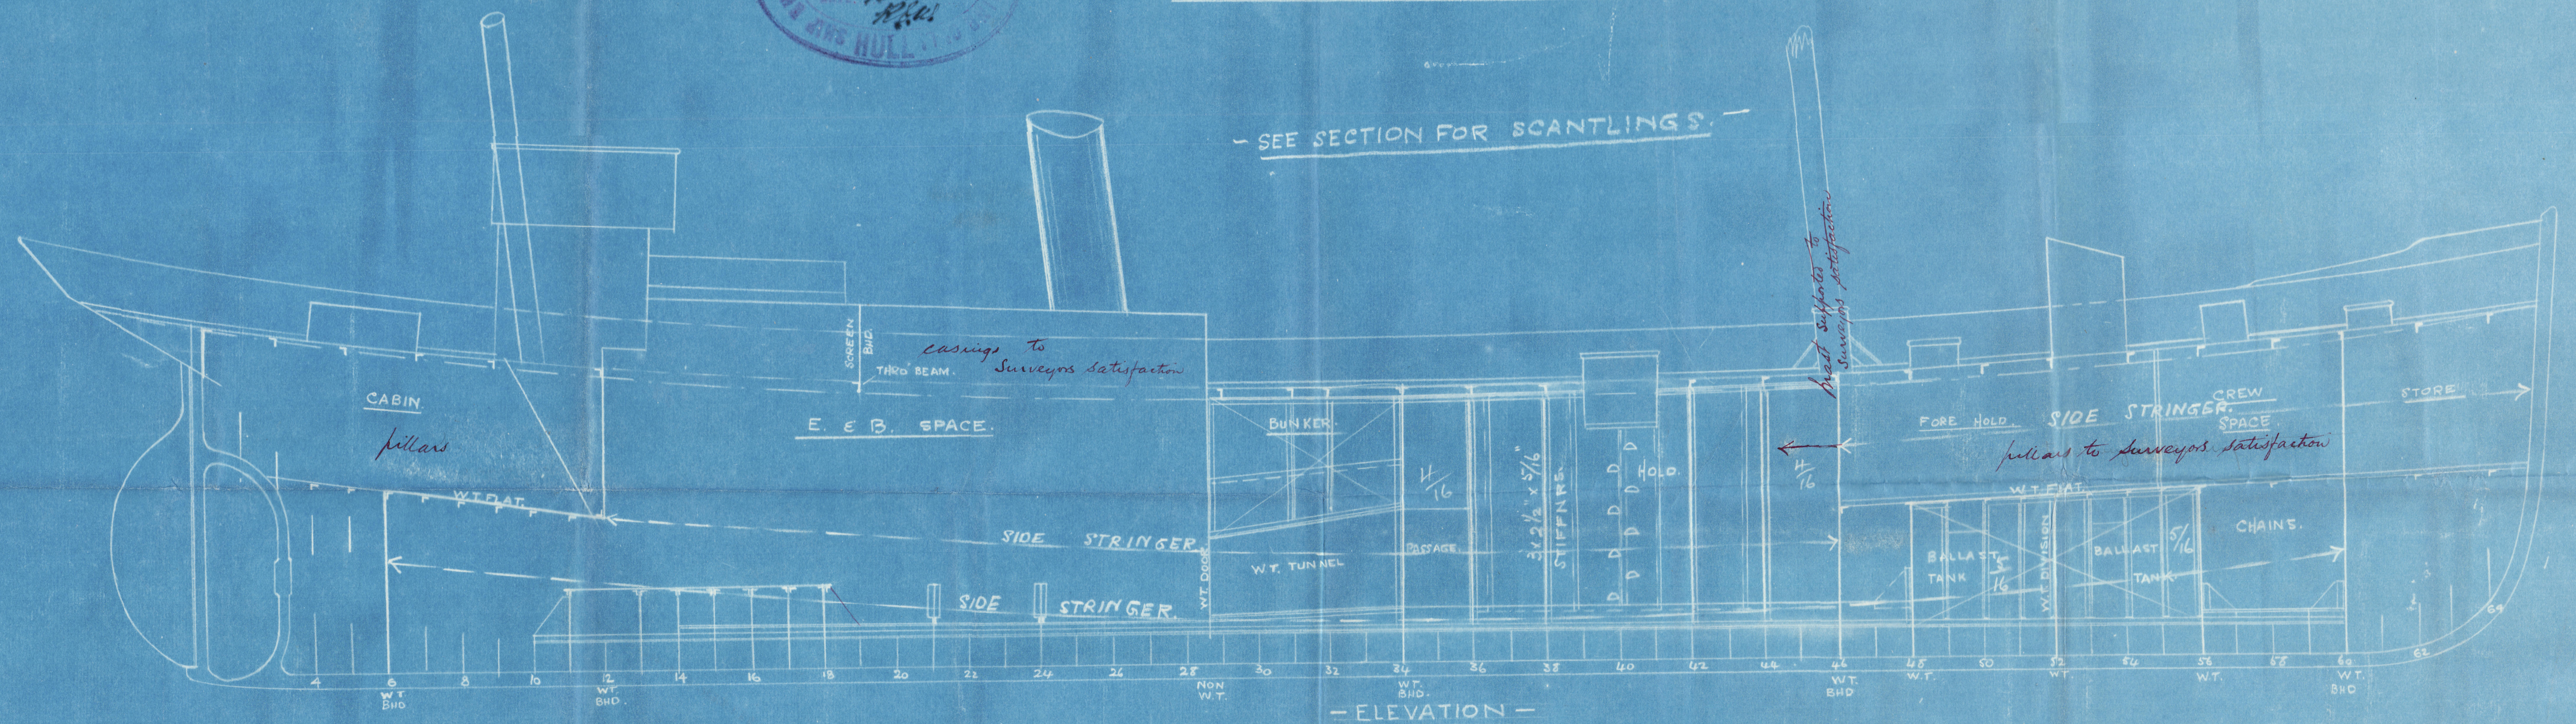

LLOYD'S REGISTER  
OF SHIPPING.  
17 DEC 1904  
+ HULL +


C.B.  
21.12.04.



Earle's A & E. Co. Ltd.


N<sup>o</sup> 495.

Profile + Deck Plan.

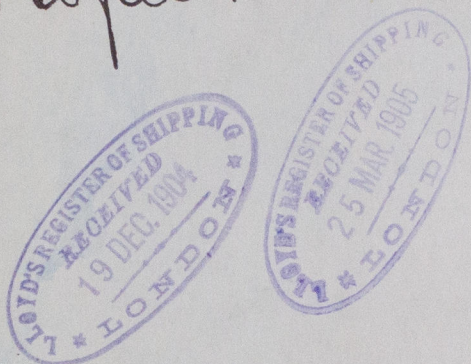

s/s Staffa

Null Report No. 16857

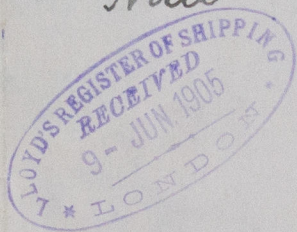

RETAIL

© 2021

W 186 - 0073  
Lloyd's Register  
Foundation