

POOP DECK

PROPOSED DECK PLANS

OF A STEEL SCREW STEAMER

TO CLASS 100 A1 AT LLOYDS



SCALE 1/8" = 1 FOOT

BRIDGE DECK

F'CLE DECK



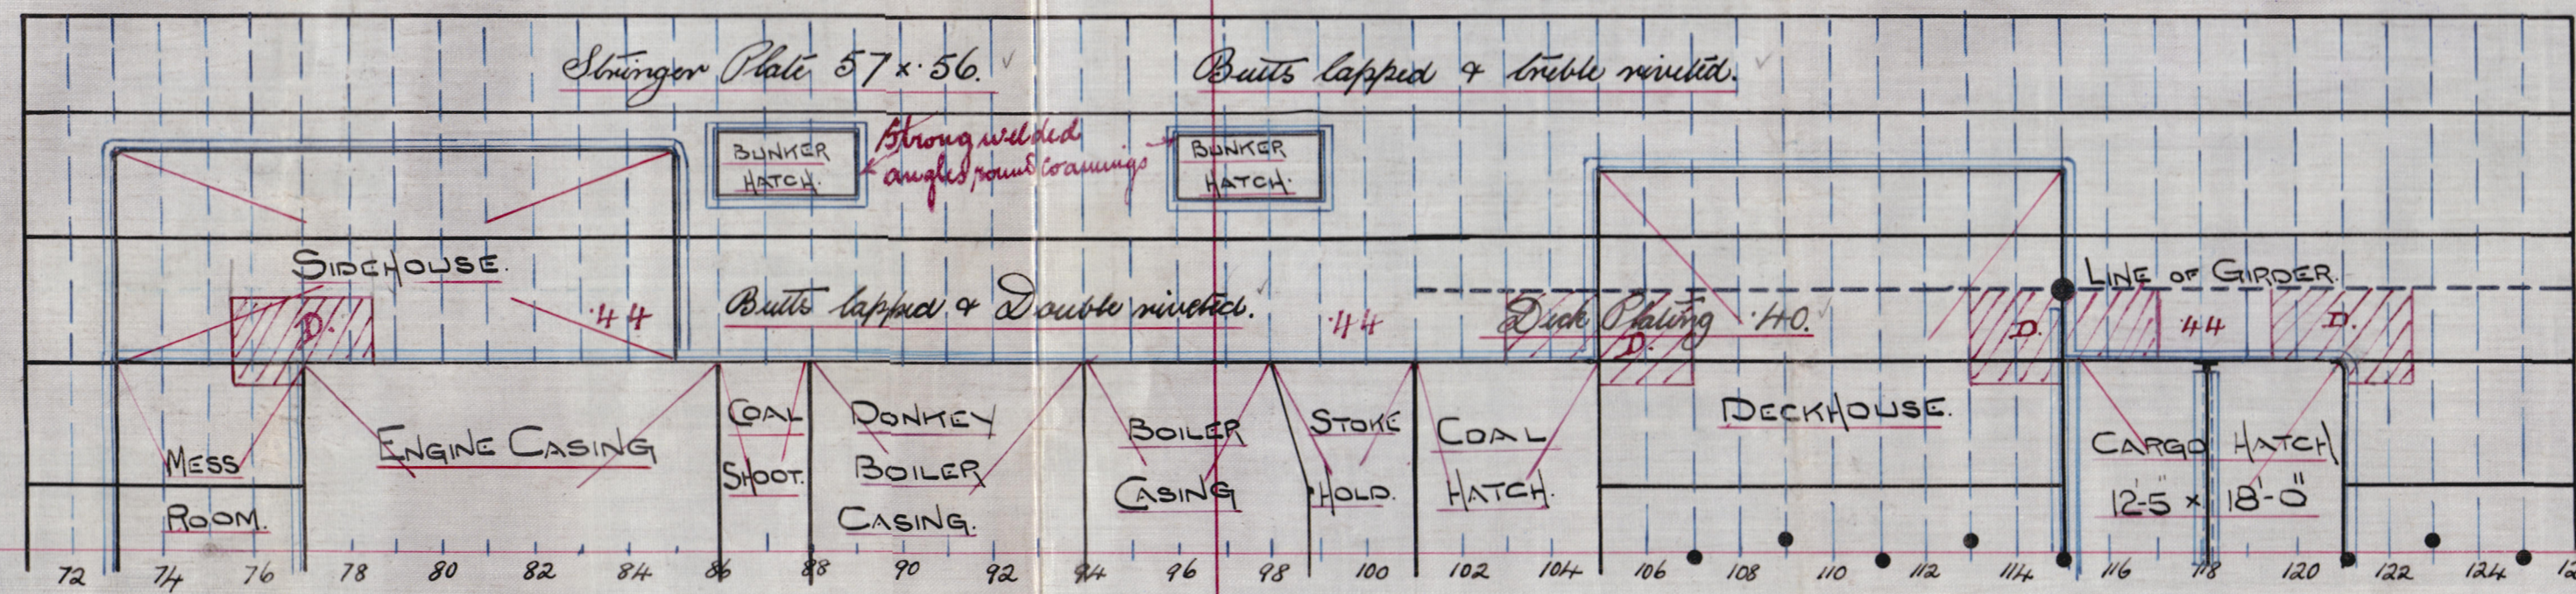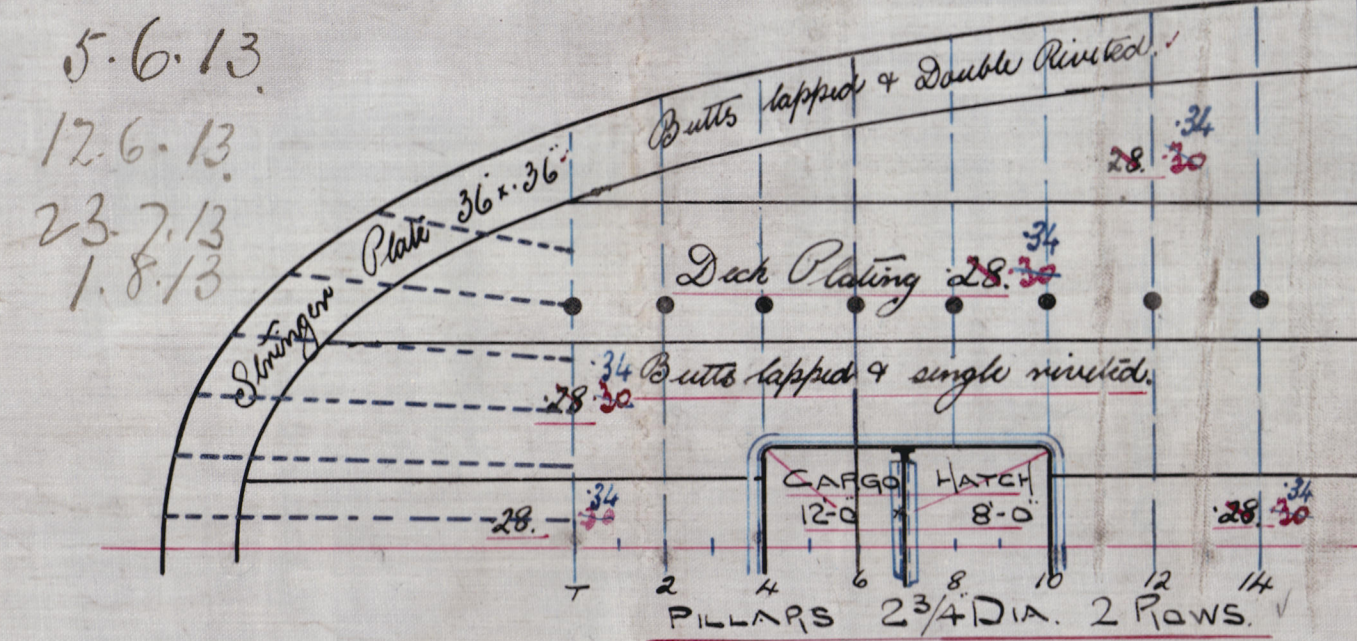


UPPER DECK

2ND DECK

WOOD, SKINNER & CO^{LD}
SHIPBUILDERS
NEWCASTLE ON TYNE.

Nº 187 SHIP.

 




Wood Skinner & Co.

No 184.


Deck Plan

S.S. "SPRINGWELL".

No. Rpt. No. 66085

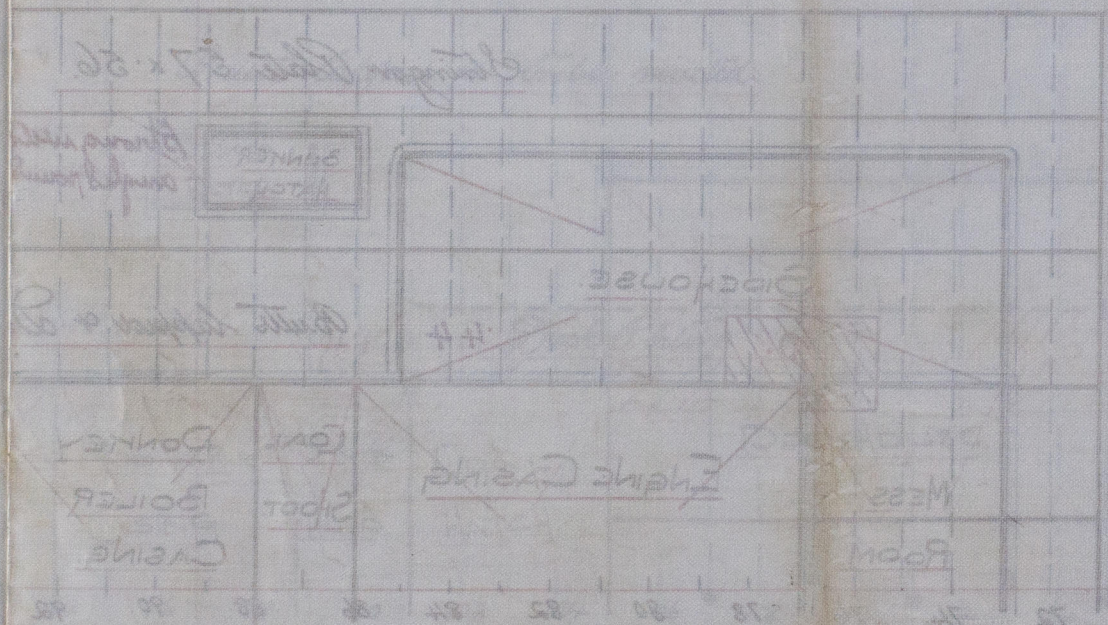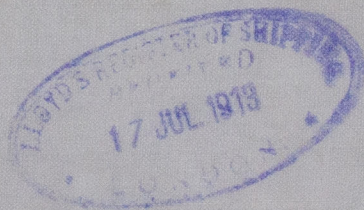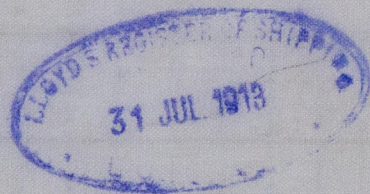

UPPER

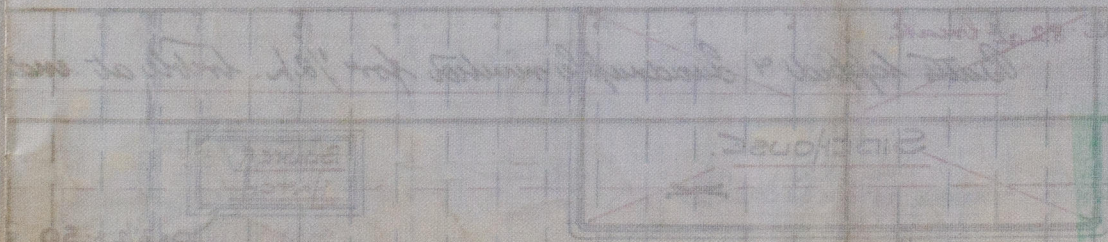

WAS6 - 0086



© 2021

Lloyd's Register
Foundation