




12.6.13.
27.11.13

PROPOSED ALTERNATIVE ARRANGEMENT OF TANK SIDE & DOUBLE BOTTOM


N^o 187 SHIP

SCALE $\frac{1}{2}$ " = 1 FOOT

— AS FITTED IN SHIP. —

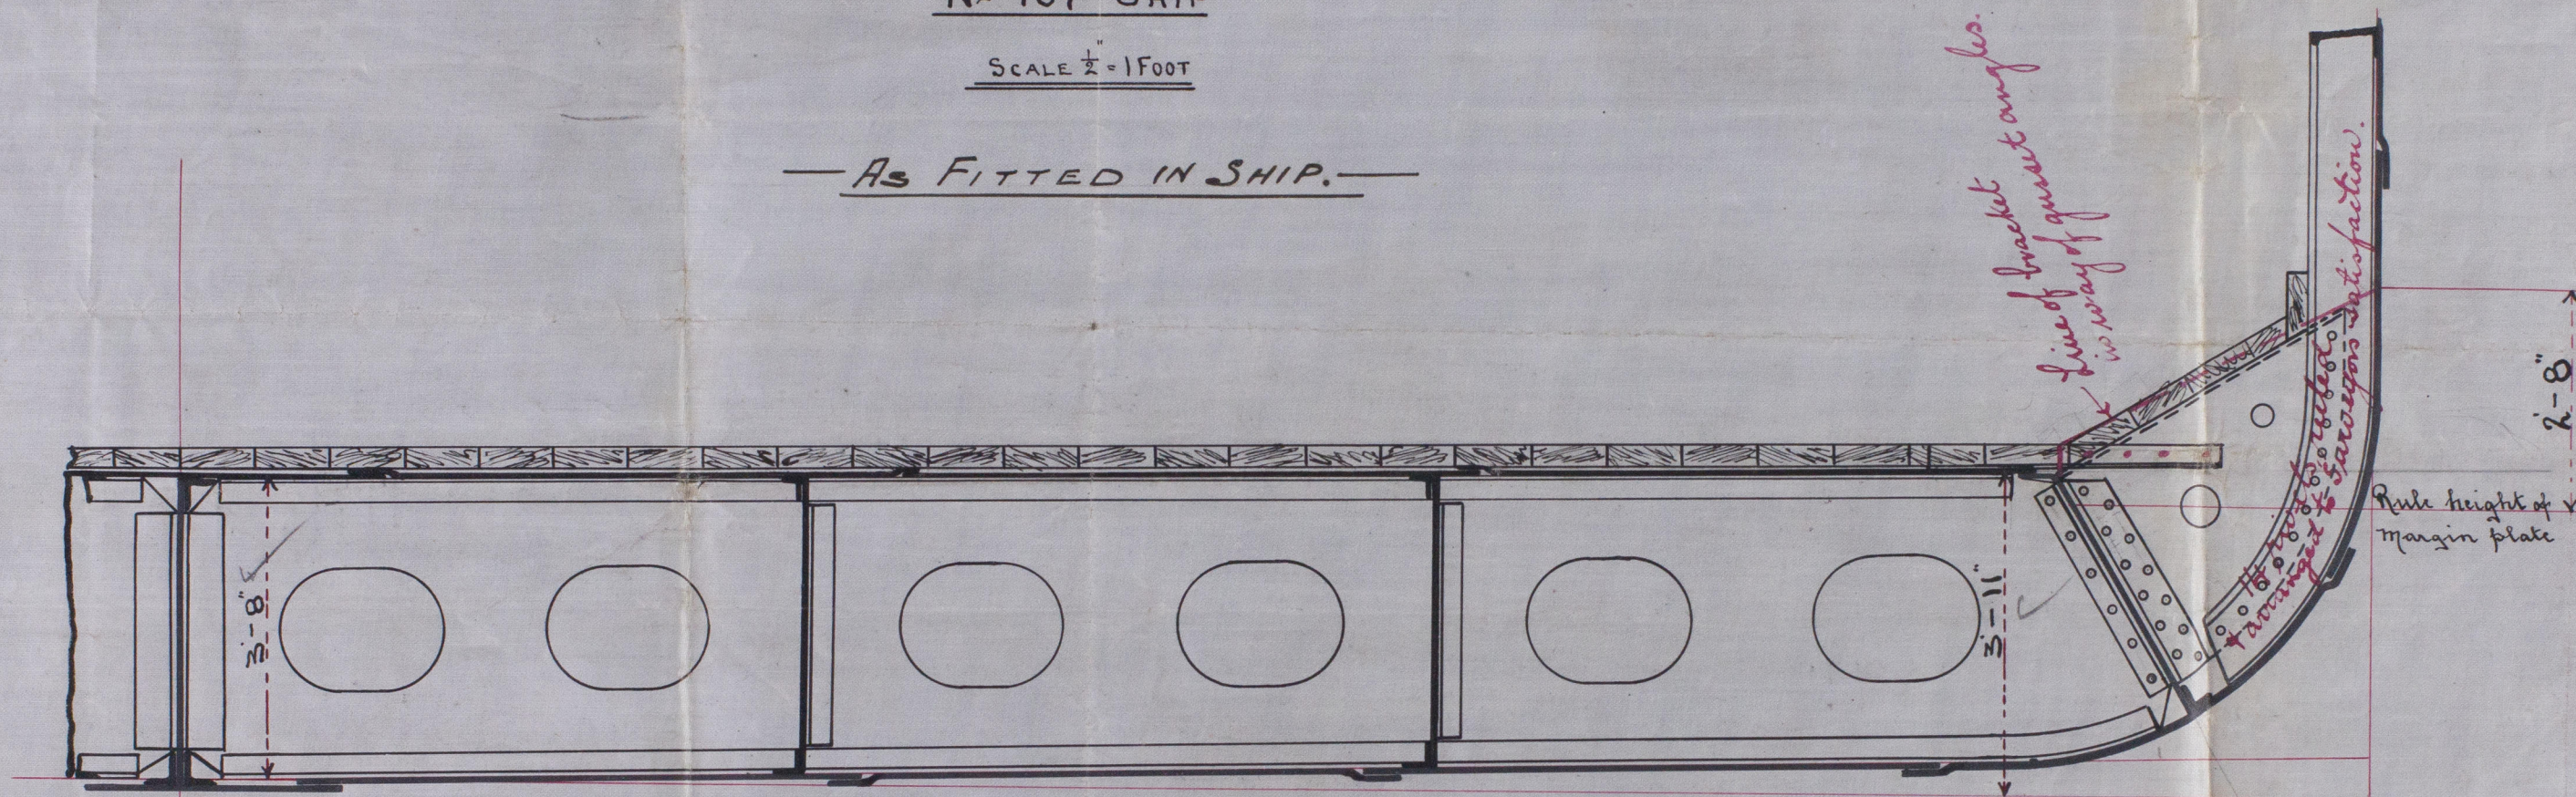

SKETCH SHOWING PROPOSED METHOD OF
FITTING DOUBLE BUTTSTRAPS TO KEEL

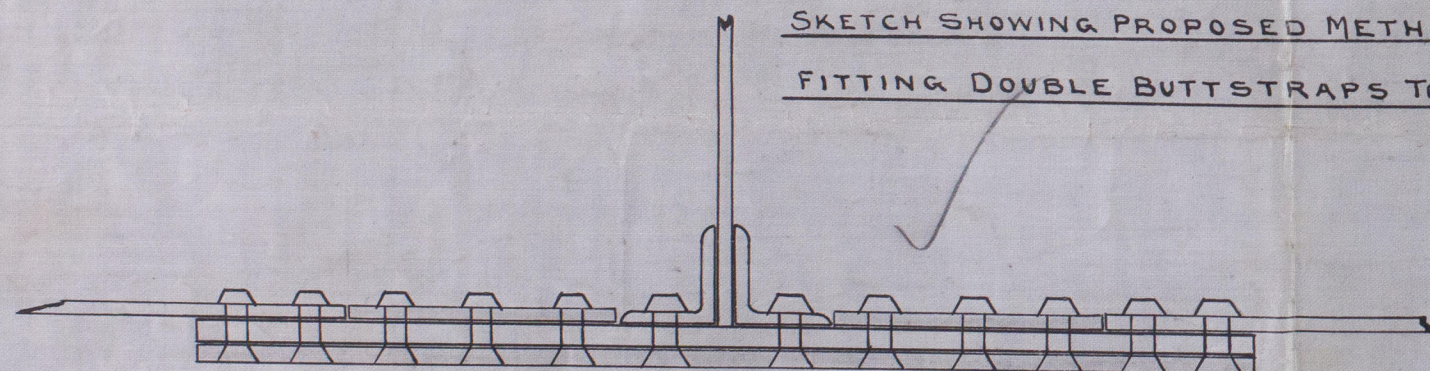


WOOD, SKINNER & CO. LTD.
SHIPBUILDERS
NEWCASTLE-ON-TYNE



C.F.
12/6/13.



PROPOSED ALTERNATIVE

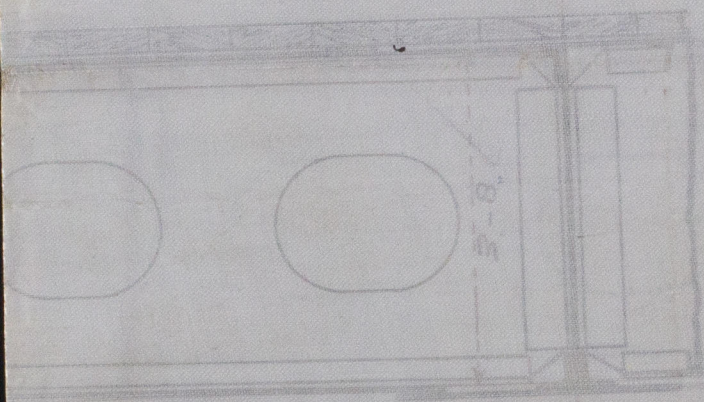

SKETCH SHOWING PROPOSED
FITTING DOUBLE BUTT

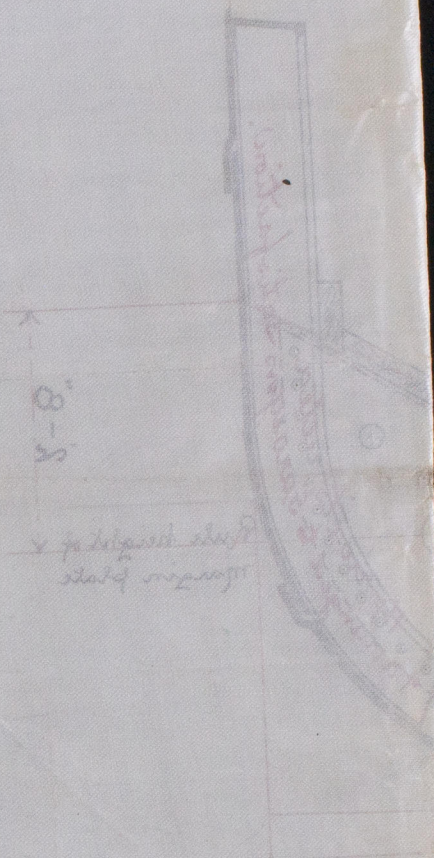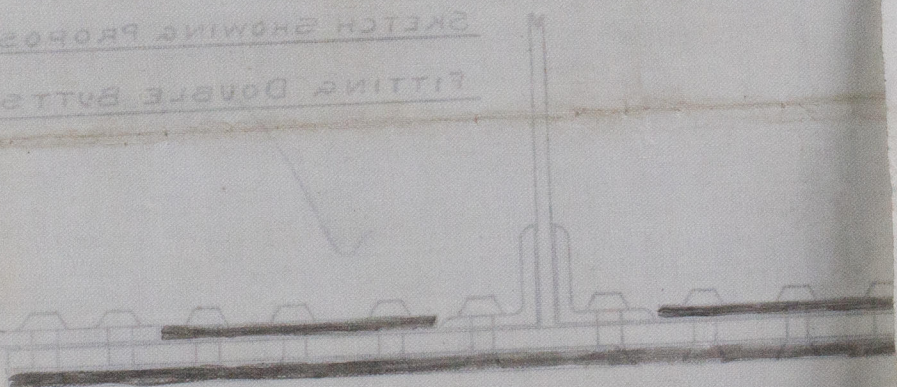

2021
Lloyd's Register
Foundation