

*COCHRANE & SONS  
25.1.07.  
SHIPBUILDERS  
SELBY.*

25.1.07.

*RETAIN*

# MIDSHIP SECTION

STEEL SCREW TRAWLER

N<sup>o</sup> 402.


DIM:- 120'-0" x 22'-0" EX x 11'-6" HOLD x 12'-3" MLD

SCALE 1/2" = 1 FOOT.

TO CLASS 100 A1. AT LLOYD'S FOR FISHING PURPOSES.

E & B. CASING AS PREVIOUSLY APPROVED.

DECK PLATED OVER AT SIDES OF E & B CASING.

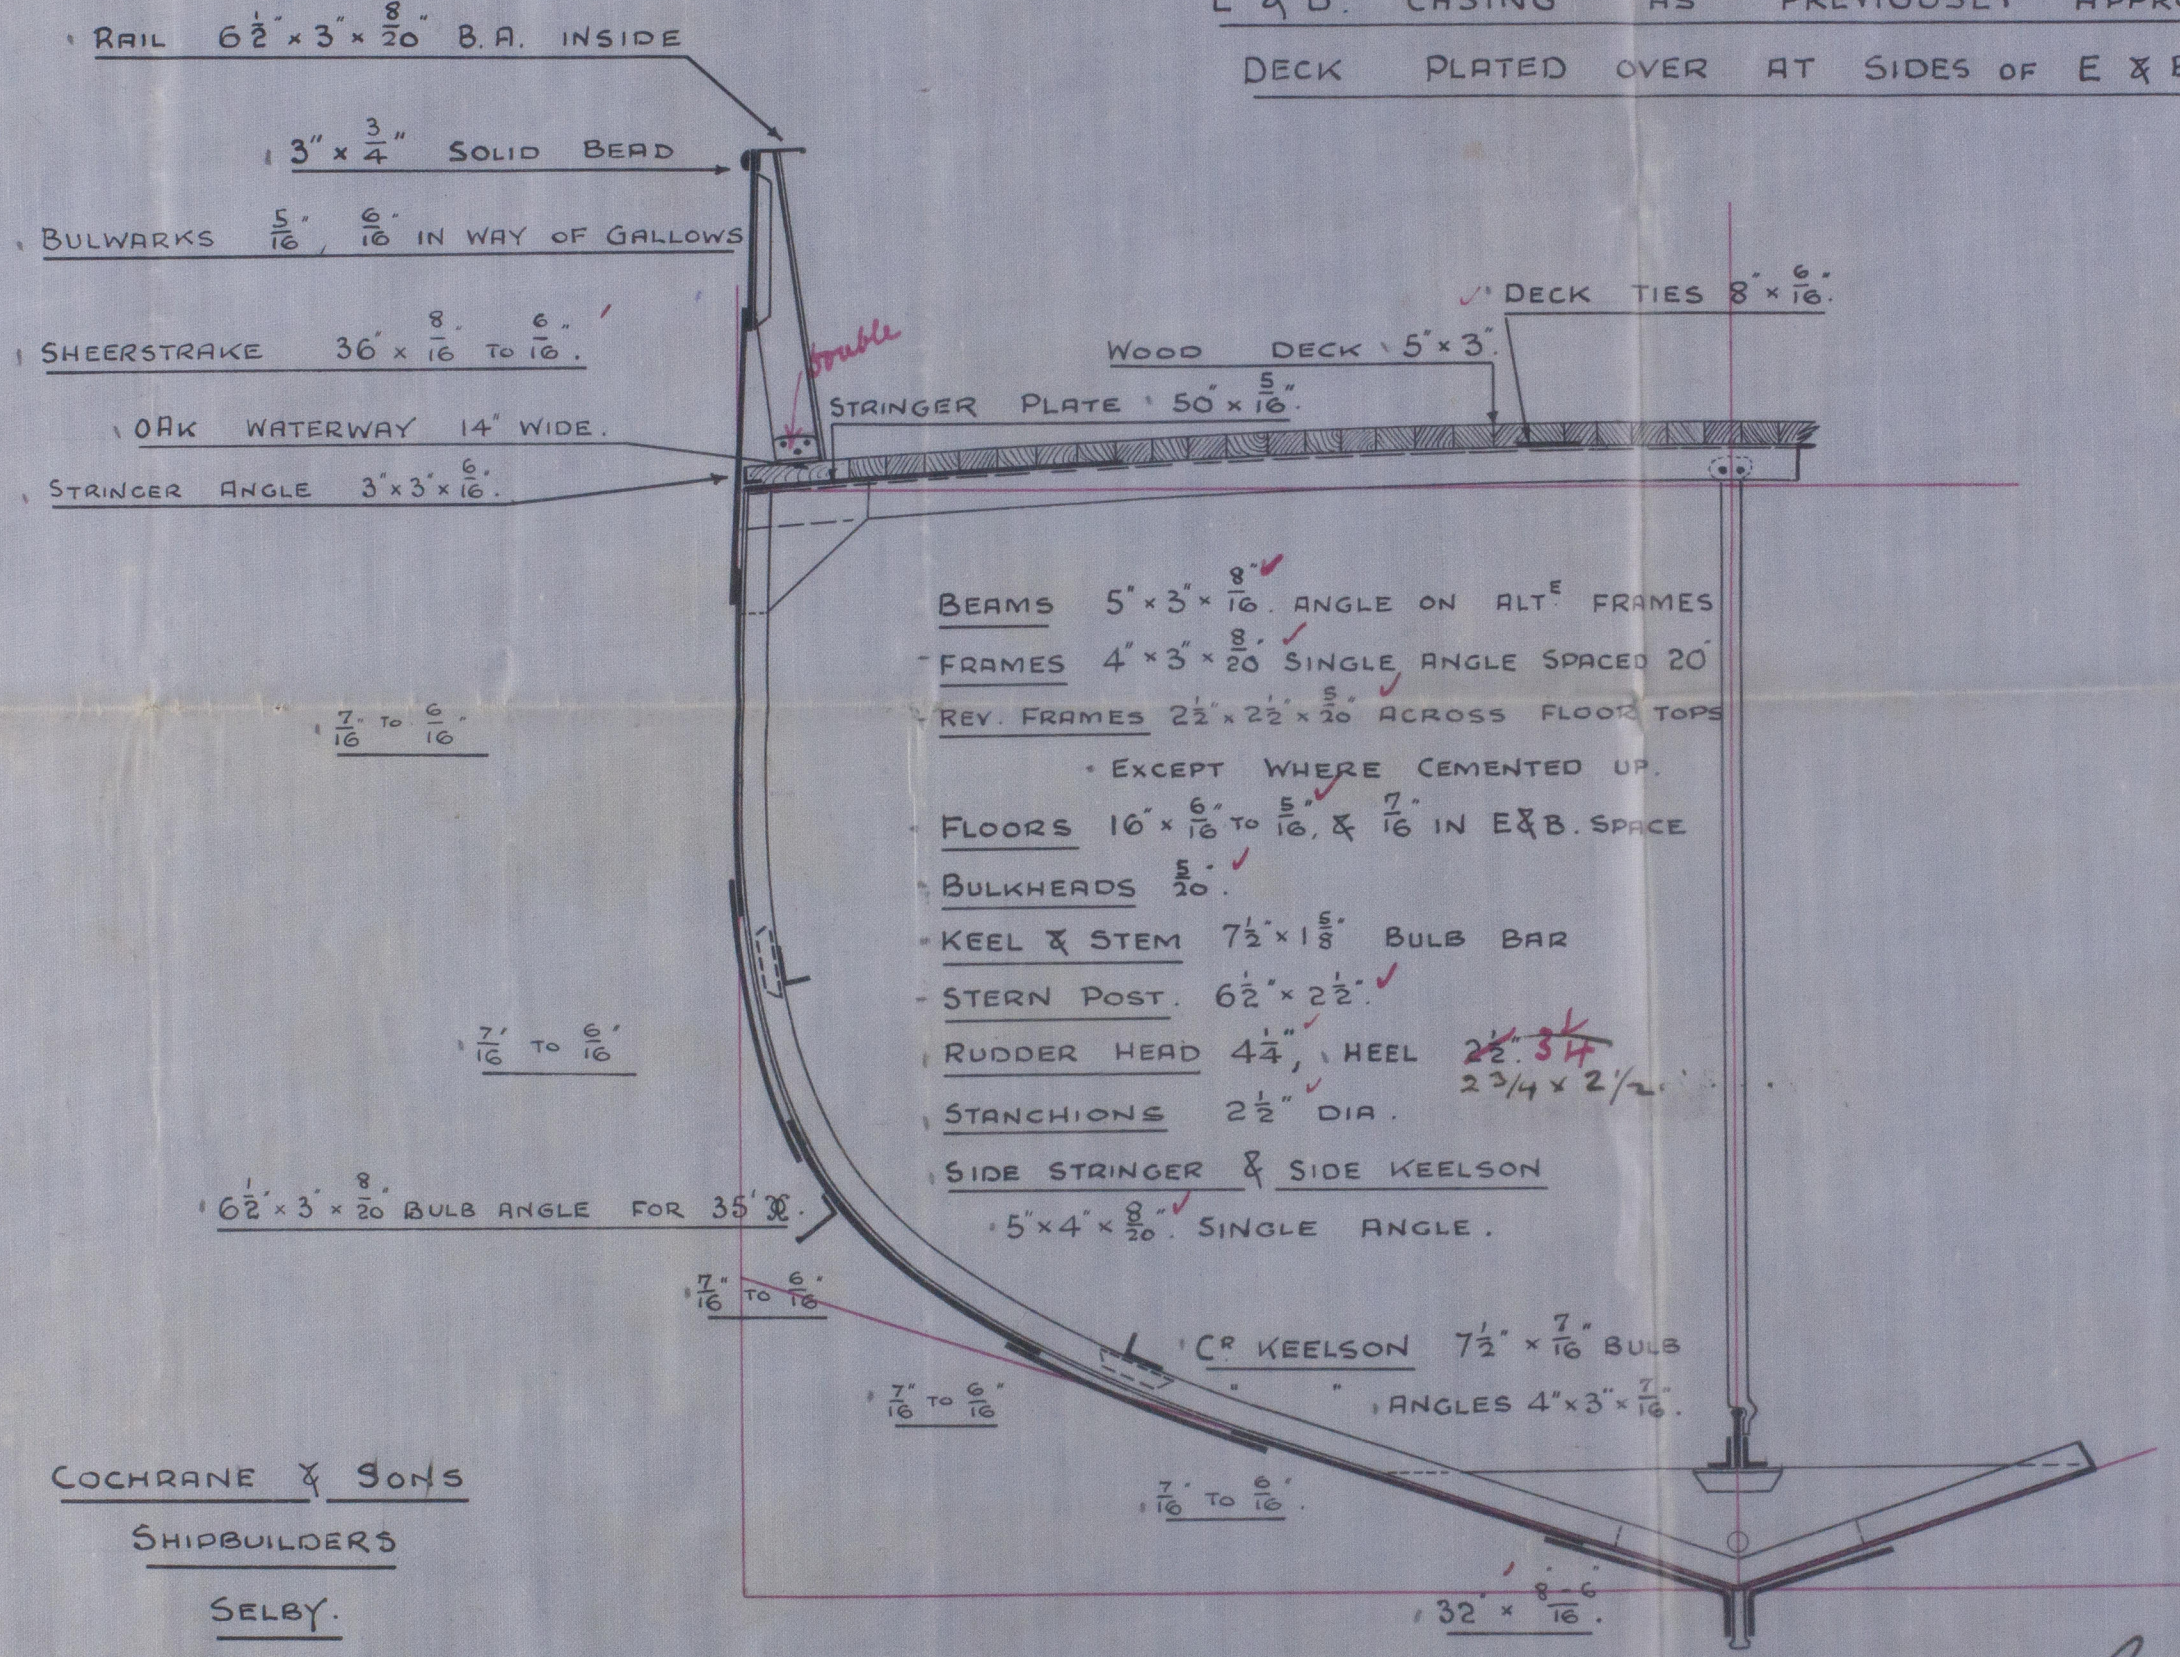

## NUMERALS

|                    |  |
|--------------------|--|
| 1/2 GIRTH          | - 19.16                                  |
| 1/2 BREADTH        | - 10.95                                  |
| DEPTH              | - 12.70                                  |
|                    | - 42.81 1 <sup>ST</sup> N <sup>o</sup>   |
| LENGTH AS PER RULE | - 118.83                                 |
|                    | - 5087.11 2 <sup>ND</sup> N <sup>o</sup> |

## EQUIPMENT

|                 |         | 5 1/4 | CWTS | EX | STOCK  |
|-----------------|---------|-------|------|----|--------|
| 1 <sup>ST</sup> | BOWER   | 5 1/4 | ✓    |    |        |
| 2 <sup>ND</sup> | "       | 4 3/4 | ✓    |    |        |
| 3 <sup>RD</sup> | "       | 2 1/2 | ✓    |    |        |
| 90              | FATHOMS | 1     | ✓    |    | CABLE  |
| 60              | "       | 6     | ✓    |    | HAWSER |
| 60              | "       | 4 1/2 | ✓    |    | WARP   |

## PROPORTIONS

|    |   |     |   |
|----|---|-----|---|
| OL | = | 5.4 | ✓ |
| OL | = | 9.3 |   |

## RIVETING

BUTTS OF SHELL PLATING STRAPPED & DOUBLE RIVETED, BULWARKS SINGLE RIVETED. ALL SHELL LANDINGS DOUBLE RIV. 3/4" RIVETS. BUTTS OF DECK PLATING OVERLAPPED & DOUBLE RIV.

COCHRANE & SONS  
SHIPBUILDERS  
SELBY.

*C.B.  
24.1.07.*

*answ  
23-1-07.*



April 1939