


PROFILE & DECK PLAN  
STEEL SCREW TRAWLER

Nº 402.

DIM:- 120'-0" x 22'-0" x 11'-6" HOLD. 12'-3" MOULDED.

SCALE       $\frac{1}{4}'' = 1 \text{ FOOT.}$

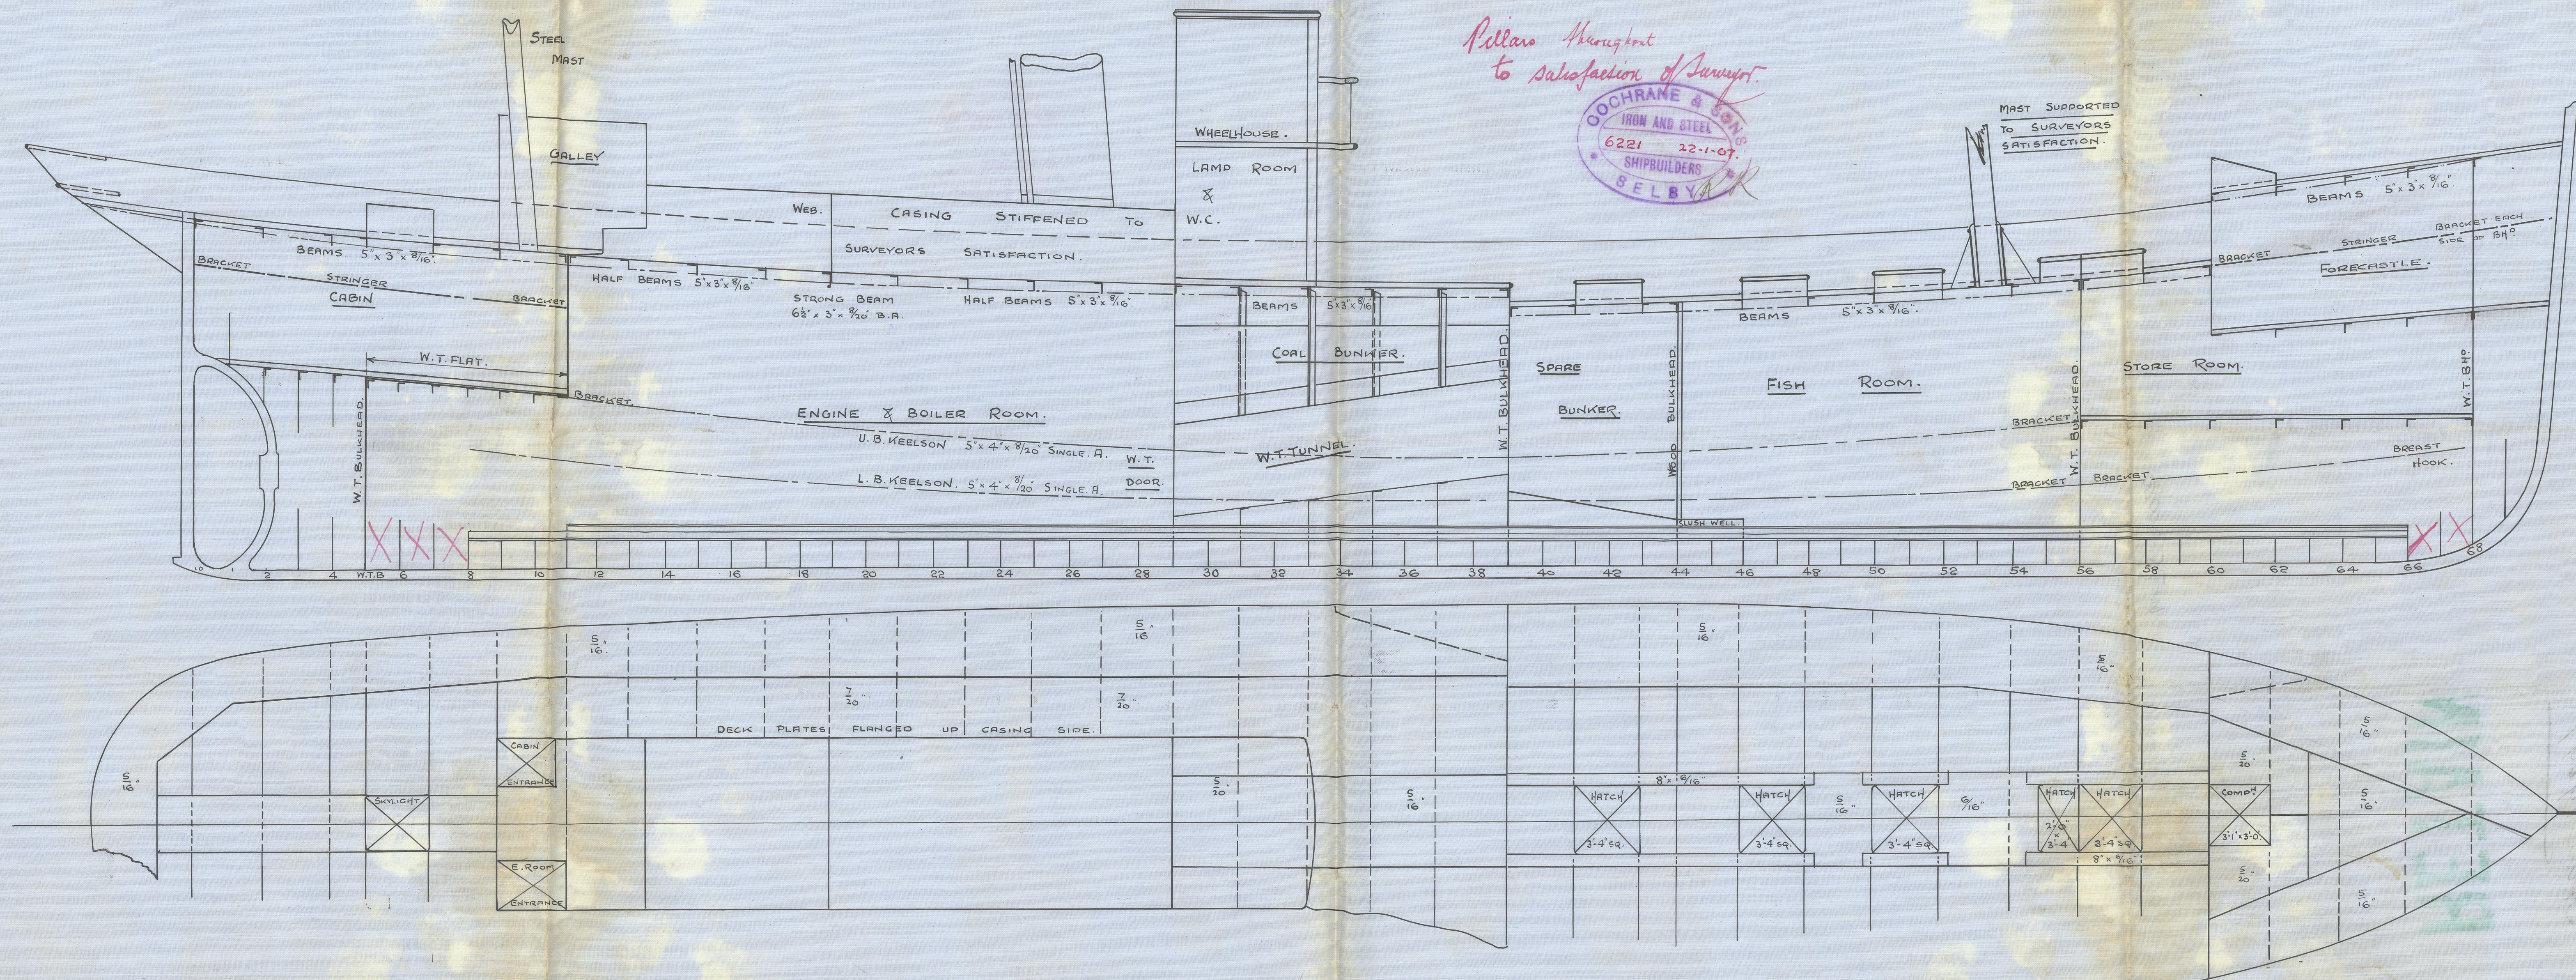

PILLARS THROUGHOUT TO SURVEYORS SATISFACTION

C.B.  
24.1.07.

answ.  
23-1-07

1804-1805  
and 1806-1807



Cochrane & Sons.

N<sup>o</sup> 402.

Profile & Deck Plan

"Southward"  
Hull 19397

RETAIN



© 2021

Lloyd's Register  
Foundation