


23. 2.05

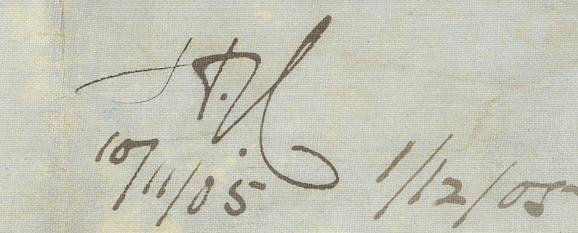

Mess^{rs} Workman Clark & Co

S.S. 235

Profile Plan



© 2021

Lloyd's Register
Foundation

W757-0118