



No 205


NUMERALS

1/2 BREADTH	10.5
1/2 GIRTH	19.33
DEPTH	10.75
1st N	40.58
LENGTH	117.50
2nd N	4768.15

MIDSHIP SECTION.

DIMS: 118' 6" B.P. x 21' 0" x 10' 3" M.L.D.

SCALE 1/2" = 1 FT.

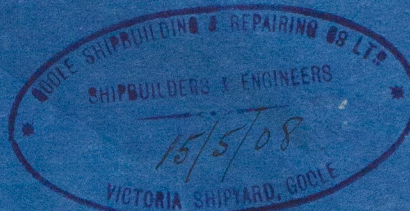

EQUIPMENT NO. 5291

R.O.D. 2(4.5 x 2.75) + BRIDGE 1.5(8.75 x 7)	
+ FORECASTLE 1.5(8.75 x 7) + N° 5291	
2 BOWERS 6 1/4 CWTs	STOCKLESS
1 STREAM 1 3/4	EX STOCK
1 KEEL 3/4	EX STOCK
135 FTMS 13/16	STUD LINK CABLE
45	2 STEEL WIRE
75	2 1/4
90	4 HAWSER

EQUIPMENT N° CORRECTED FOR RECTIONS

RAISED Q.D. 40.25 x 2.75 x 2 = 221.38


BRIDGE 8.75 x 7 x 1.5 = 91.87

F/CASTLE 20.0 x 7 x 1.5 = 210.00

523.25

+ 4768.15

EQUIPMENT N° 5291.40

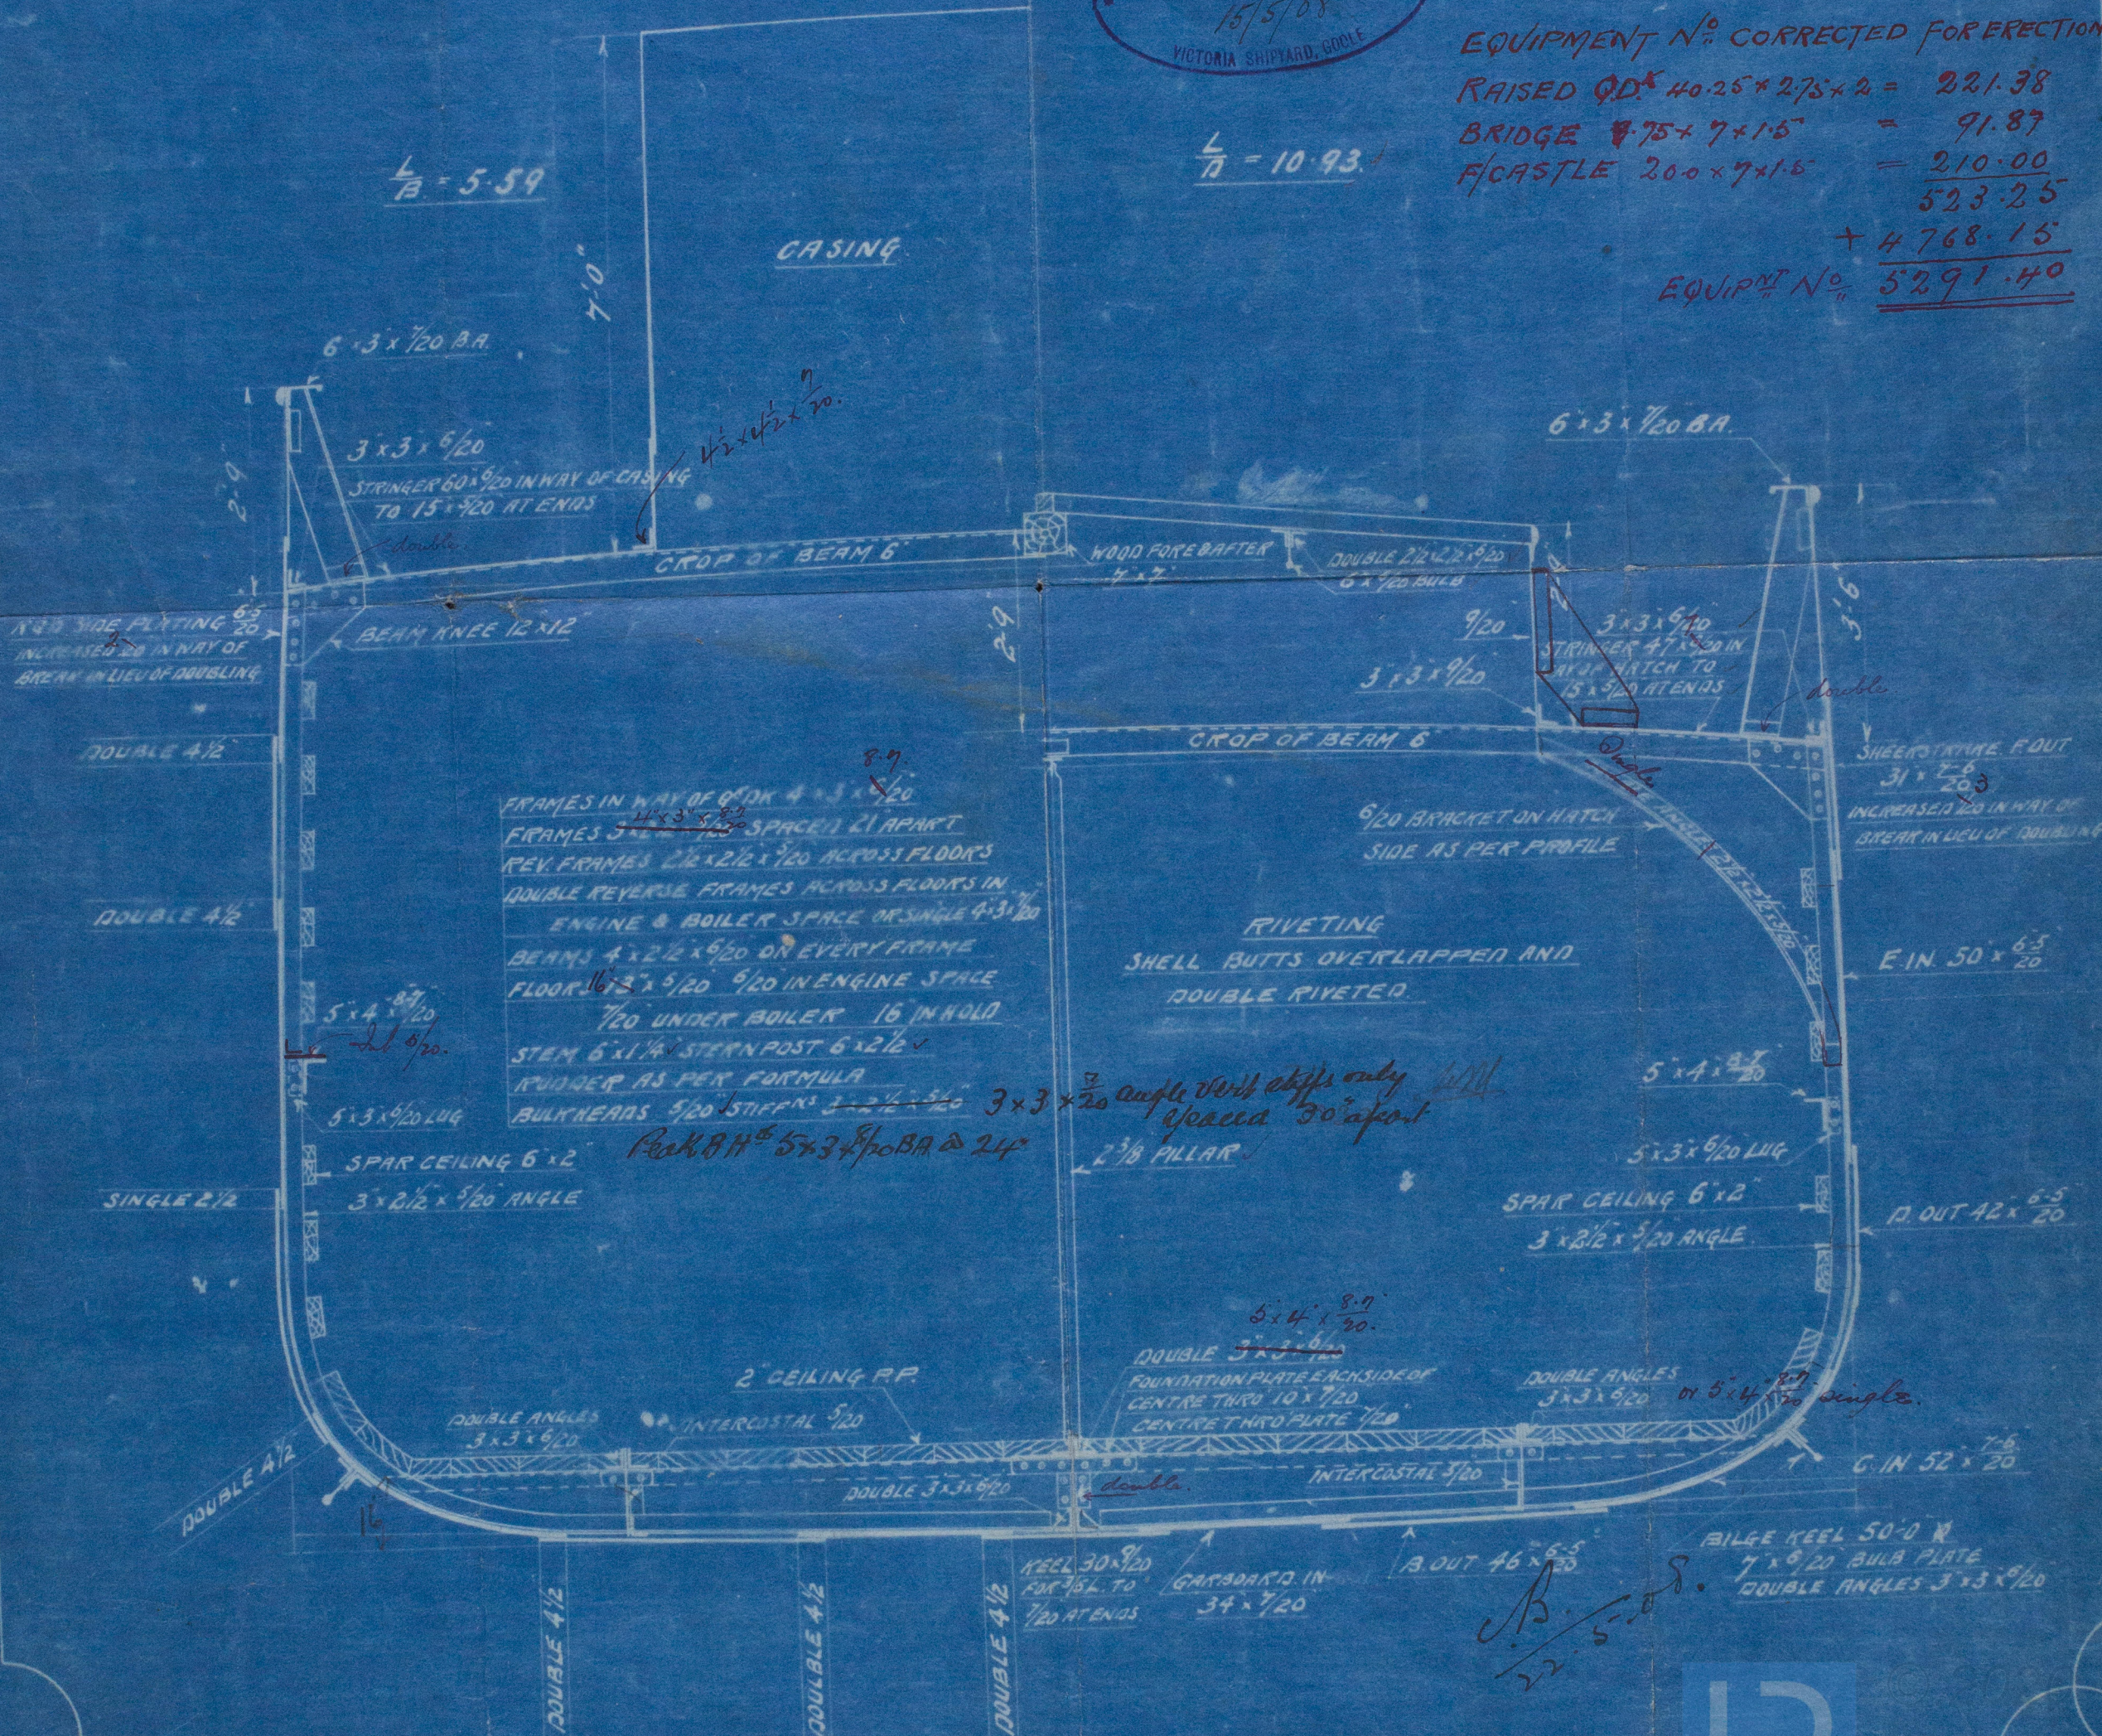

115-0031

- Midship Section
~~Geole S. B. Co's~~

~~No 124~~
ve

Dunde S.B. Co's

S.O. No. 205

S.S. "SUMMERGILL"

DUN. REPT. N^o 7414.

RETAIN



W758-0031



© 2020

Lloyd's Register
Foundation