



22.5.08
4.8.08




— LONGITUDINAL SECTION —

DIMS: 118'6" x 21'0" x 10'3" MLD

SCALE 1/4" = 1 FOOT

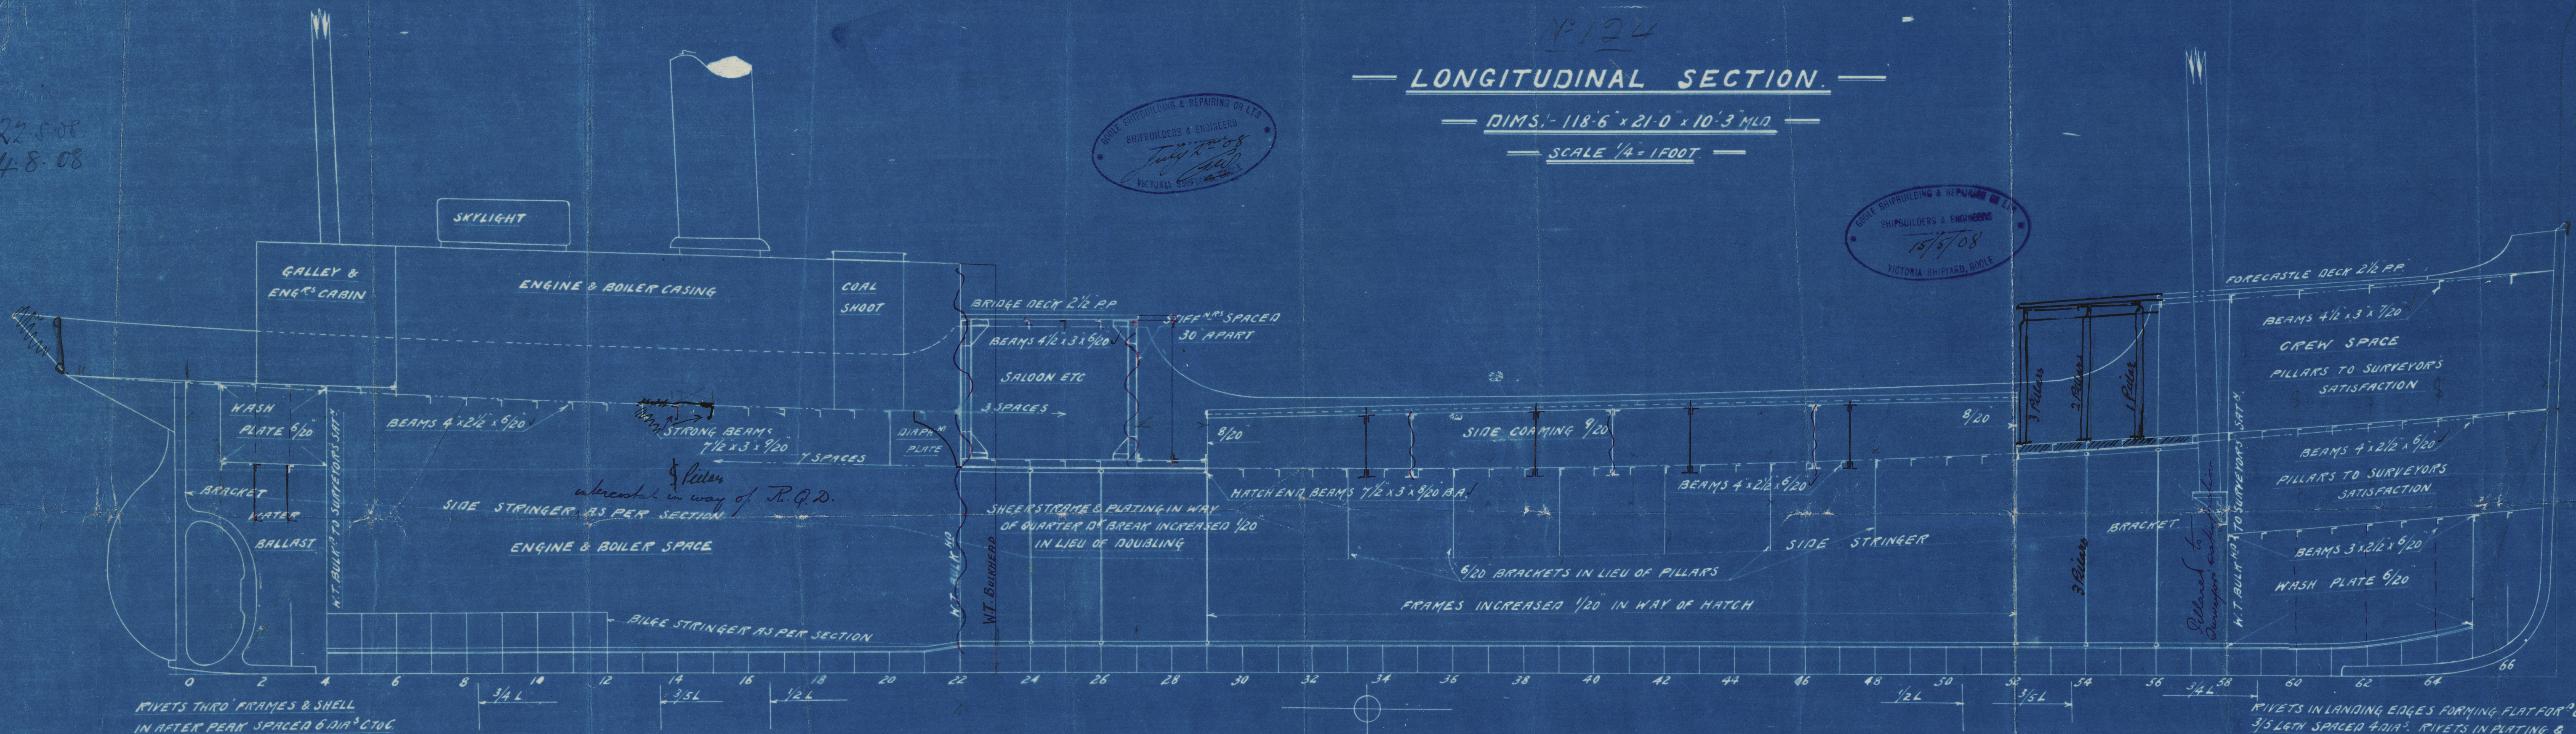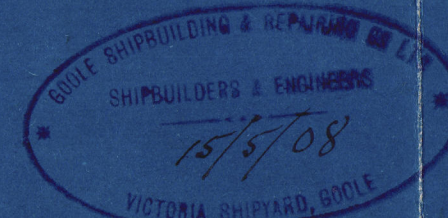

RIVETS IN LANDING EDGES FORMING FLAT FOR⁹ OF 3/5 LATH SPACED 4 DIA³. RIVETS IN PLATING & FRAMES 5/2 DIA³ & FRAMES DOUBLED FOR⁹ OF 3/5 LTH. BOTTOM STRENGTHENED AS PER RULES. RIVETS THRO' FRAMES & SHELL IN PEAK TANK SPACED 6 DIA³ CTOC

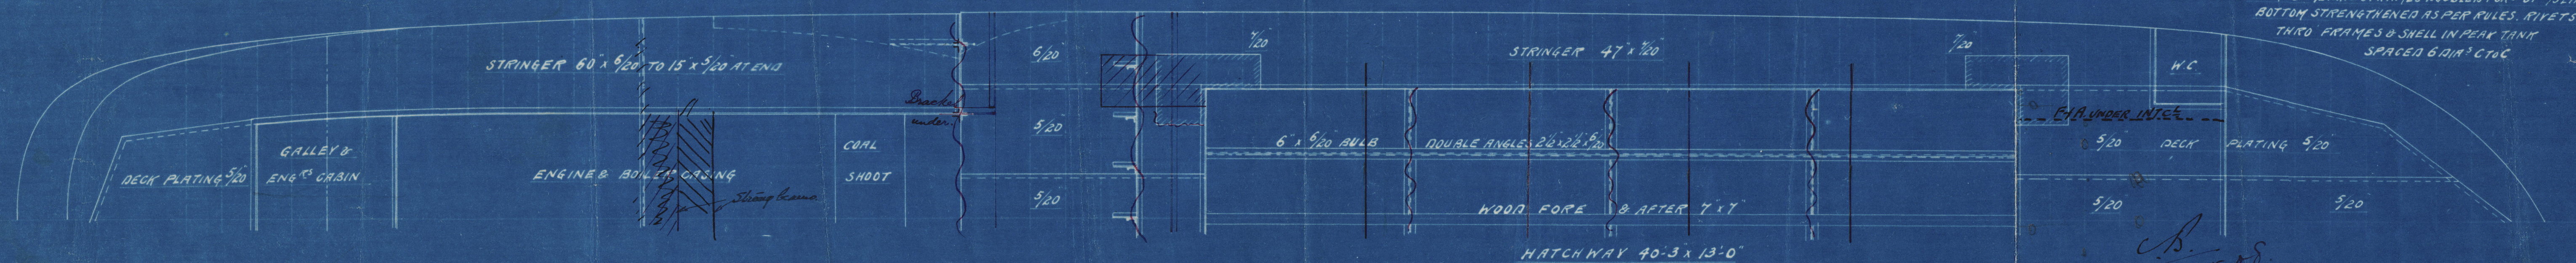

C.B.
22.5.08





Profile & Deck Plan
~~Good S. R. Co.~~


~~No 124~~

Dundee M.B. Co.

ss. No. 205

S.S. "SUMMERSGILL"

DUNREPT. NO. 74/14

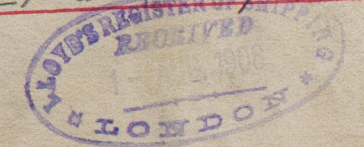

RETAIN



07202032

Lloyd's Register
Foundation

4060800
4000
5846
7000
439200 (11)
439200

6 (219600)
36600
14200
14200 (16)