


30.12.04

N^o76
PROFILE & DECK PLAN
DIM^s 152'-0" x 25'-6" x 12'-9" M^{LD}
SCALE 1/4" = 1 FOOT

SHIPPING & REPAIRS
SHIPBUILDERS & ENGINEERS
23/12/04

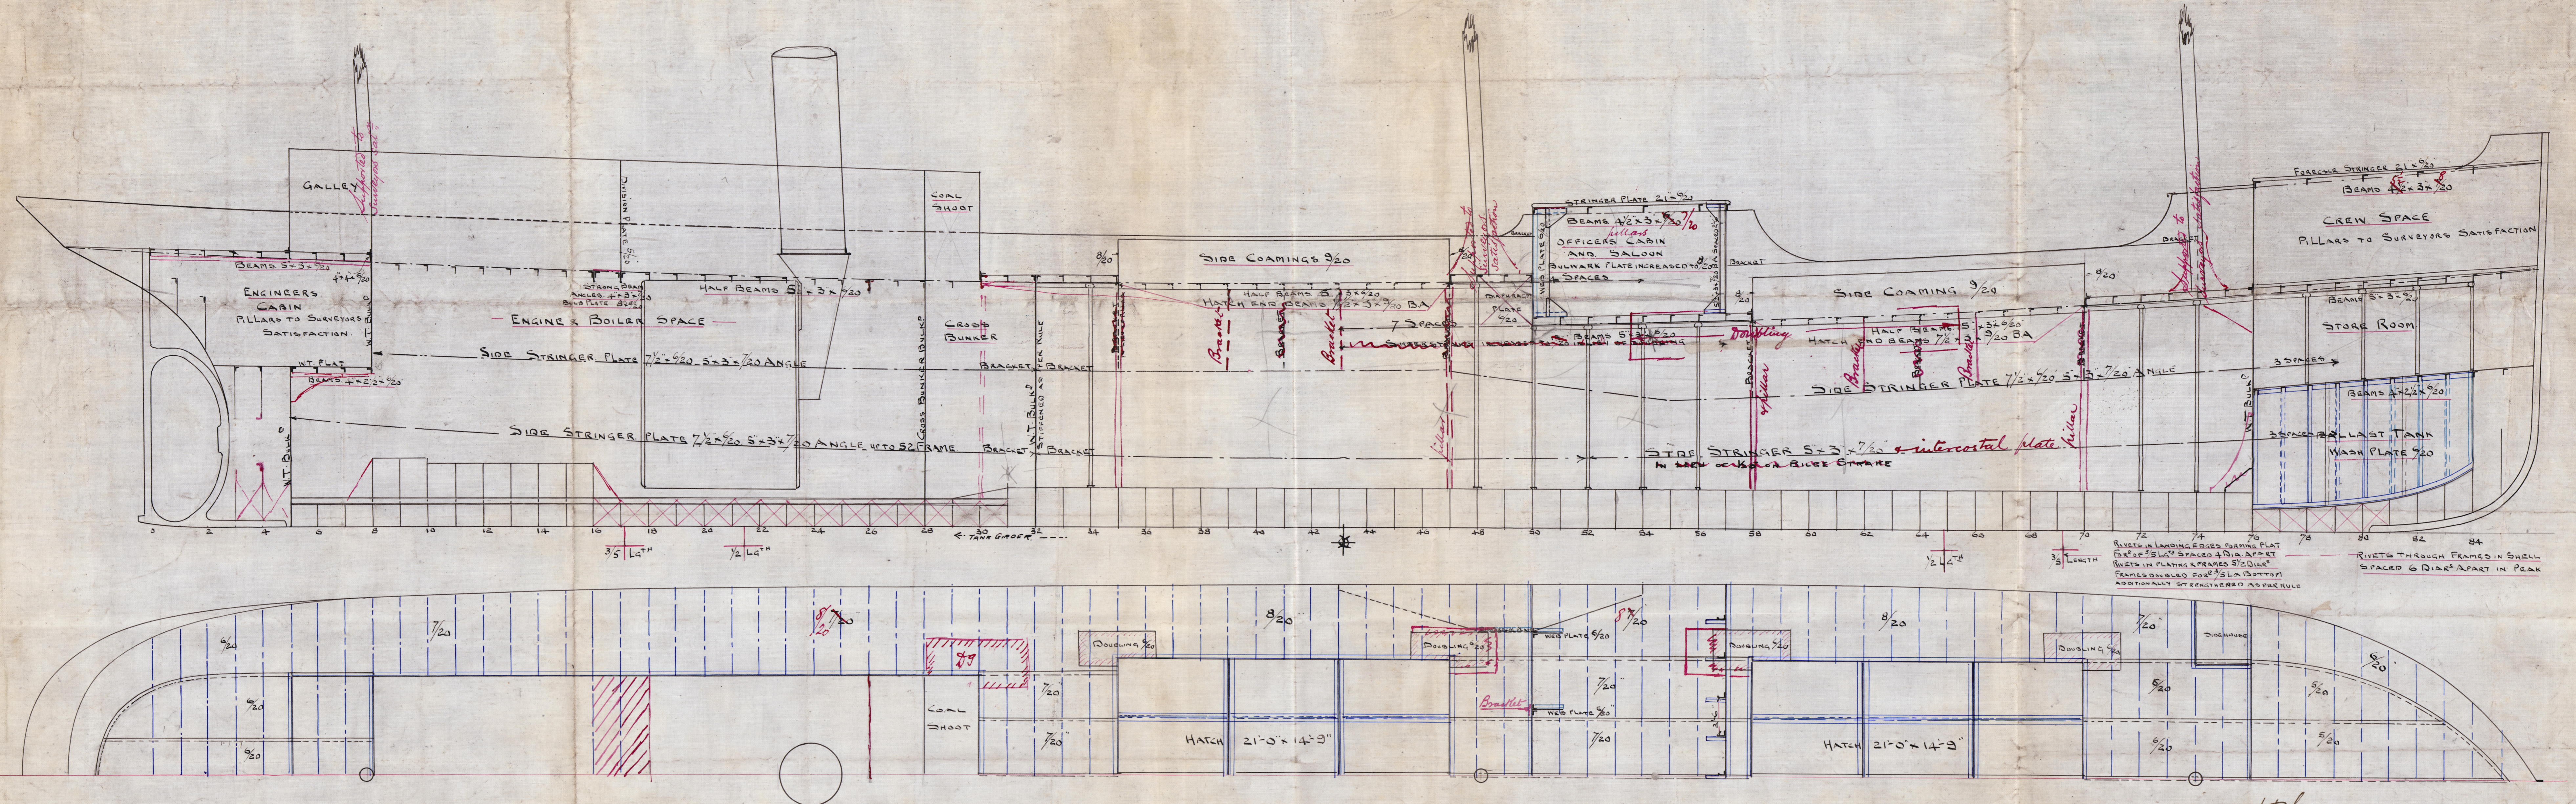

30/12/04

Goble S+R. Co. San
No 46

Profile + Deck Plan

St. Ann's
Still Report No-198-01



© 2020

Lloyd's Register
W7580079