

30.12.04

S.S. No 76 MIDSHIP SECTION OF A STEEL SCREW STEAMER


EQUIPMENT No 8323.

2(87.5x2.75)+1.5(12.25x7.0)+1.5(18.25x6.75)+7528.37	
2 BOWERS 10 1/2 CWTs	✓ STOCKLESS
1 " 8 3/4 "	✓ " "
1 STREAM 3 1/2 "	✓ EX STOCK
1 KEDGE 1 1/2 "	✓ " "
165 FATHOMS 1 1/6 "	✓ STUD CHAIN CABLE
60 " 2 3/4 "	✓ STEEL WIRE
75 " 2 1/2 "	✓ " "
90 " 5 1/2 "	✓ HAWSER.

NUMERALS

1/2 BREADTH	12.75
1/2 GIRTH	23.835
DEPTH	13.29
1ST No	49.875
LENGTH	150.94
2ND No	7528.37

DIMS 152-08P x 28-6 x 12-9 MLD
TO CLASS 100 AL LLOYDS
SCALE 1/4" = 1 FT

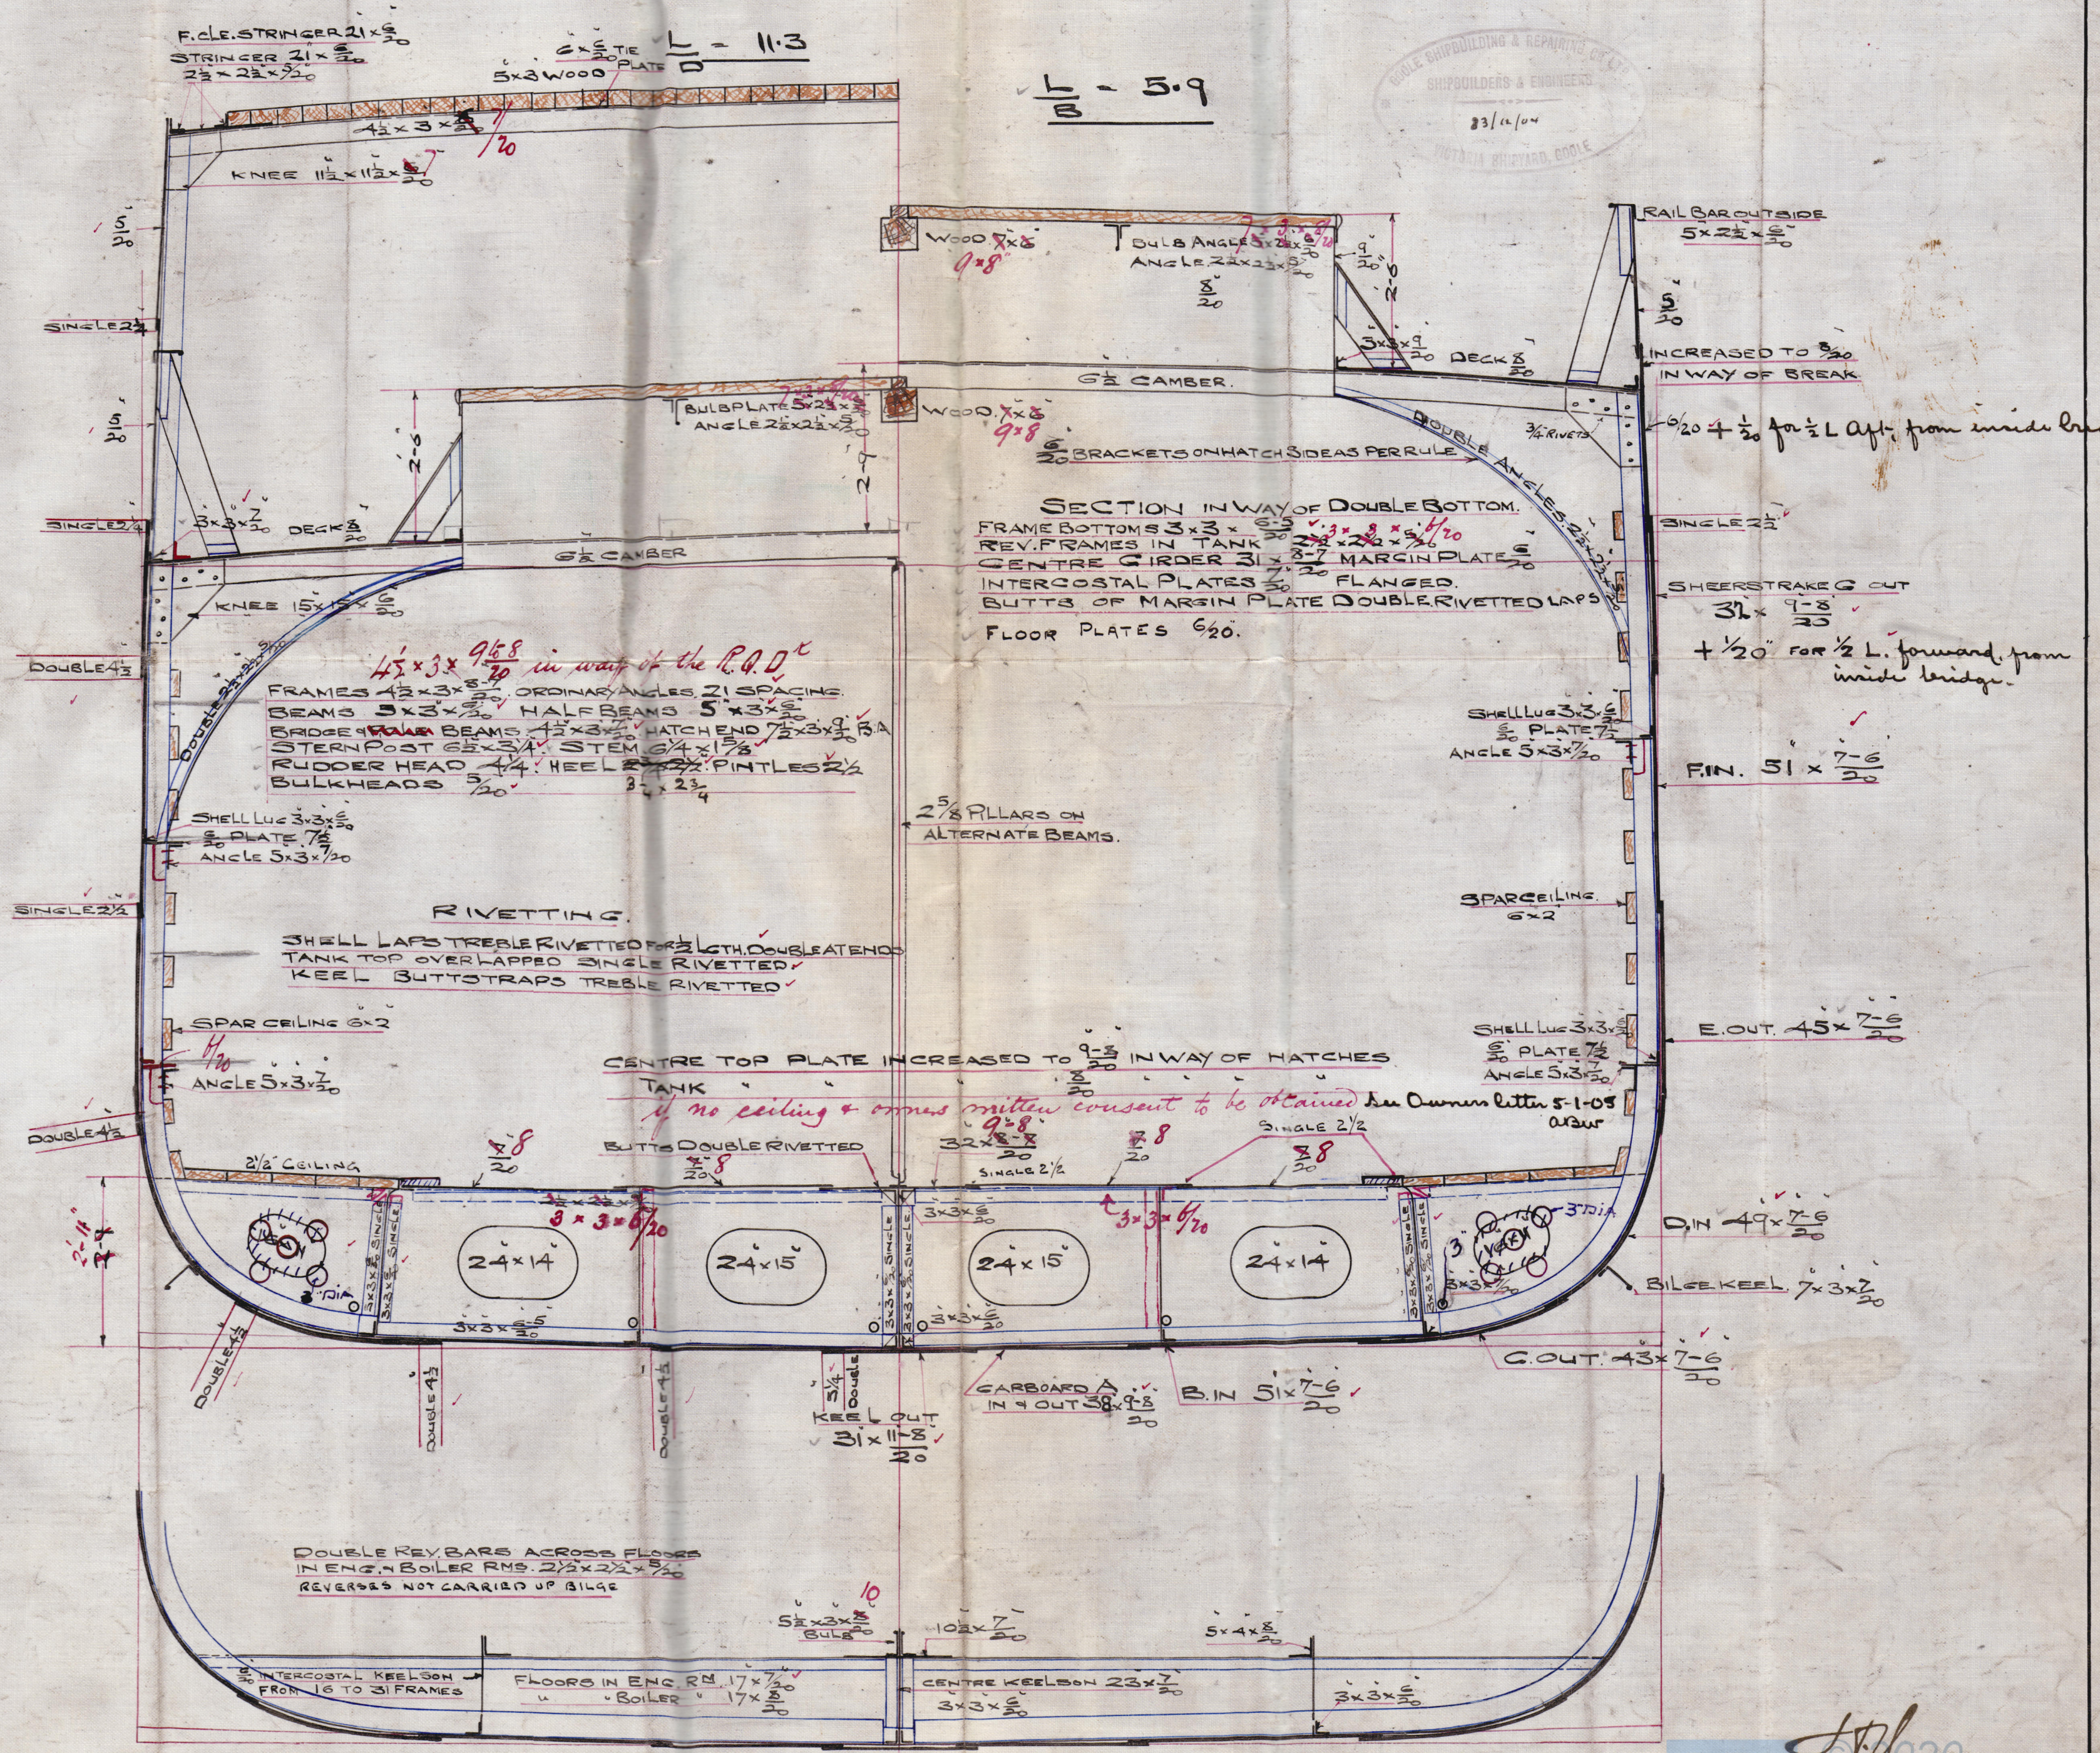

Isobel S. & R. C. Sim.
No. 46.

Midship Section.

s/s Sunnyside
Hull Report No. 17001



© 2020

Lloyd's Register

Foundation