



AMENDED
PROFILE & DECK PLANS

J CROWN & SONS

N^o 161

S S "SUNNIVA"

SLD RPT No 27130

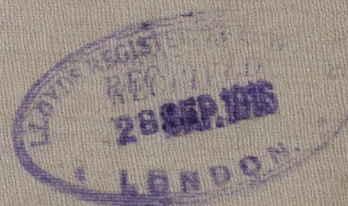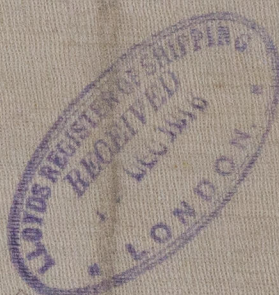

RETAIN



© 2021

Lloyd's Register
Foundation



© 2021

Lloyd's Register
Foundation