

PLAN No. 497
FOR ENCLOSURE TO
Messrs Lloyd's Surveyors
FROM
COCHRANE & SONS,
SHIPBUILDERS, SELBY.
DATE November 7th 1911. *RL*

PROFILE & DECK PLAN



No. 497-8

DIM. 141'-8" x 24'-0" x 13'-4" M.L.D.

SCALE 4" = ONE FOOT.

Pillars throughout to Surveyors Satisfaction.

PLAN No. 29
FOR ENCLOSURE TO
Messrs Lloyd's Surveyors
FROM
COCHRANE & SONS,
SHIPBUILDERS, SELBY.
DATE 11/3/11. *RL*

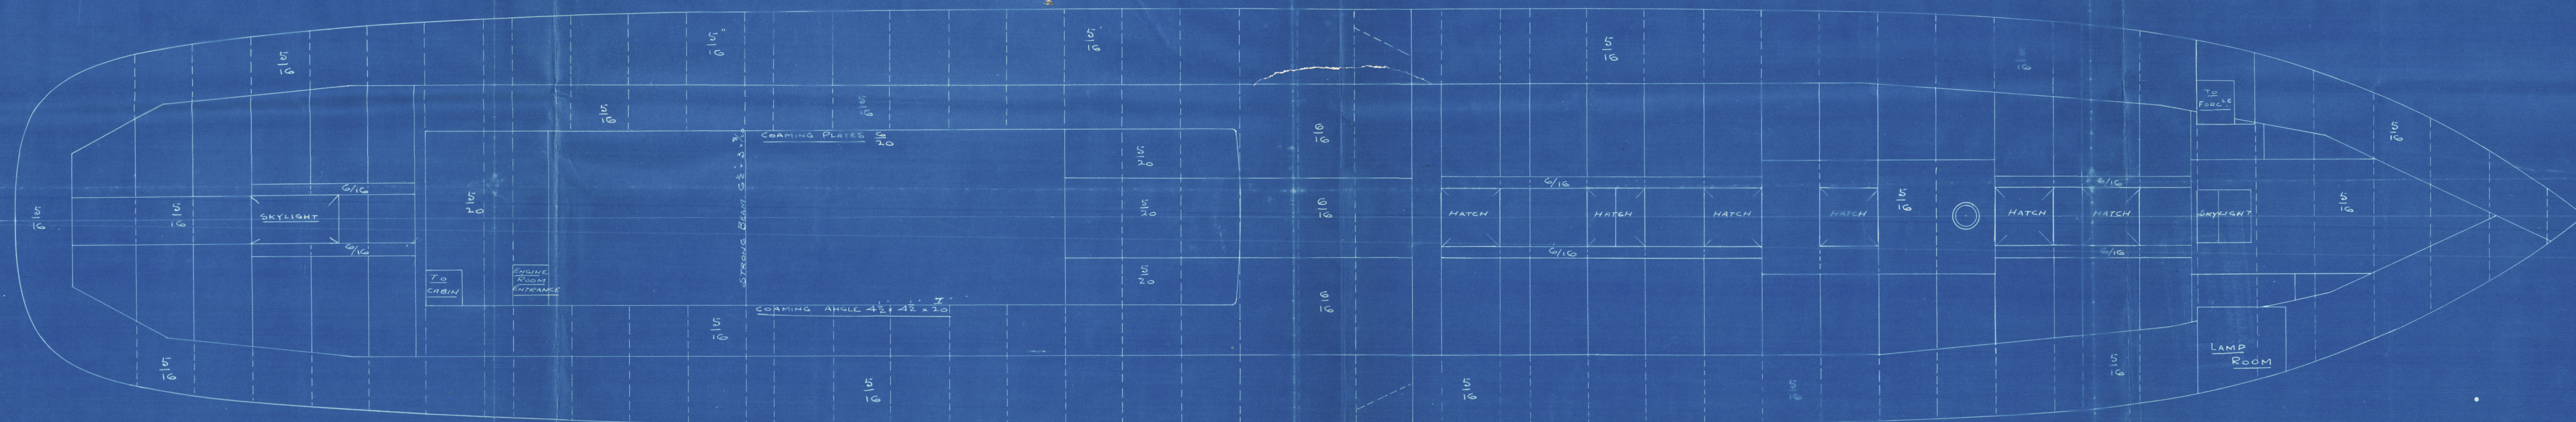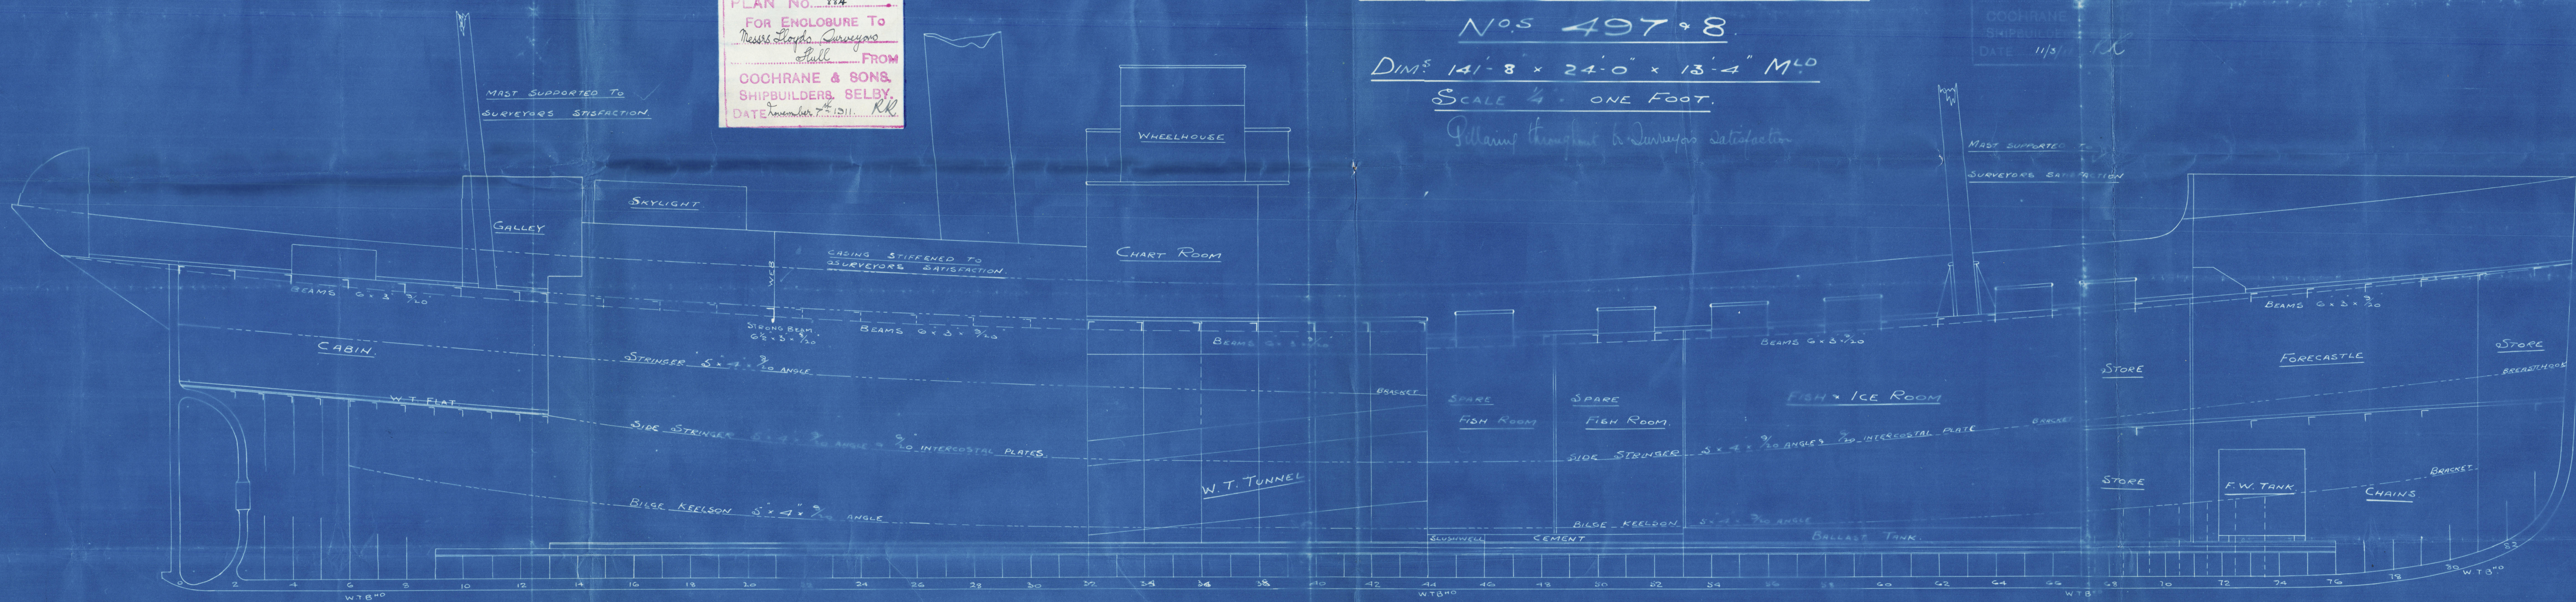

Pillars throughout to Surveyors Satisfaction.

C.B.
16.3.11.

Cochran & Sons

No. ~~447~~ - ~~495~~

Copy of
Profile & Deck Plan

Same as
s/s ~~Drypool~~
Hull Report no. 24460

Copy

Lt. Sutton

RETAIN



© 2021

W59 - 0123

Lloyd's Register
Foundation