

PLAN No. 885
 FOR ENCLOSURE TO
 Messrs Lloyd's Surveyors
 Hull FROM
 COCHRANE & SONS,
 SHIPBUILDERS, SELBY.
 DATE November 7th 1911. *KK*

MIDSHIP SECTION

N^{os} 497 + 8


STEEL SCREW TRAWLER.

DIMS 141'-8" x 24'-0" EXTREME x 13'-4" M^LD

SCALE 1/2" = ONE FOOT.

PLAN No 99
 FOR ENCLOSURE TO
 Messrs Lloyd's Surveyors
 Hull FROM
 COCHRANE & SONS,
 SHIPBUILDERS, SELBY.
 DATE 11/8/11 *KK*

TO CLASS 100 A1 AT LLOYDS FOR FISHING
 PURPOSES. DECK PLATED OVER IN WAY OF
 MACHINERY SPACE. ENGINE & BOILER CASING.
 AS PREVIOUSLY APPROVED

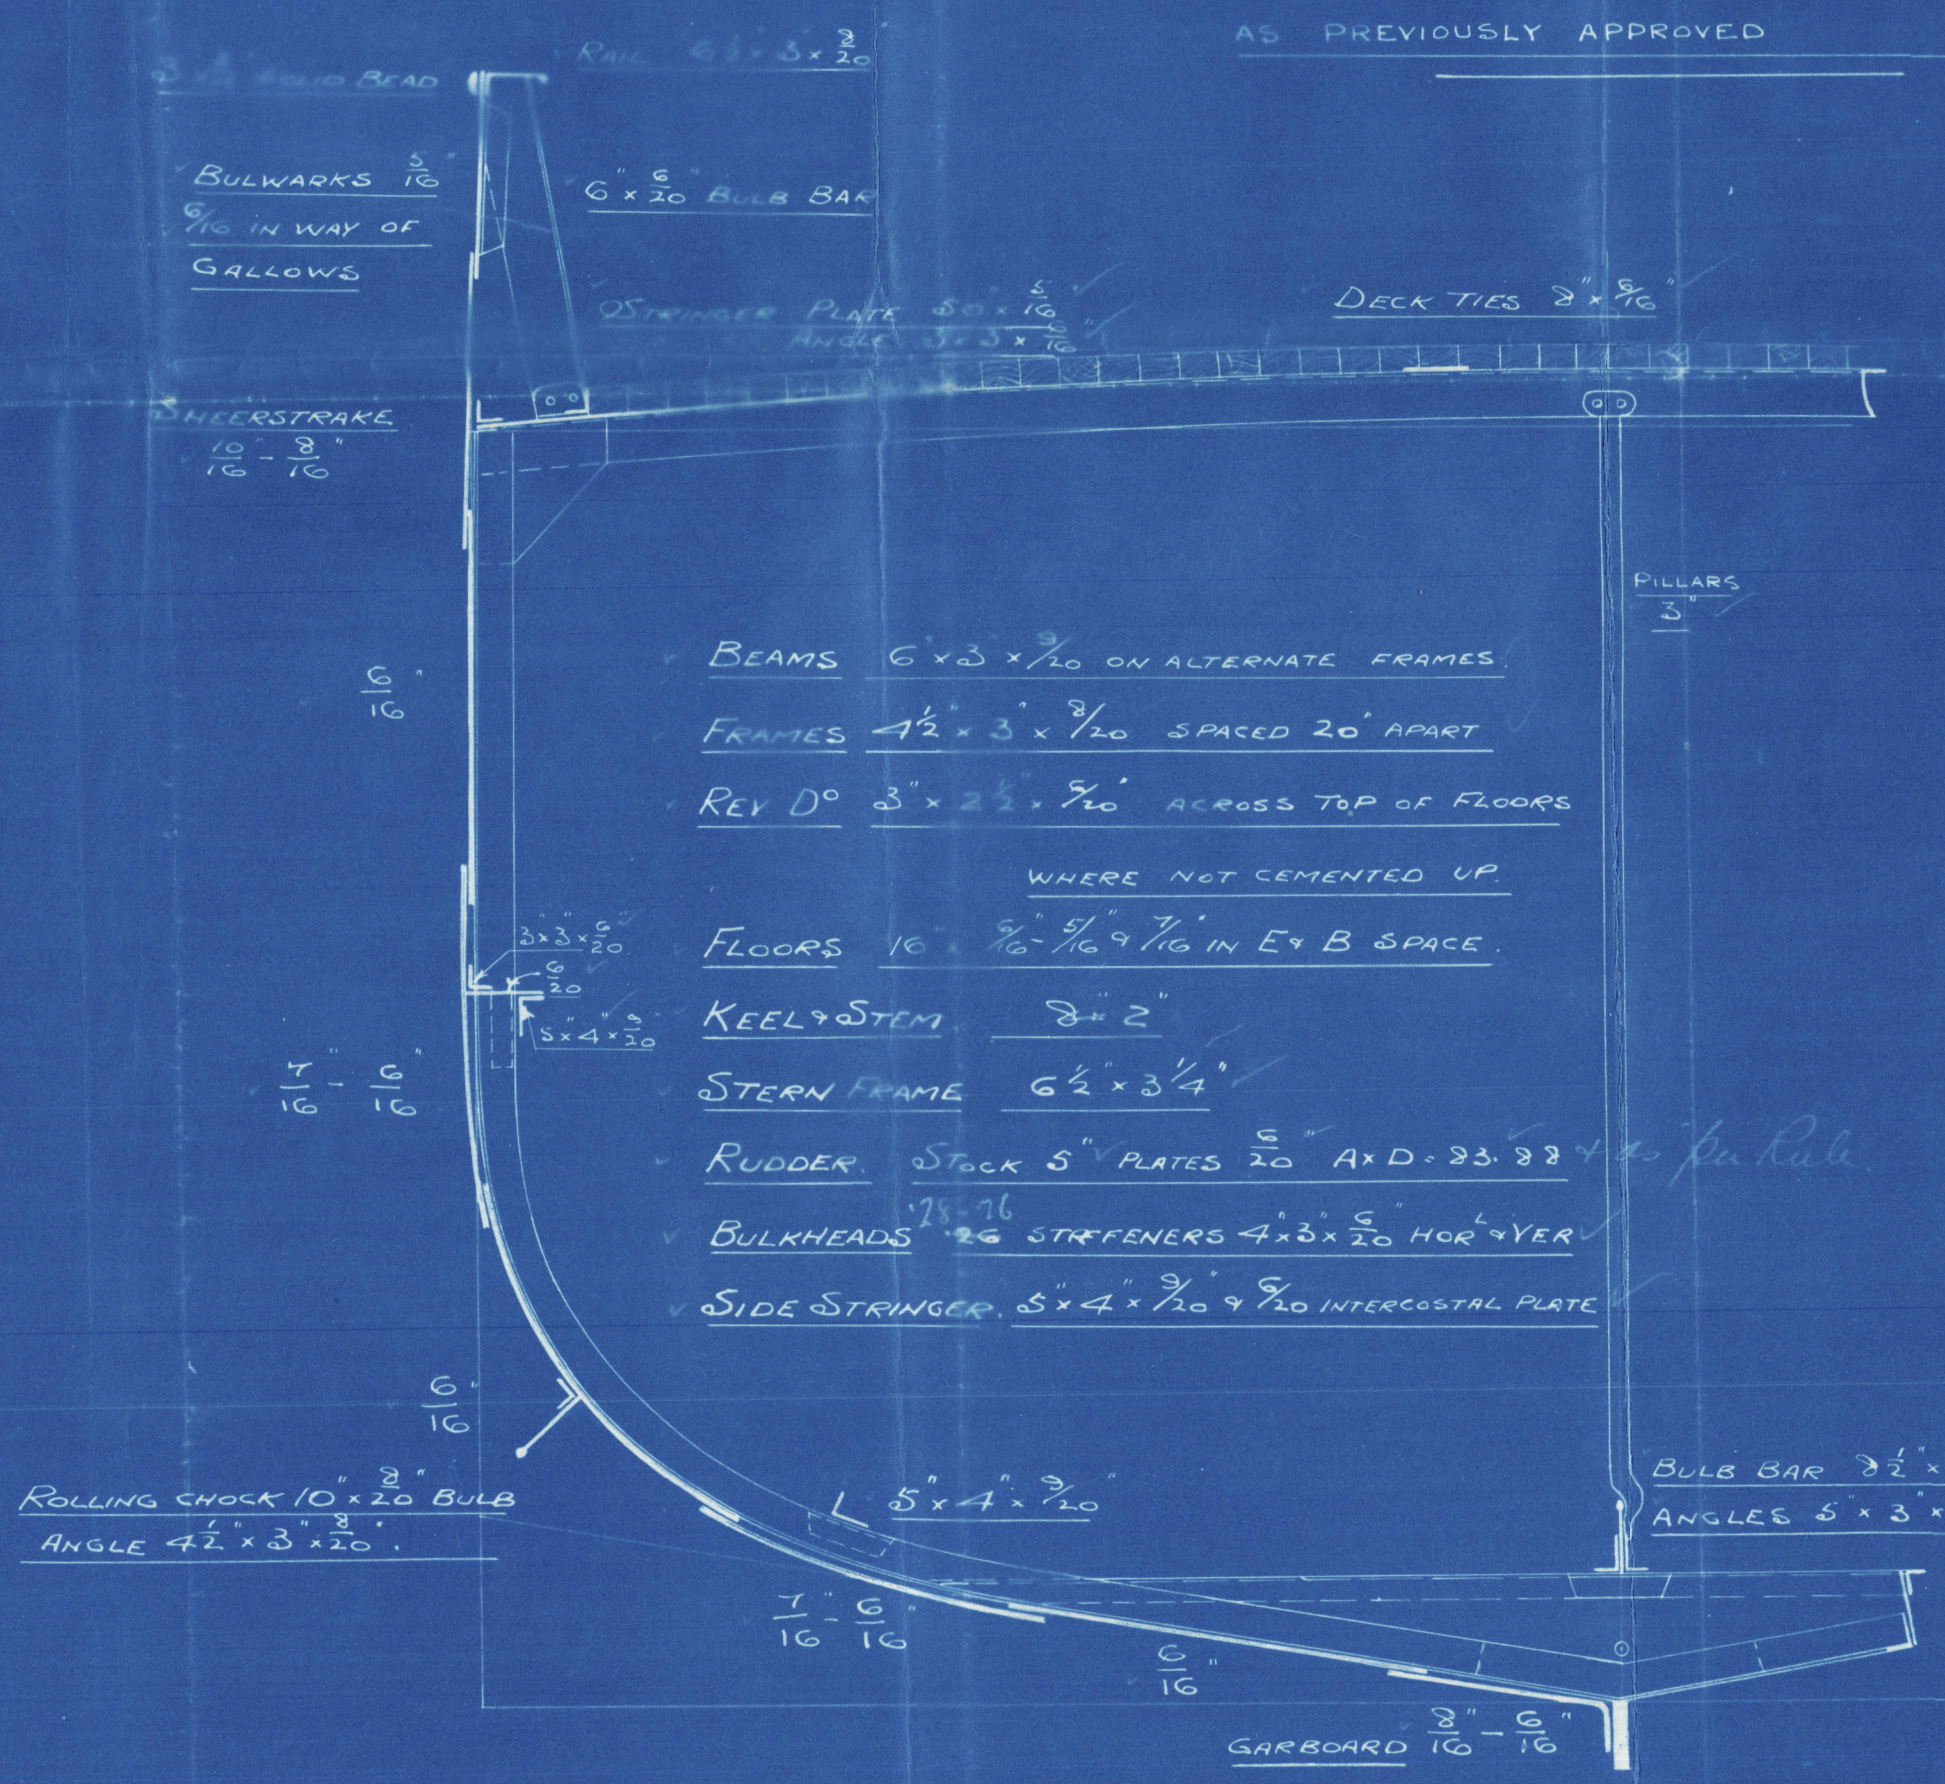

NUMERALS.

B + D = 37.20
 L x (B + D) = 5269.75
 EQUIPMENT N^o 5203

PROPORTIONS.

L/D = 10.6
 L/B = 5.9

EQUIPMENT.

1 ST BOWER ANCHOR	8 1/4 CWTs STOCKLESS
2 ND " "	7 1/2 " " "
KEDGE " "	3 1/4 " EX STOCK
120 FATHOMS	1 1/8" CABLE
60 " "	6" HAWSER
60 " "	5" WARP

RIVETING.

BUTTS OF SHELL PLATING TO BE LAPPED AND
 DOUBLE RIVETED, EXCEPT GARBOARD AND
 SHEERSTRAKE, WHICH ARE TO BE STRAPPED &
 DOUBLE RIVETED. ALL LANDINGS TO BE
 DOUBLE RIVETED, BULWARKS SINGLE RIVETED


Cochran & Sons

No ~~497~~ 498

Copy of
Midship Section.

Same as
~~of Drypool~~
~~Hull Rph~~ No ~~24460~~

^u S. Sutton
^u Hull 24446

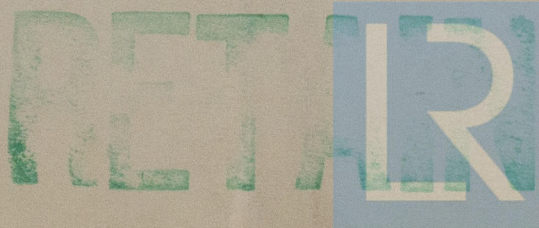

© 2021

Lloyd's Register

Foundation 0124