
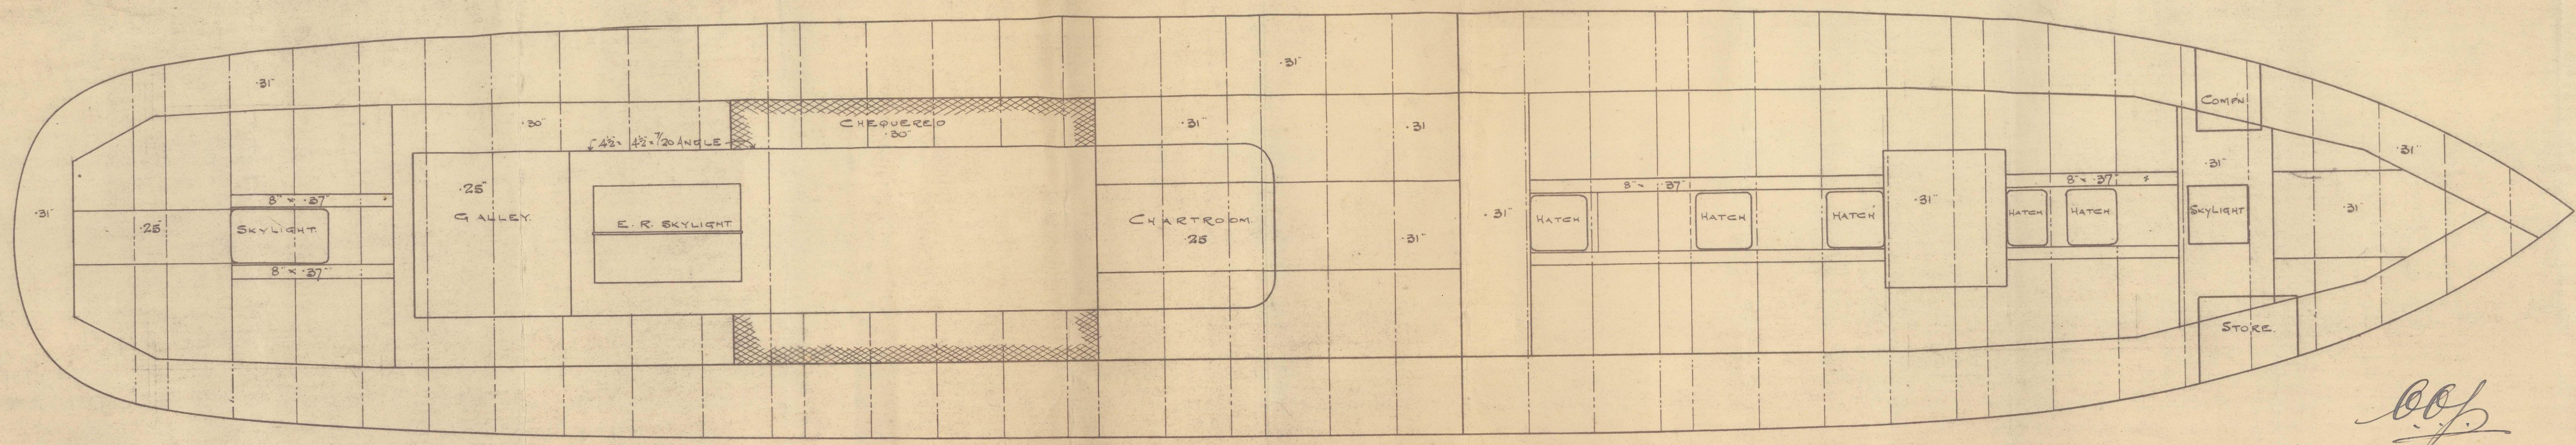


20.5.14

PLAN No. 1320
FOR ENCLOSURE TO
MESSRS LLOYD'S SURVEYORS
HULL FROM
COCHRANE & SONS, LTD.
SHIPBUILDERS, SELBY
DATE 13/5/14

PROFILE & DECK PLAN
STEEL SCREW TRAWLER
No 614
TO CLASS 100 A.1. STEAM TRAWLER
DIMS: 125'-0" B.P. x 22'-3" EXT. x 12'-9" MLD.

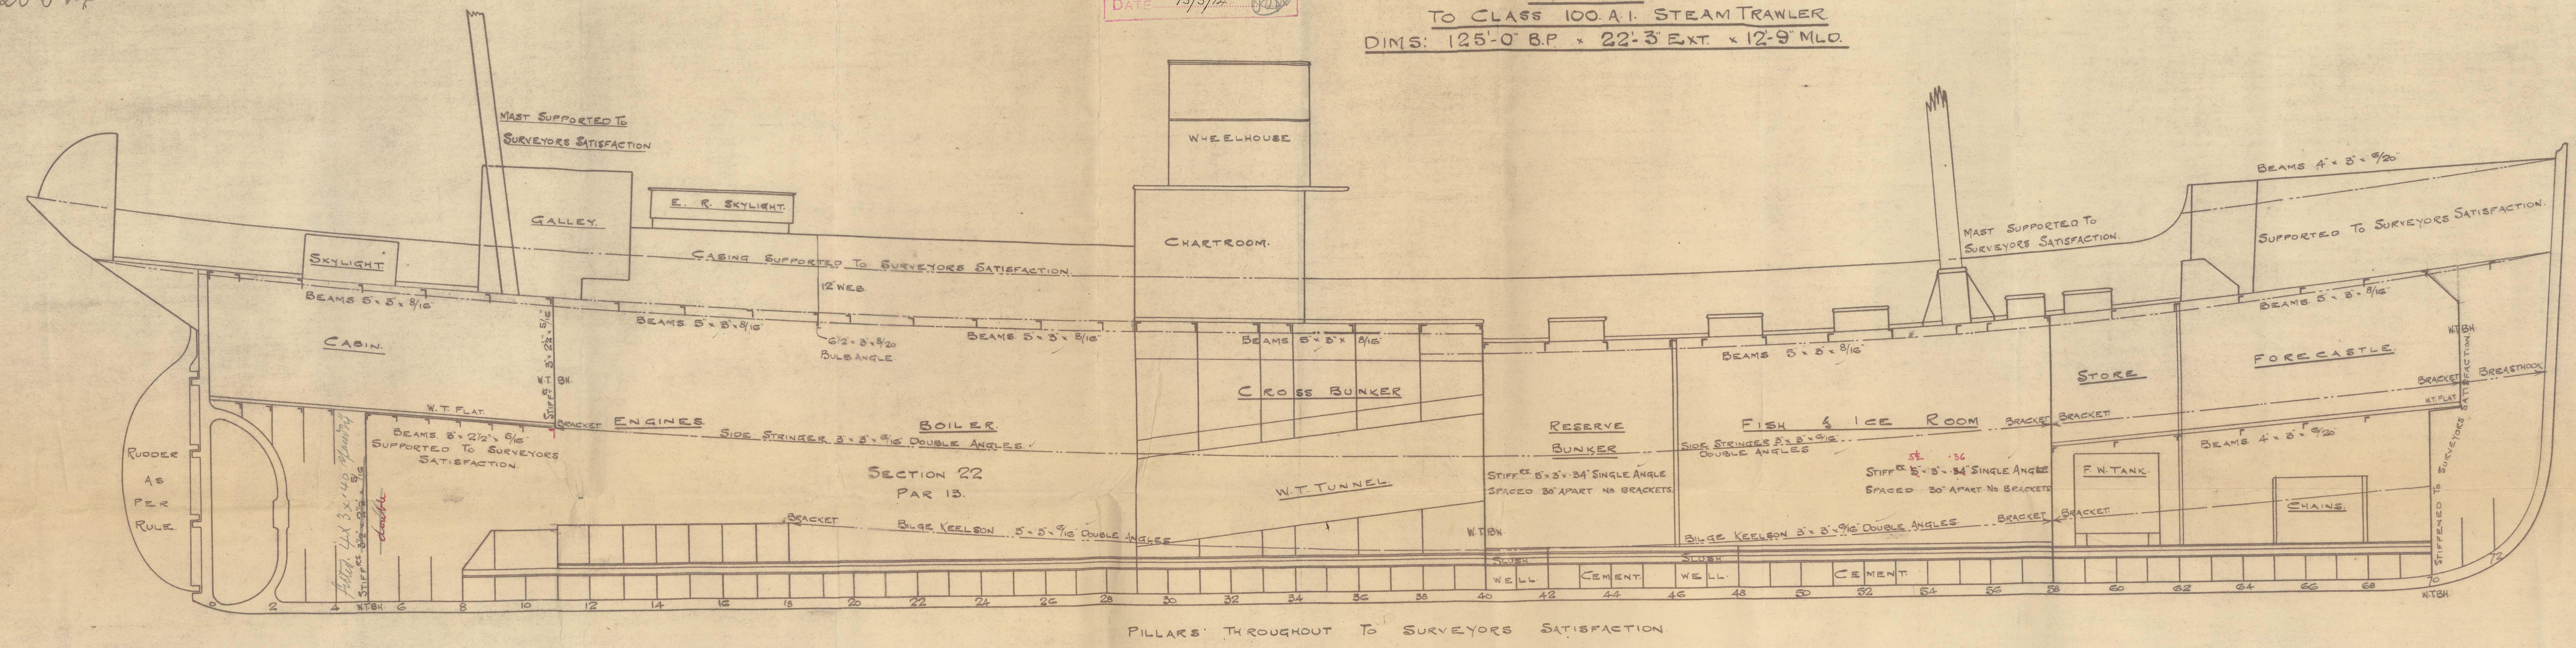

60/6
20.5.14

Profile & Deck.

Cochrane's No. 4.

RETAIN



Sp "Jaipo" Hull Rpt. No 28225

RETAIN



© 2021

Lloyd's Register
Foundation

W760-0070