

# MIDSHIP SECTION

## SSN<sup>OS</sup> 385-6

SCALE 1/2" = 1 FOOT

DIM<sup>S</sup> LENGTH 127'0" BREADTH 22'0" DEPTH OF HOLD 11'3" DEPTH M<sup>AD</sup> 12'6"

E & B CASING AS PREVIOUSLY APPROVED

DECK PLATED OVER IN WAY OF E & B CASING

### NUMERALS AS PER RULES

1/2 BREADTH	=====	10.95
1/2 GIRTH	=====	19.75
DEPTH	=====	12.95
		43.65 1 <sup>ST</sup> NO

LENGTH AS PER RULE 125.87

54942255.2<sup>ND</sup> NO

### PROPORTIONS

BREADTHS TO LENGTH	=====	5.70
DEPTH " " "	=====	9.7


### EQUIPMENT

1 <sup>ST</sup> BOWER	5 1/2" CWS EX STOCK	7-1-0
2 <sup>ND</sup> BOWER	"	7-1-0
3 <sup>RD</sup> BOWER	2 3/4" " " "	"
105 FATHOMS	1 1/6" SHORT LINK CABLE	"
60 "	6 HAWSERS	"
60 "	4 1/2" WARP	"

COCHRANE & SONS

SHIPBUILDERS

BELBY

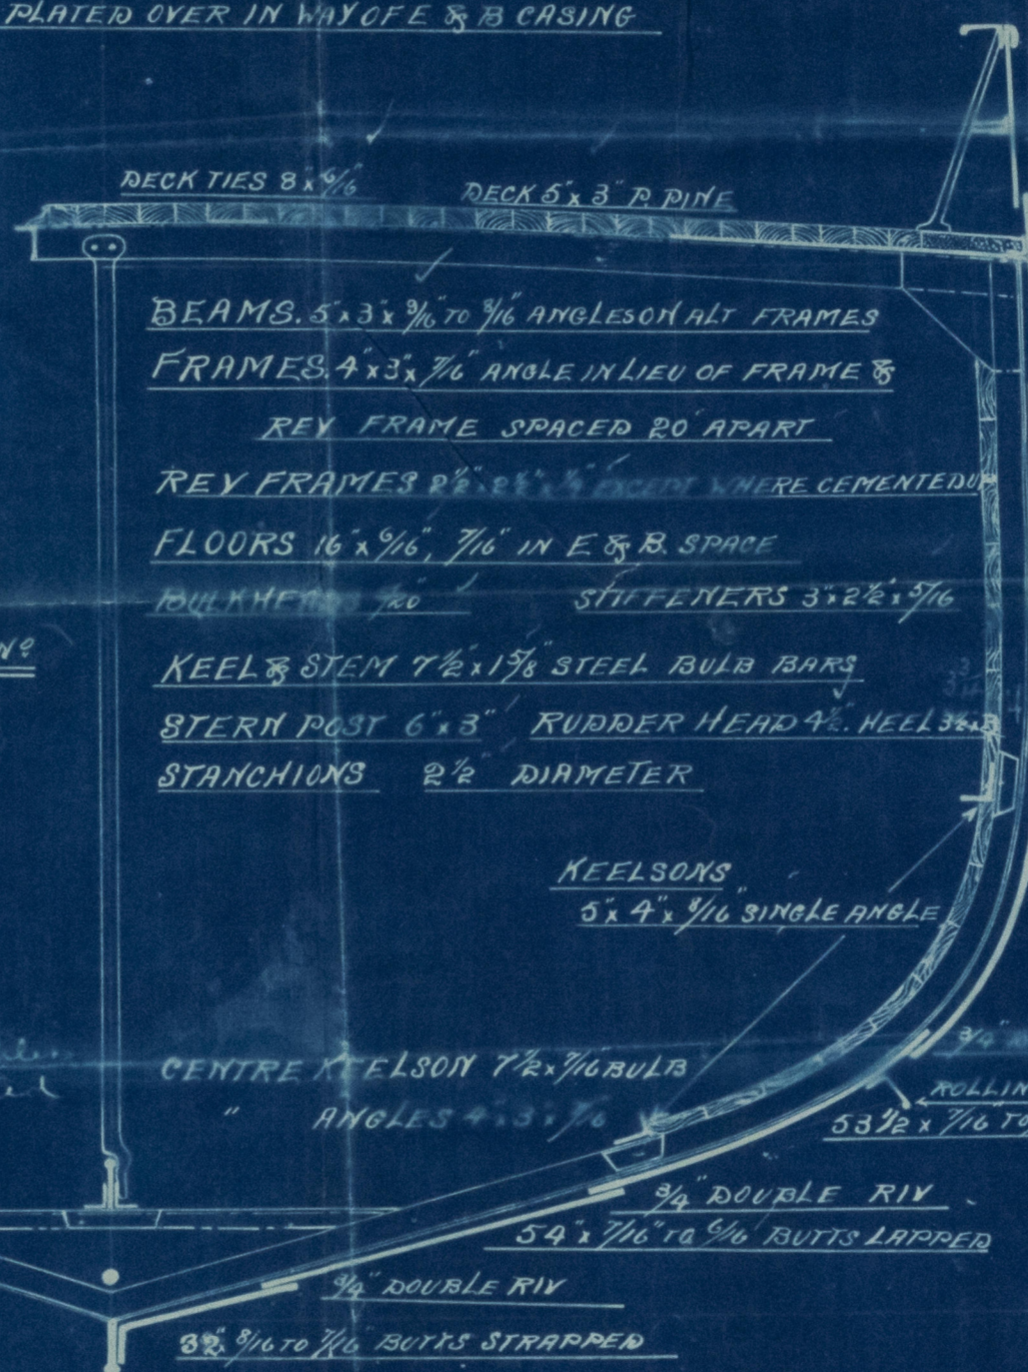

RAIL 6 1/2 x 3 x 1/4" BULB ANGLE

BULWARKS 7/8 x 1/4" IN WAY OF GALLEYS

SINGLE RIV LAP

3 x 3 x 1/4" STRINGER ANGLE

STRINGER PLATE 50 x 1/4 TO 30 x 1/4"

SHEER STRAKE 31 x 1/4 TO 1/4"

BUTTS STRAPPED & DOUBLE RIV

54 x 1/4 TO 1/4" BUTTS LAPPED

3/4" DOUBLE RIV

51 x 1/4 TO 1/4" BUTTS LAPPED

LLOYD'S REGISTER  
OF SHIPPING  
11 MAR 1907  
\* HULL \*

LR

Eochram & Son

- No 386 -

s/s Ugadale

Hull Report No. 18795



RETAIN



© 2021

Lloyd's Register  
Foundation

W761-0091