


AT BOTTOM OF C. CHAMBER BACKS.

Attention to satisfy the
requirements of Hamburg Board of Police

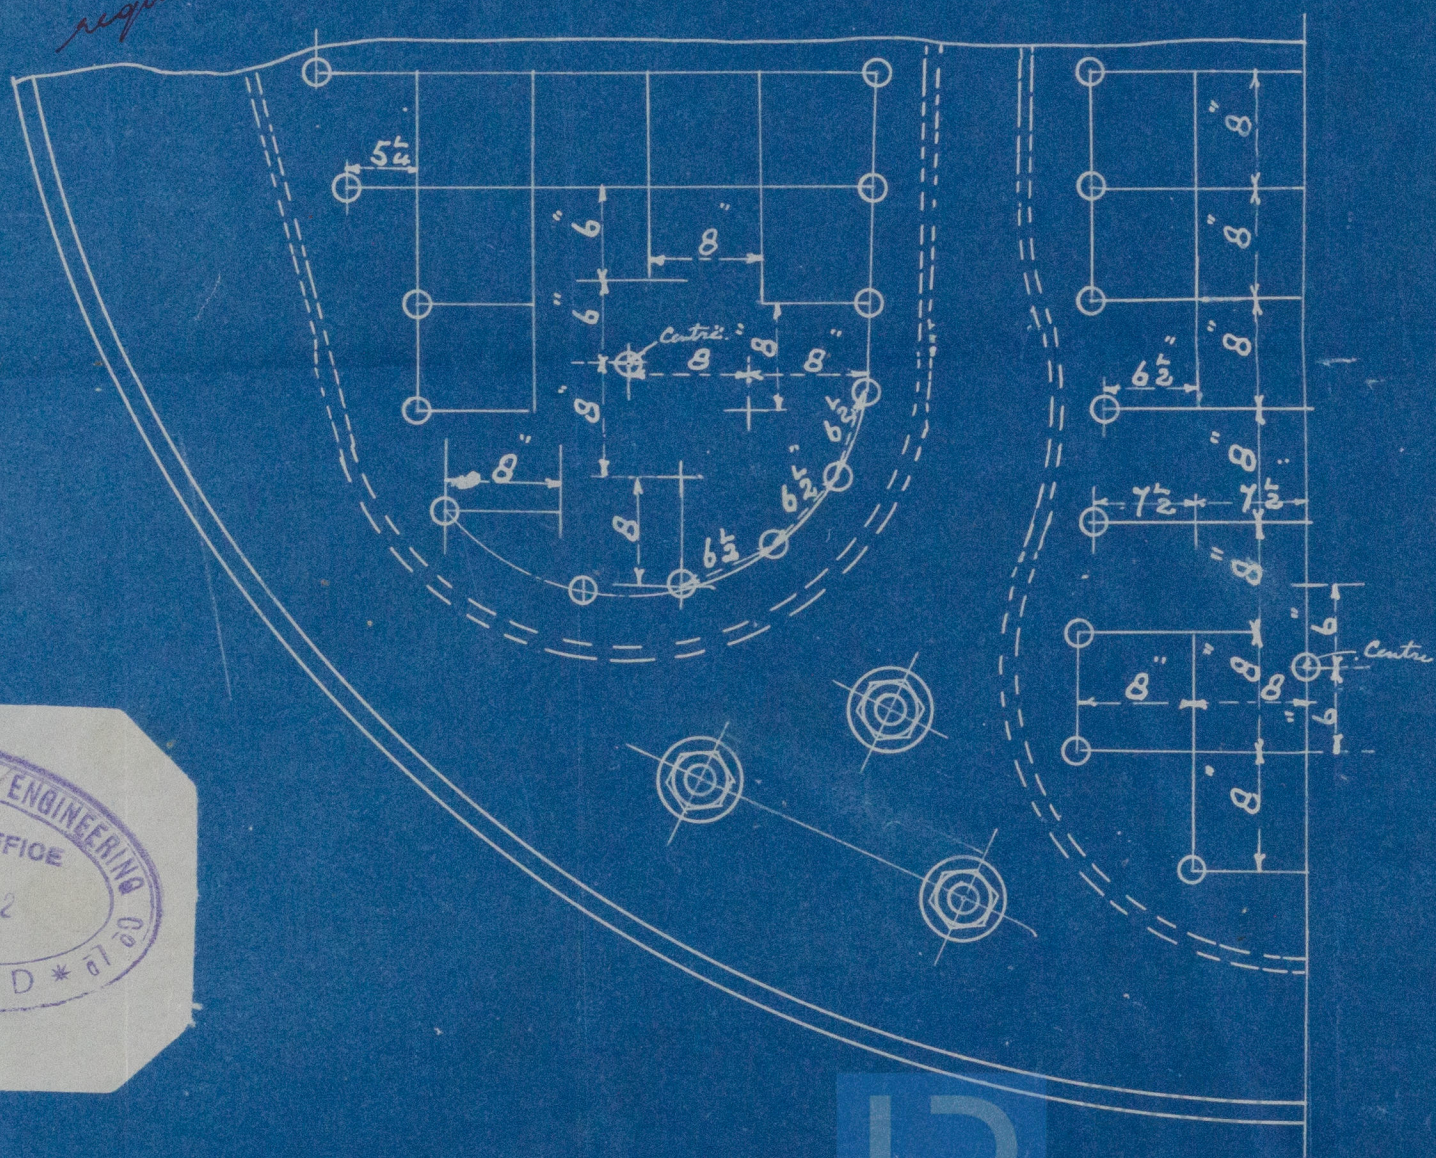

CONTRACT. 2037.

S.S. "Clo"

Num 62138



© 2021

Lloyd's Register
Foundation

W763-0109

[Handwritten signature in red ink]