

5-12-10

PLAN No. 9814
FOR ENCLOSURE TO
Messrs Lloyd's Surveyors
Hull FROM
COCHRANE & SONS,
SHIPBUILDERS, SCOTLAND
DATE 29/11/10 *KL*



PROFILE & DECK PLAN

STEEL SCREW TRAWLERS

No. 485-6

DIM^s — 125'-0" B.P. x 22'-0" Ex. x 13'-0" M.D.

SCALE 1/4" = 1 Foot.

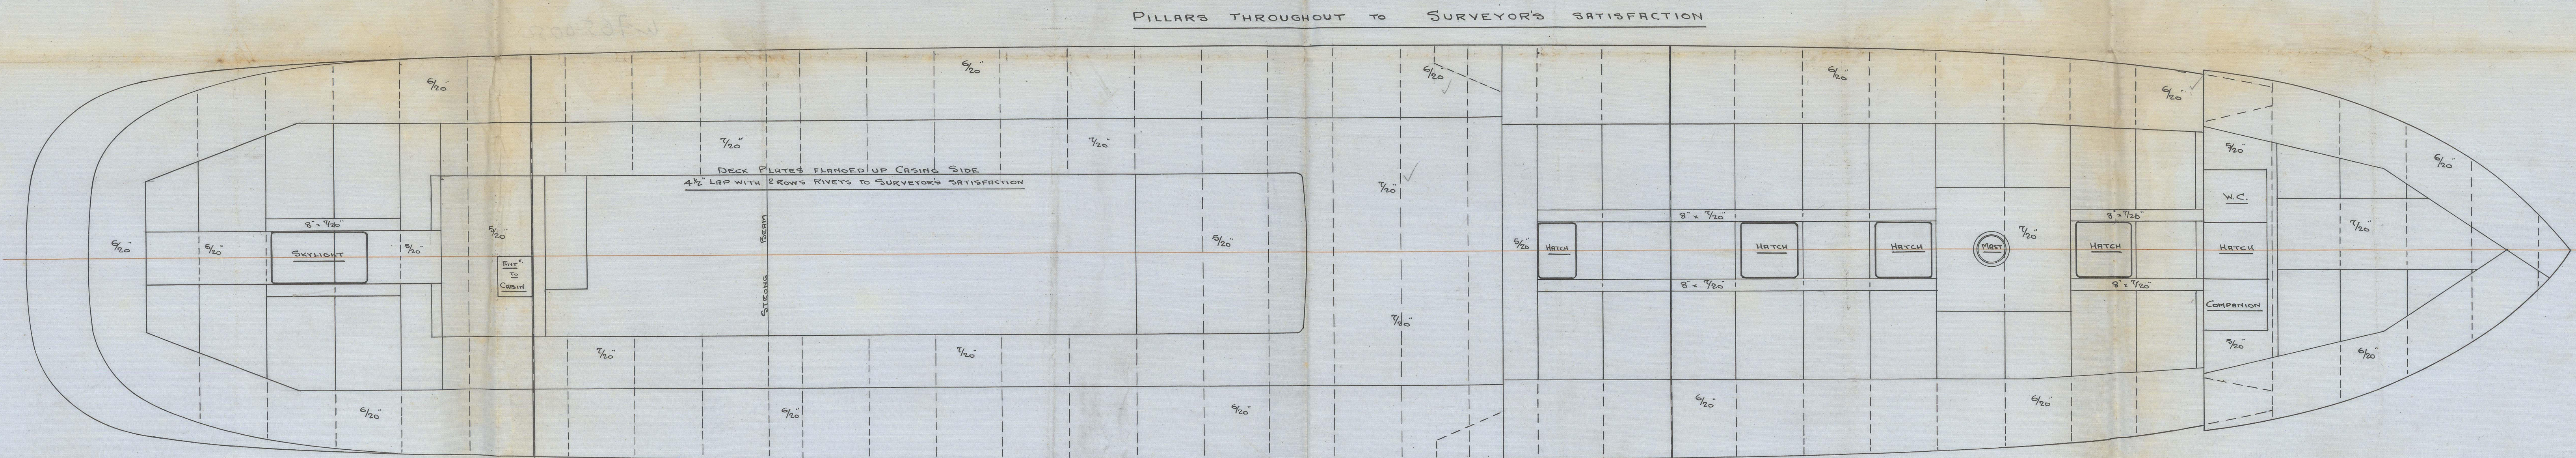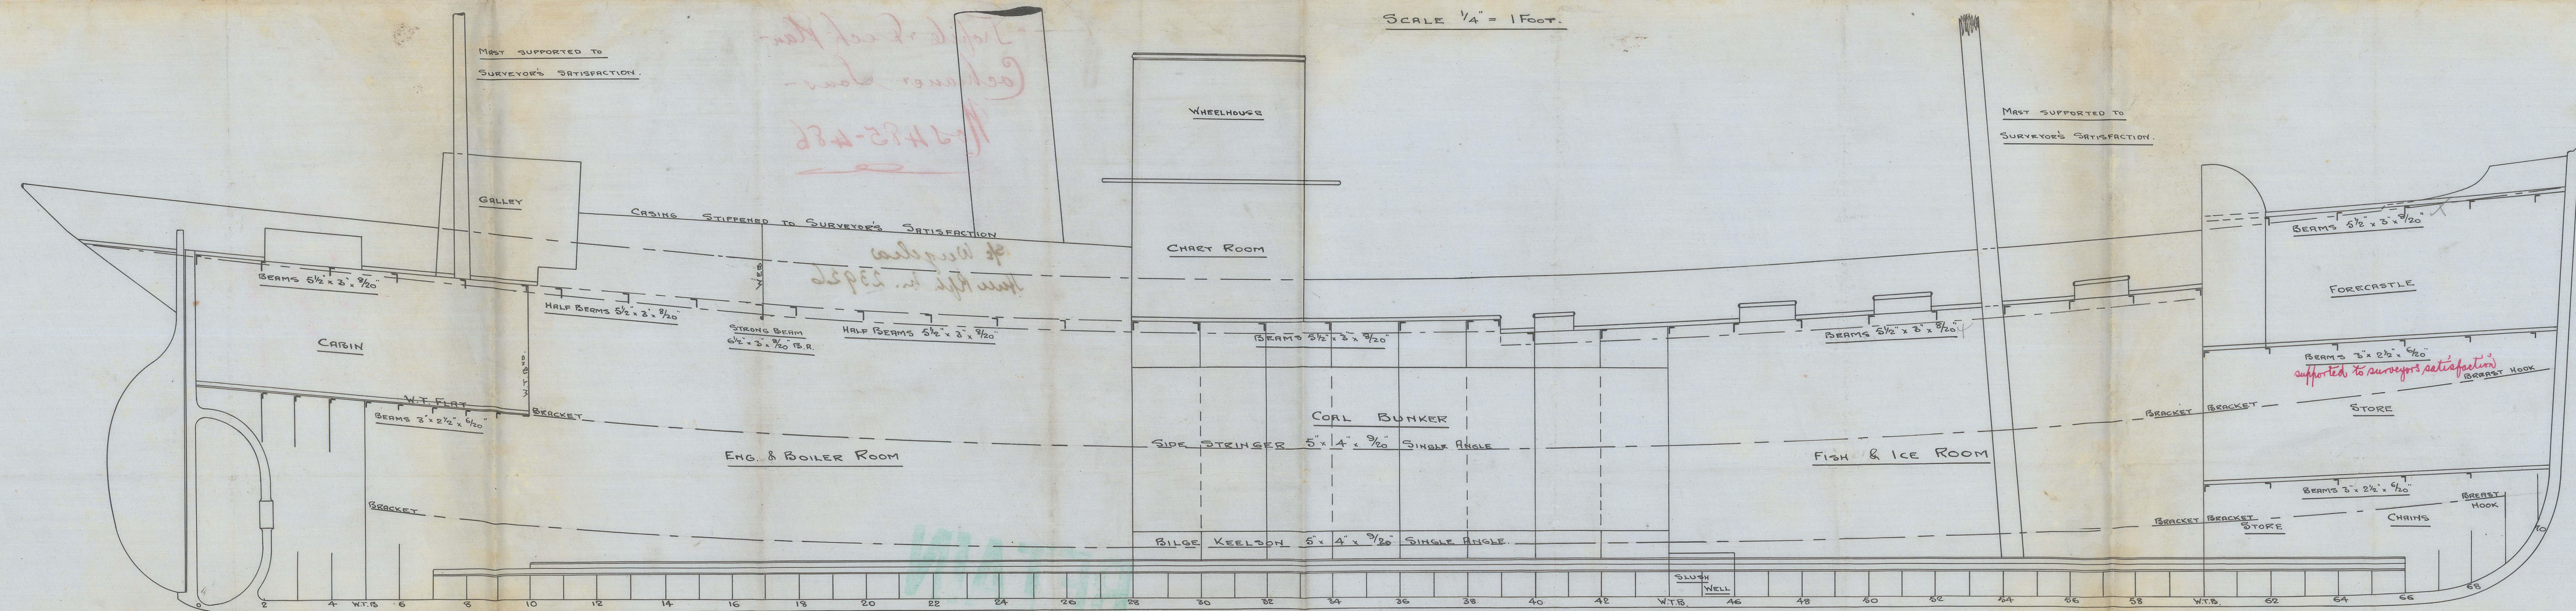

C.J.
5-12-10.

- Profile & Deck Plan
Cochran & Sons -
Nos 485-486

$\frac{3}{4}$ Wuzle
Spec Rpt. No. 23926

RETAIN



© 2021

Lloyd's Register
Foundation

W 765-0032