

5.12.10

PLAN No 7813.
FOR ENCLOSURE TO
Messrs Lloyd's Surveyors
HULL FROM
COCHRANE & SONS.
SHIPBUILDERS, SEVEN
DATE 28/1/10 RK

MIDSHIP SECTION

STEEL SCREW TRAWLERS

N^{OS}. 485-6

DIM^S. - 125'-0" B.P. x 22'-0" EX. x 13'-0" M^{LD}.

SCALE 1/2" = 1 FOOT.


TO CLASS 100.A.1. FOR FISHING PURPOSES. DECK PLATED OVER
IN WAY OF MACHINERY SPACE. ENGINE & BOILER CASING
AS PREVIOUSLY APPROVED.

3" x 1 1/2" HOLLOW BEAD
BULWARKS 5/16" &
1/20" IN WAY OF GALLIOWS

SHEERSTAKE 33" x 3/16" & TO
TAPER TO 3/16" FOR 8" & 3/16" AFT.

3/20" F. & A.

ROLLING CHOCKS 55'-0" MIDSHIP
7" x 3" x 3/20" SINGLE BULB ANGLE

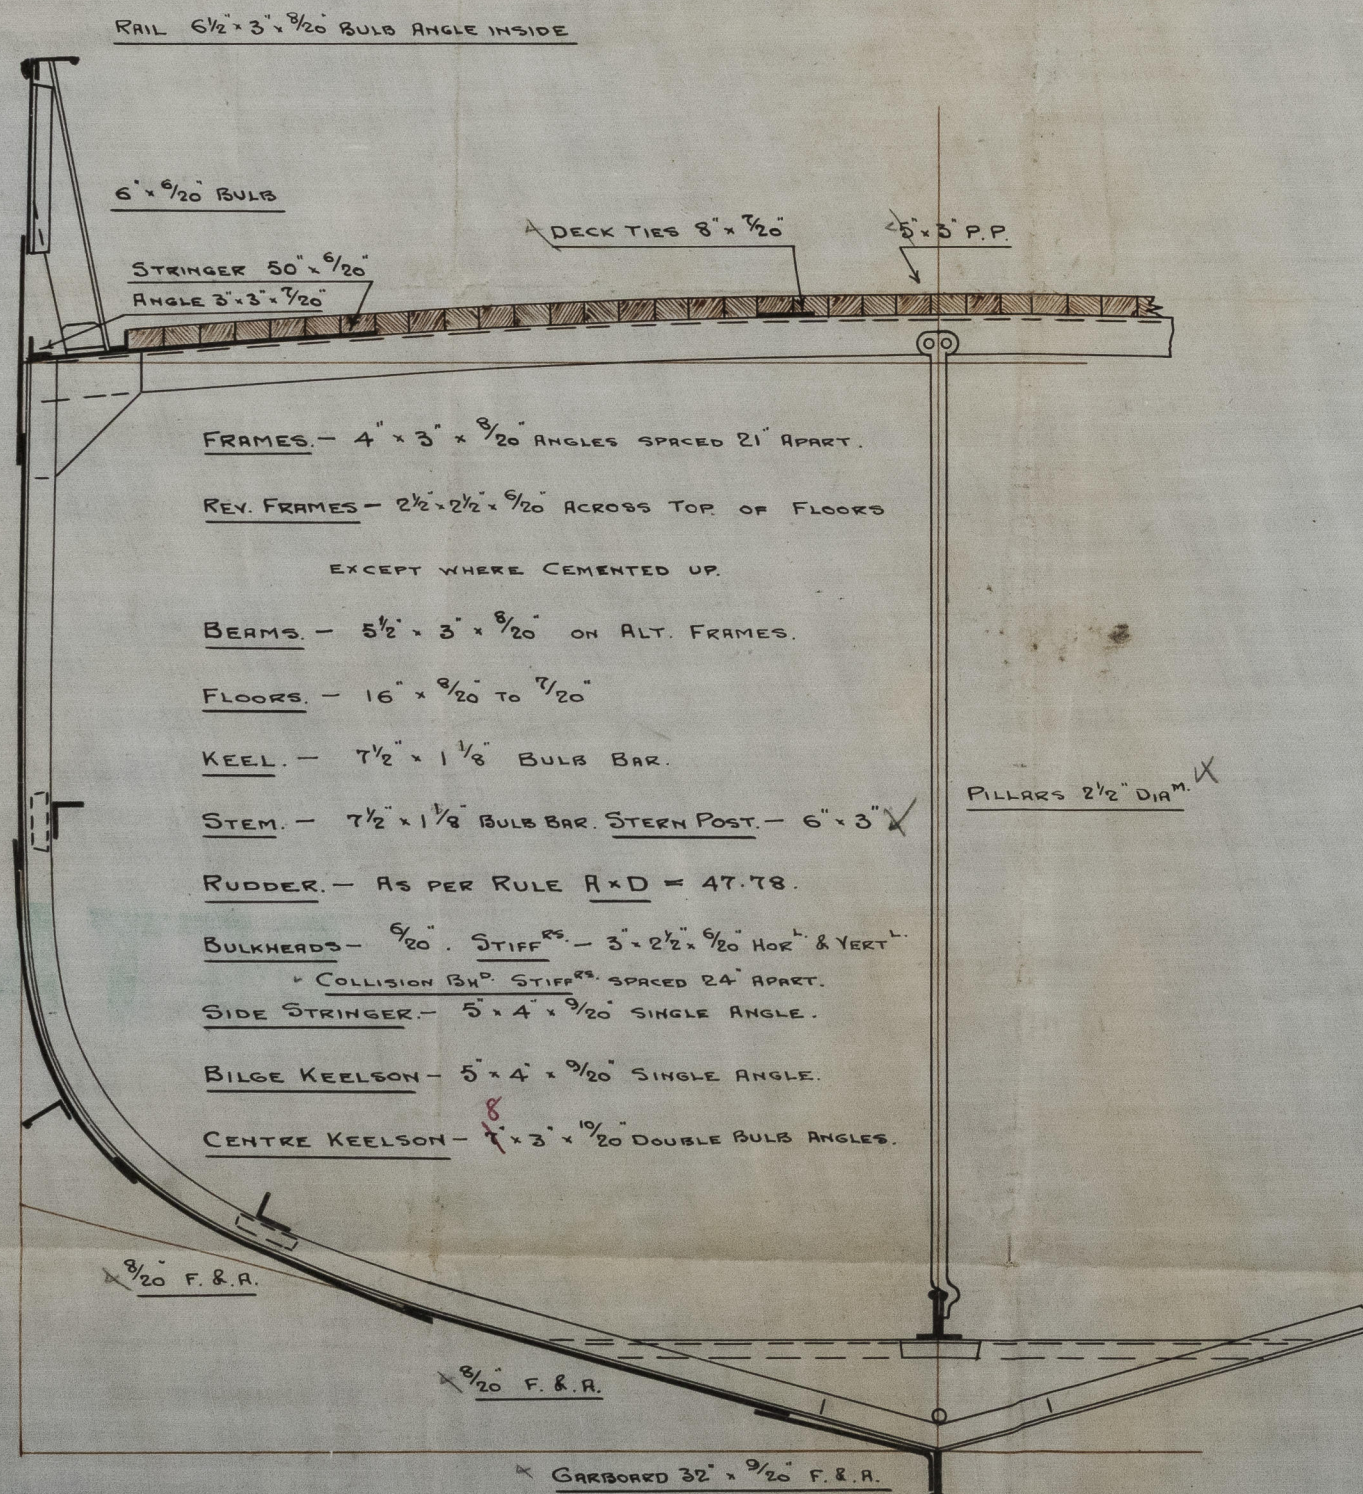

NUMERALS

$$B + D = 34.87 \checkmark$$

$$L \times (B + D) = 4358.7 \checkmark$$

PROPORTIONS

$$\frac{L}{D} = 9.6 \checkmark$$

$$\frac{L}{B} = 5.7 \checkmark$$

EQUIPMENT

1 ST BOWER ANCHOR	5 1/2" CWT. EX STOCK
2 ND "	5 " "
KEDGE ANCHOR	2 3/4 " "
105 FATHOMS	1 1/6" CABLE
60 "	6" HAWSER.
60 "	4 1/2" WARP.

RIVETING

BUTTS OF SHELL PLATING LAPPED & DOUBLE RIVETED EXCEPT GARBORD
& SHEERSTAKE WHICH ARE TO BE STRAPPED & DOUBLE RIVETED.
LANDING EDGES DOUBLE RIVETED, EXCEPT TOP EDGE OF SHEERSTAKE
WHICH IS TO BE SINGLE RIVETED. BUTTS OF STRINGER & TIE PLATES
OVERLAPPED & DOUBLE RIVETED.

Butts of shell plating to be treble riveted
where strakes are over 54" in width

C.F.
5.12.10.

- Midship Section -
Cochranes Sons

Nos 485-486

5/ *Wegelia* Hall Rm 223926
- *Xylophia* - - -

✓ 765-0033