


14.12.05
1.1.06

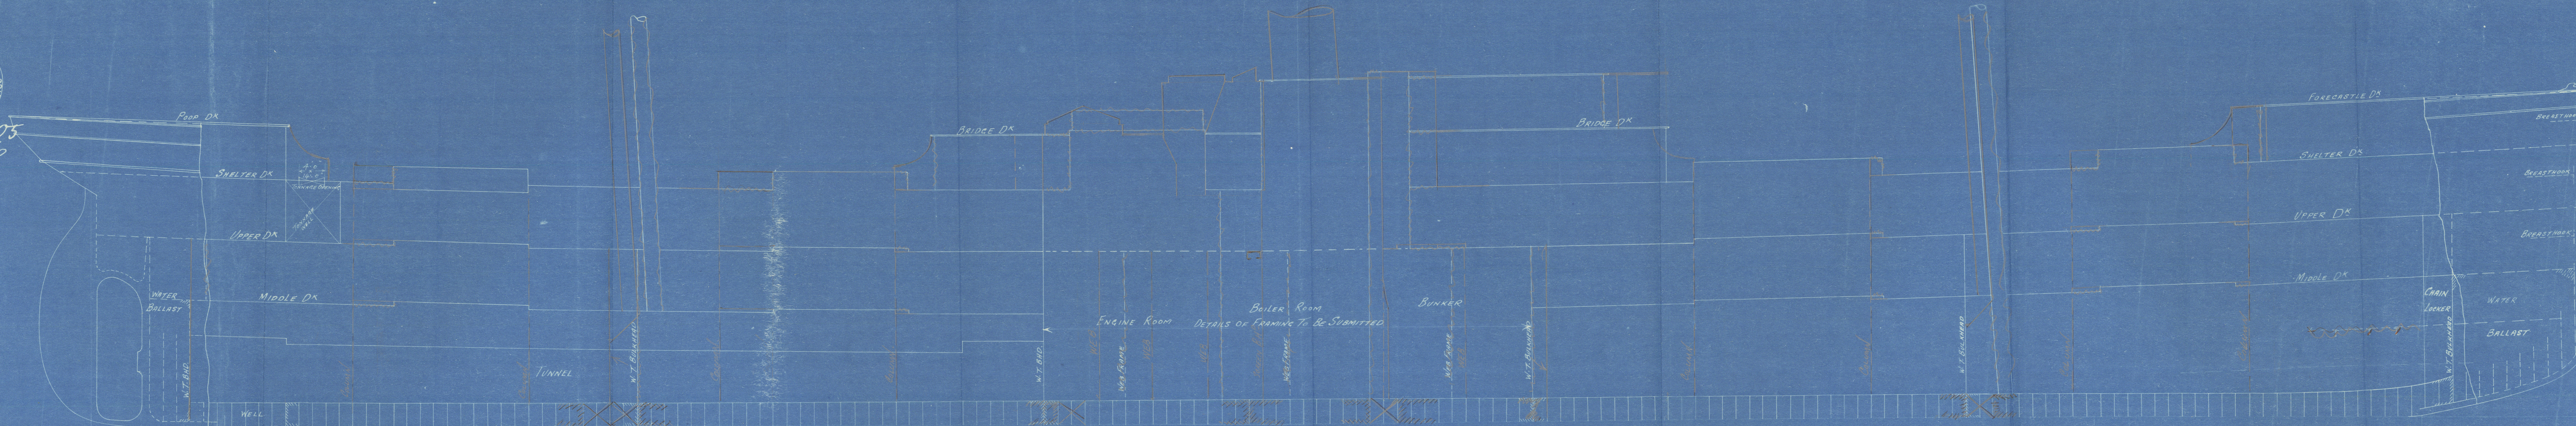

BULB ANGLE FRAMES
 $6\frac{1}{2} \times 3\frac{1}{2} \times \frac{11}{20}$

FRAMES BULB ANGLE
 $7\frac{1}{2} \times 3\frac{1}{2} \times \frac{20}{10}$

BULB ANGLE FRAMES
 $7\frac{1}{2} \times 3\frac{1}{2} \times \frac{22}{20}$

LONGITUDINAL ELEVATION
PROPOSED S.S. 370' x 49' x 25'-4" (KEEL TO BEAMS)

SCALE $\frac{1}{8}" = 1 \text{ FOOT}$

Nos 38384

BULB ANGLE FRAMES
 $7\frac{1}{2} \times 3\frac{1}{2} \times \frac{20}{10}$

BULB ANGLE FRAMES
 $7\frac{1}{2} \times 3\frac{1}{2} \times \frac{20}{10}$

BULB ANGLE FRAMES
 $6\frac{1}{2} \times 3\frac{1}{2} \times \frac{11}{20}$

Messrs Harland & Wolff

S.S. 384

Profile Plan

S.S. Sierra Leone

Bel 6250

Duplicate of

S.S. Aburi

Bel 6240

Copy

RETAIN

LR

© 2020

W768 0018 Lloyd's Register
Foundation