


T.S.S. RODNEY STAR

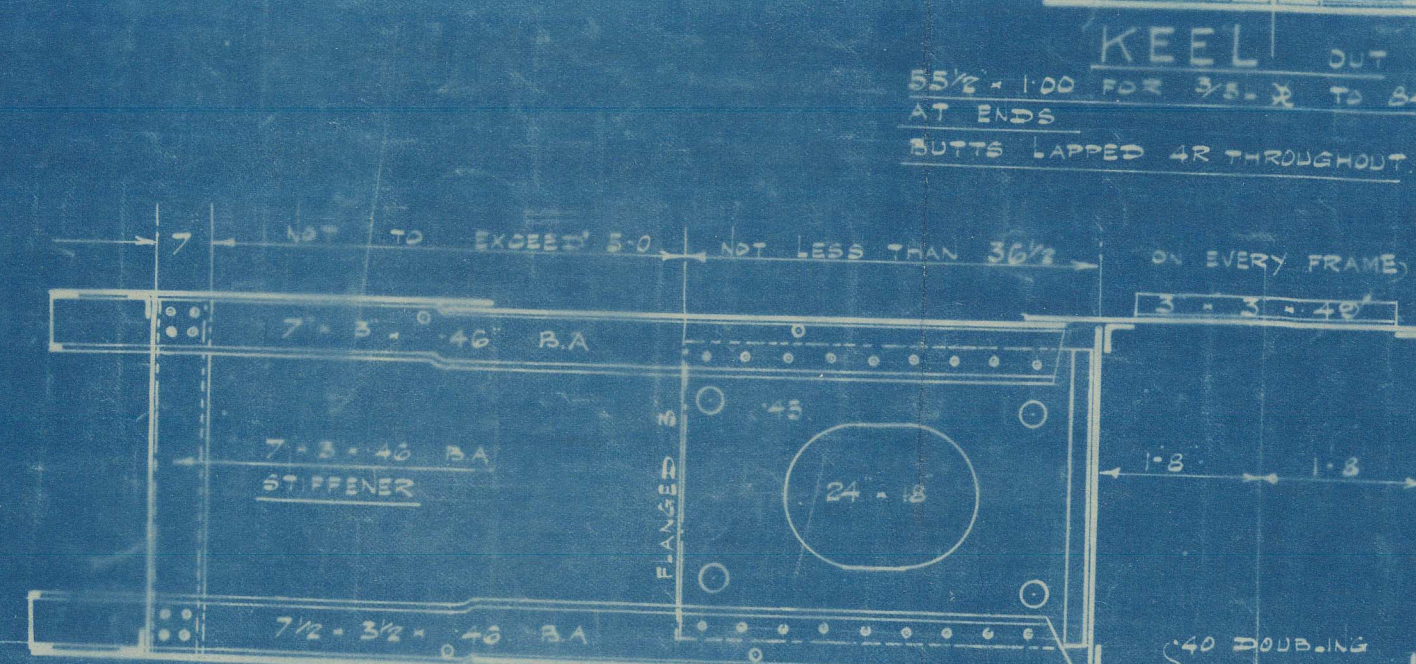

LITHGOWS LTD

No 785.

T. S. S. "RODNEYSTAR"

MIDSHIP SECTION (AS BUILT).

Gk Rep No 18643.

WTI-0164



© 2020

Lloyd's Register
Foundation