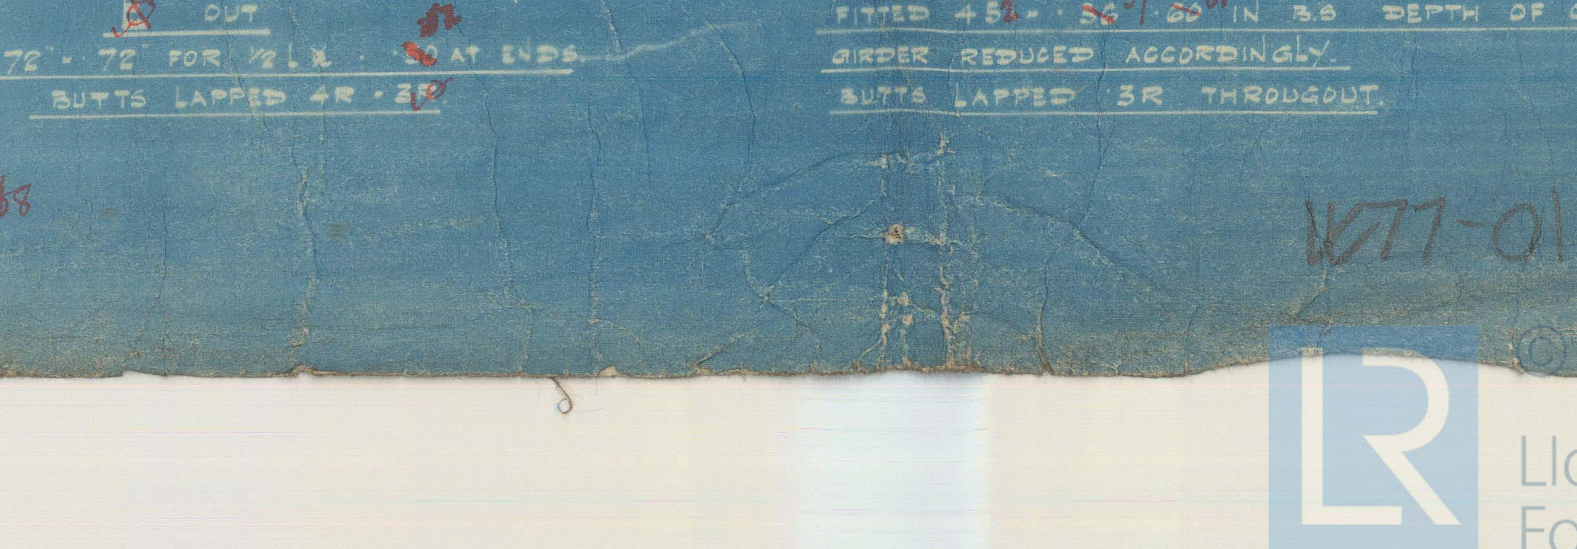
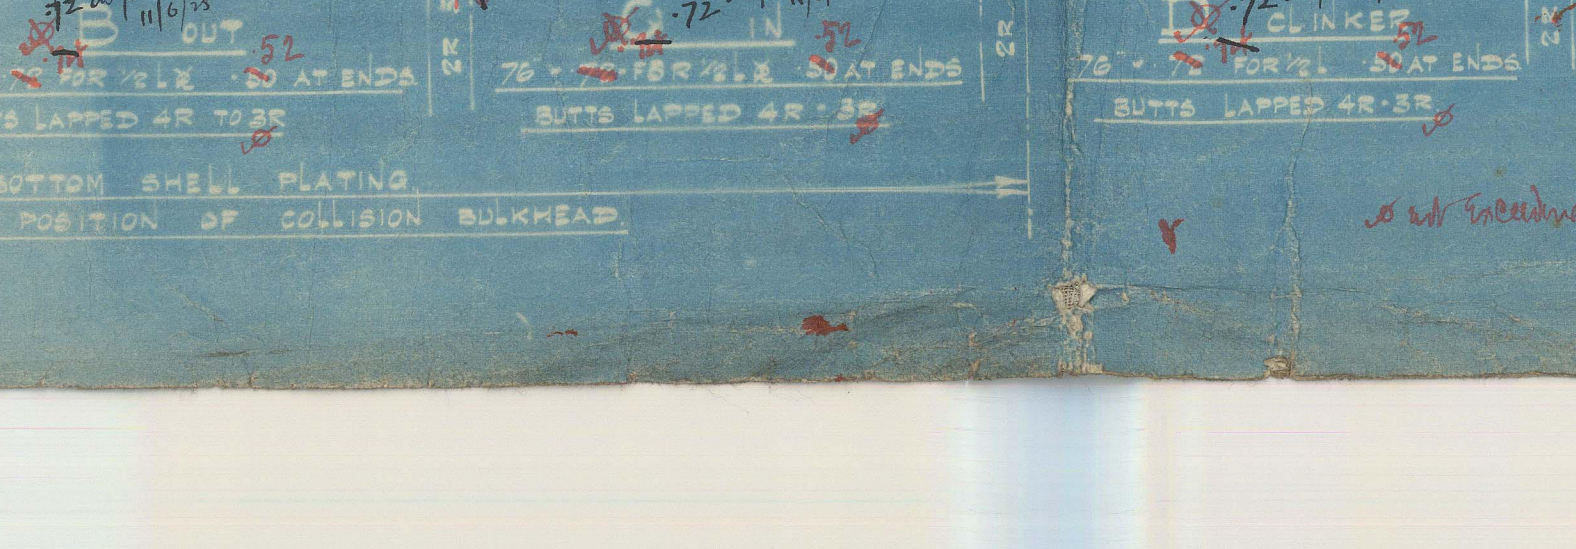
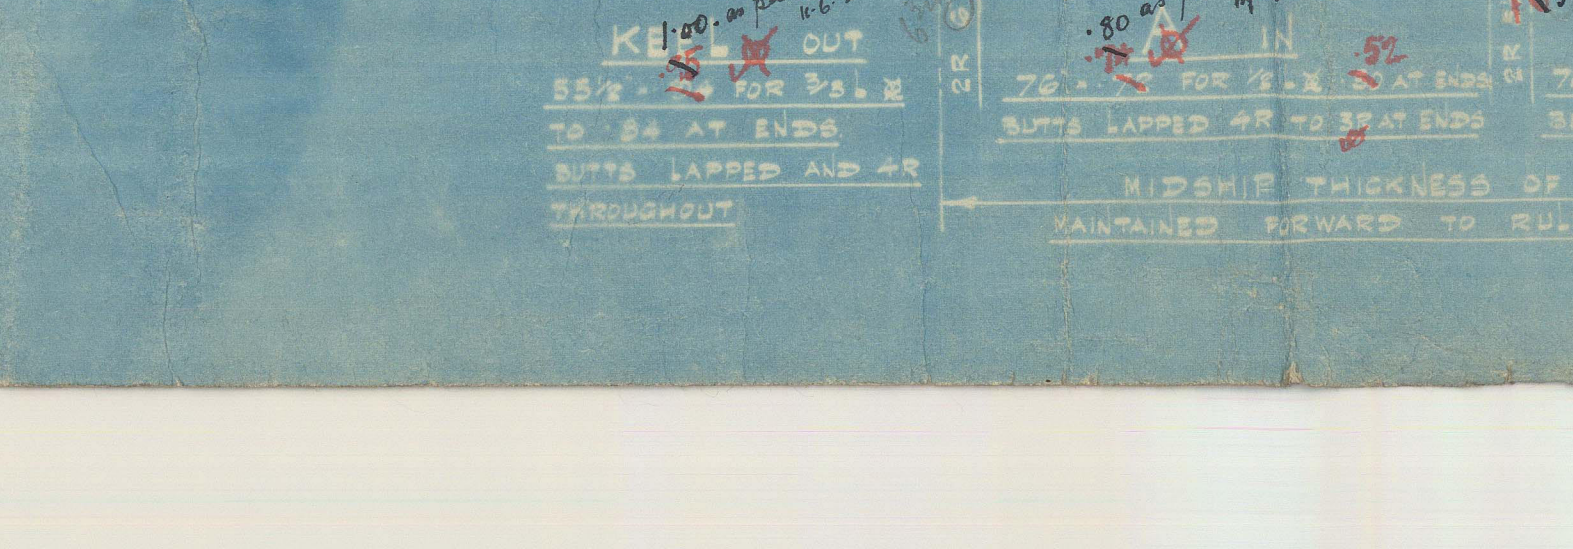


T.S.S. N^o 785-6

[illegible]

MIDSHIP SECTION

LITHGOWS L^R

Nos 785-6

185

RODNEY STAR

GRK REPORT No 18643

~~186~~

NAPIER STAR

GRK REPORT No 18668

W77-0165




© 2020

Lloyd's Register
Foundation

785/6

W77-0165

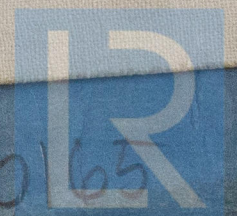

© 2020

W77-0165

Foundation