


— S.S. No 273 —
 — PROFILE & DECK PLAN —
 — DIMS: 182'-0" x 29'-0" EXT. x 14'-0" MLD —
 — SCALE 1/8" = 1 FOOT —

122
 P.W. P.W.
 8/10/14

27.10.14
 5.11.14
 18.11.14
 28.12.14
 31.12.14
 29.9.15

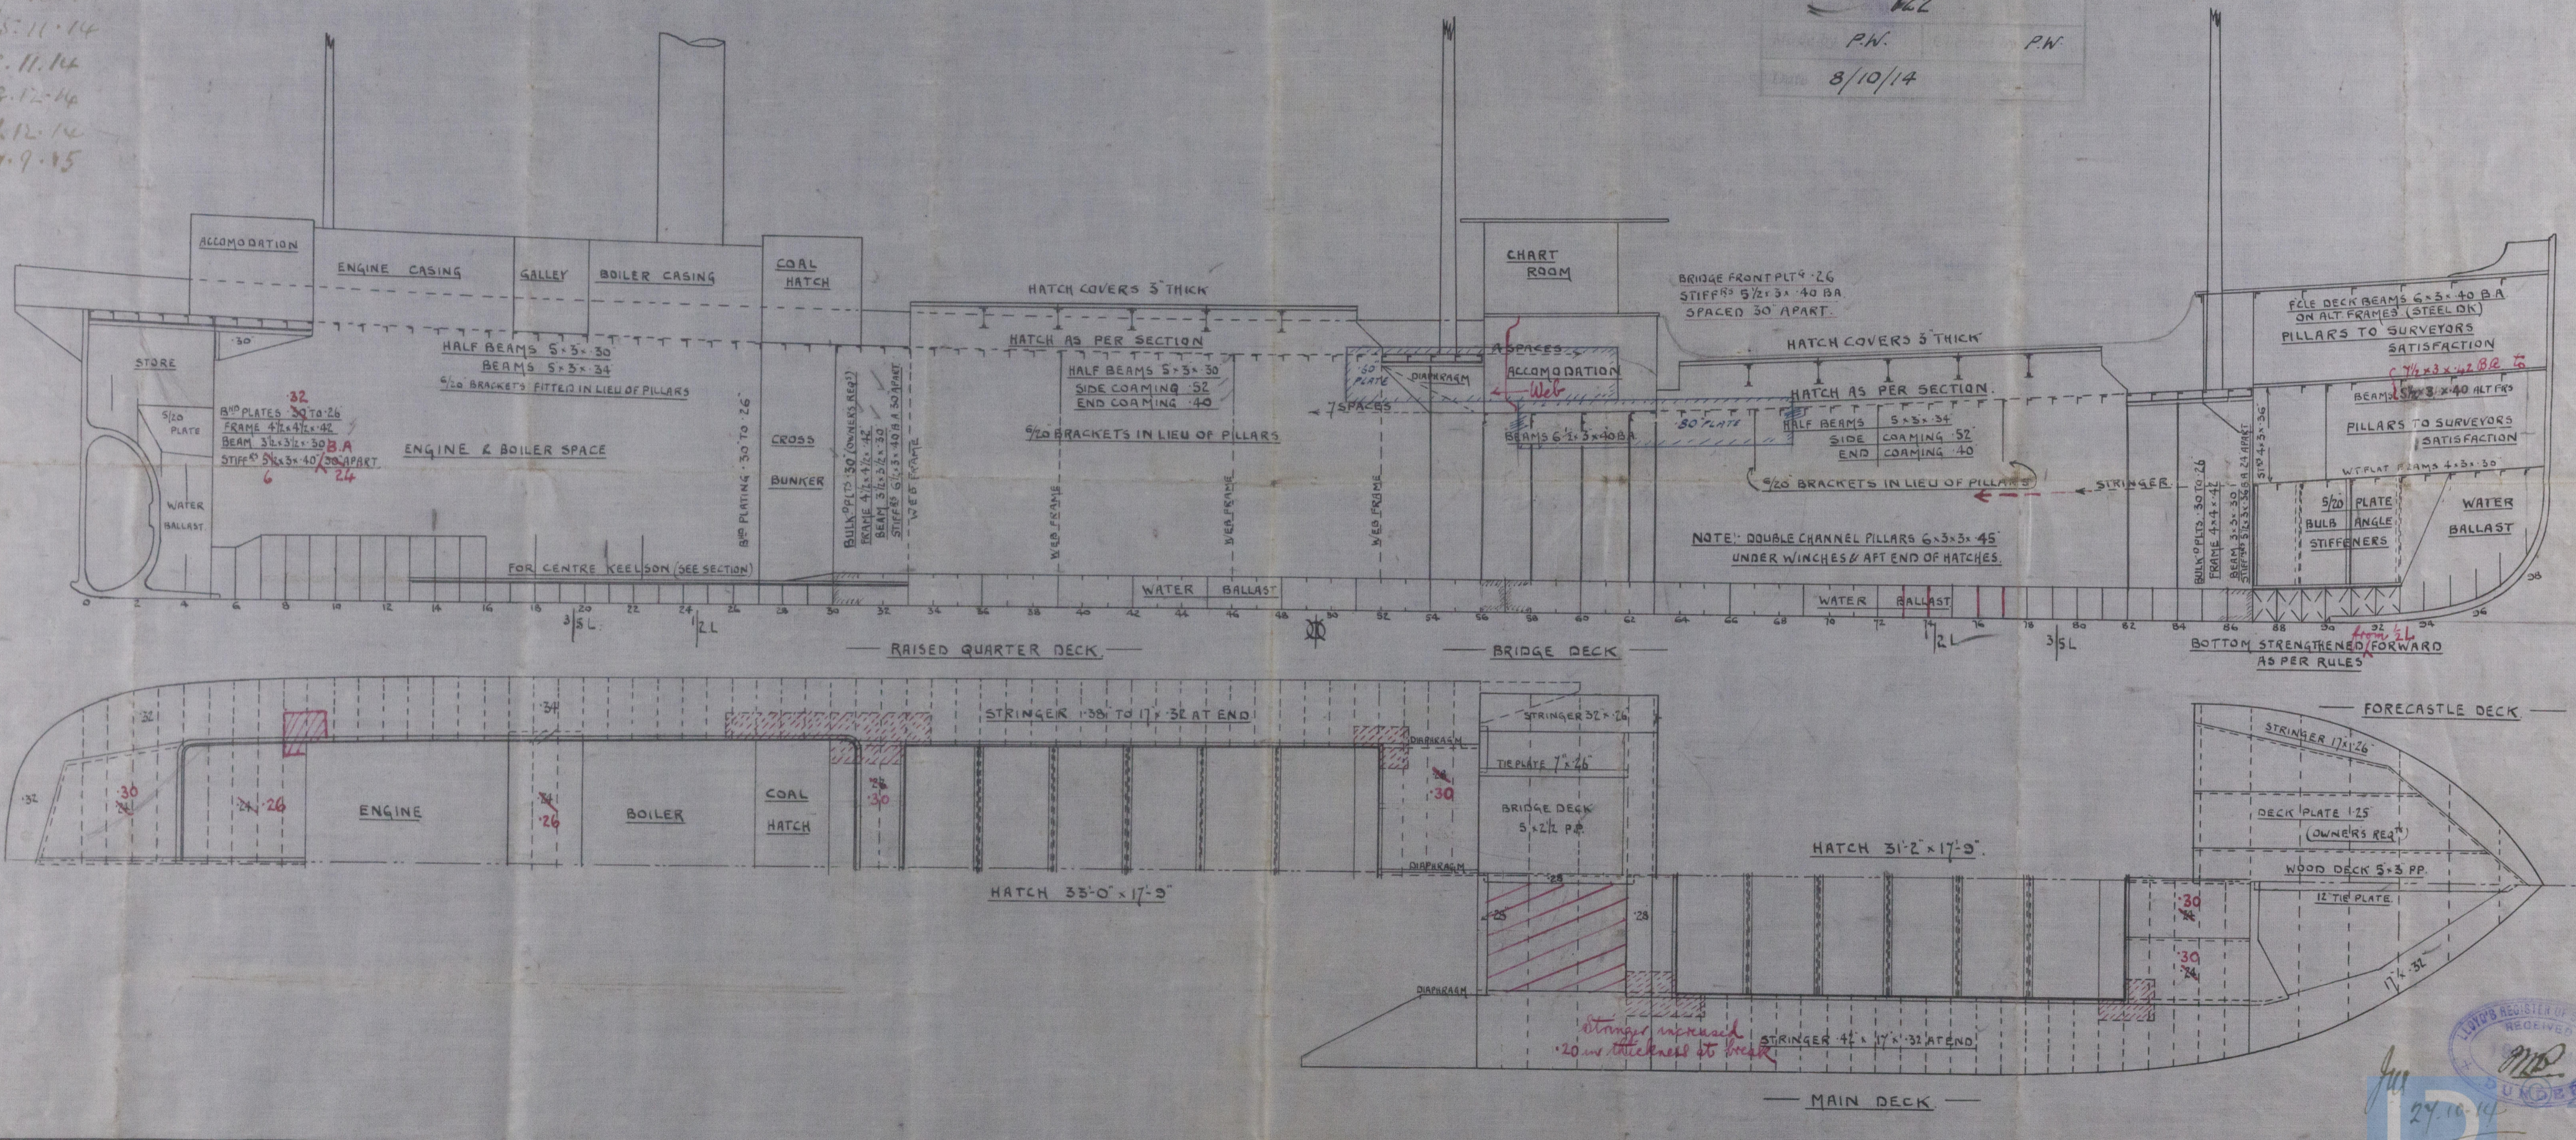

LLOYD'S REGISTER OF SHIPS
 RECEIVED
 27.10.14
 2020
 Lloyd's Register
 Foundation
 W770-0046

PROFILE & DECK PLAN.

DUNDEE S.B.C. & L^{TD}

No 273

S.S. "Stock Force"

DUN. RPT. No 4982

2/



© 2020

Lloyd's Register
Foundation