

PLAN No. 2394  
FOR ENCLOSURE TO  
Messrs Lloyd's Surveyors  
Hull FROM  
COCHRANE & SONS, LTD.  
SHIPBUILDERS, SELBY.  
DATE Jan 3<sup>rd</sup> 1918. RR

27.9.12

# MIDSHIP SECTION


NOS 552, 3, 4, & 5.

STEEL SCREW TRAWLERS

DIM<sup>s</sup> 133'-4" BP x 23'-0" E x E x 13'-0" M<sup>LO</sup>

SCALE 1/2" INCH = 1 FOOT.

TO CLASS 100 A1 LLOYDS. STEAM TRAWLER.

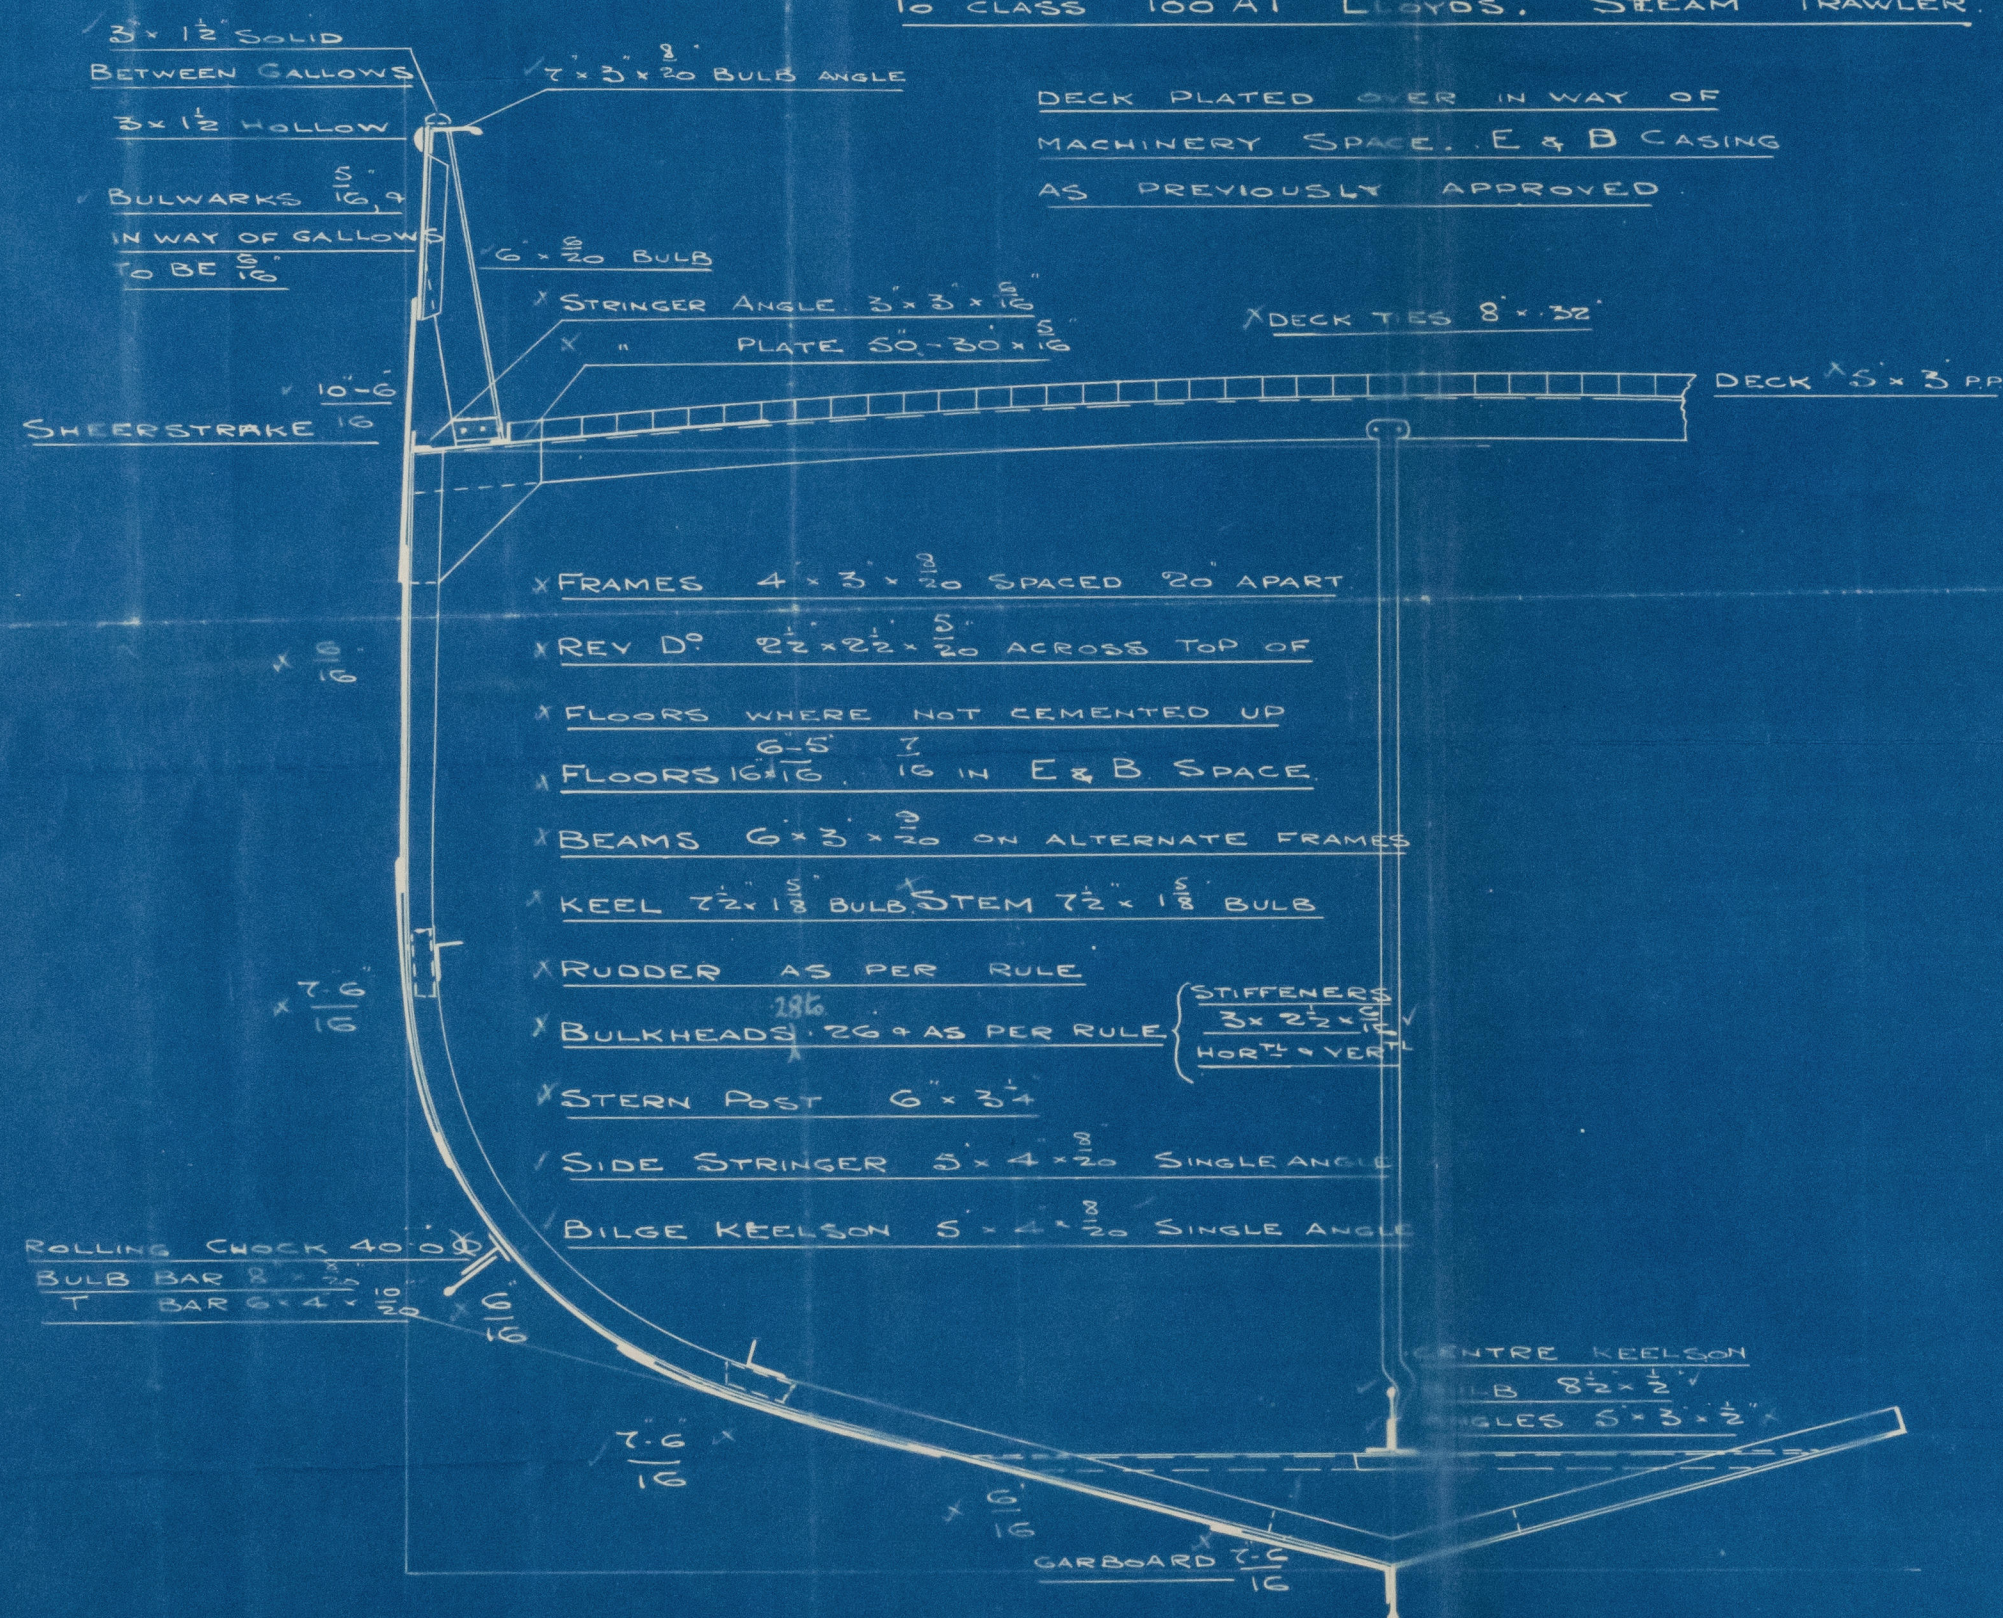

2011

Messrs Lloyd's Surveyors  
Hull FROM

25/9/12 RR

## NUMERALS

$$B + D = 35.87 \checkmark$$

$$L \times (B + D) = 4782.54 \checkmark$$

## PROPORTIONS

$$\frac{D}{L} = 10.25 \checkmark$$

$$\frac{L}{B} = 5.82$$

## EQUIPMENT

1 <sup>ST</sup>	BOWER ANCHOR	6 CWT <sup>s</sup> EX STOCK	✓
2 <sup>ND</sup>	"	5 1/2 " " "	✓
	KEDGE	3 " " "	✓
120	FATHOMS	2" CABLE	✓
60	"	6" HAWSER	✓
60	"	5" WARP.	✓

## RIVETING

- ✓ ALL LANDINGS TO BE DOUBLE
- ✓ RIVETED. BUTTS TO BE LAPPED
- ✓ & DOUBLE RIVETED EXCEPT
- ✓ GARBOARD & SHEER STRAKE WHICH
- ✓ ARE TO BE STRAPPED & DOUBLE
- ✓ RIVETED.

C.B. 27.9.12



© 2021

Lloyd's Register  
Foundation



W775-0007

Cochran & Sons Ltd.  
Nos 552, 553, 554 & 555,

Duplicate  
Midship Section.  
Diamond Hull Report No: 25908

Sapphire " " 25969  
Pearl " " "  
Emerald " " "



M. S.



© 2021

Lloyd's Register  
Foundation