
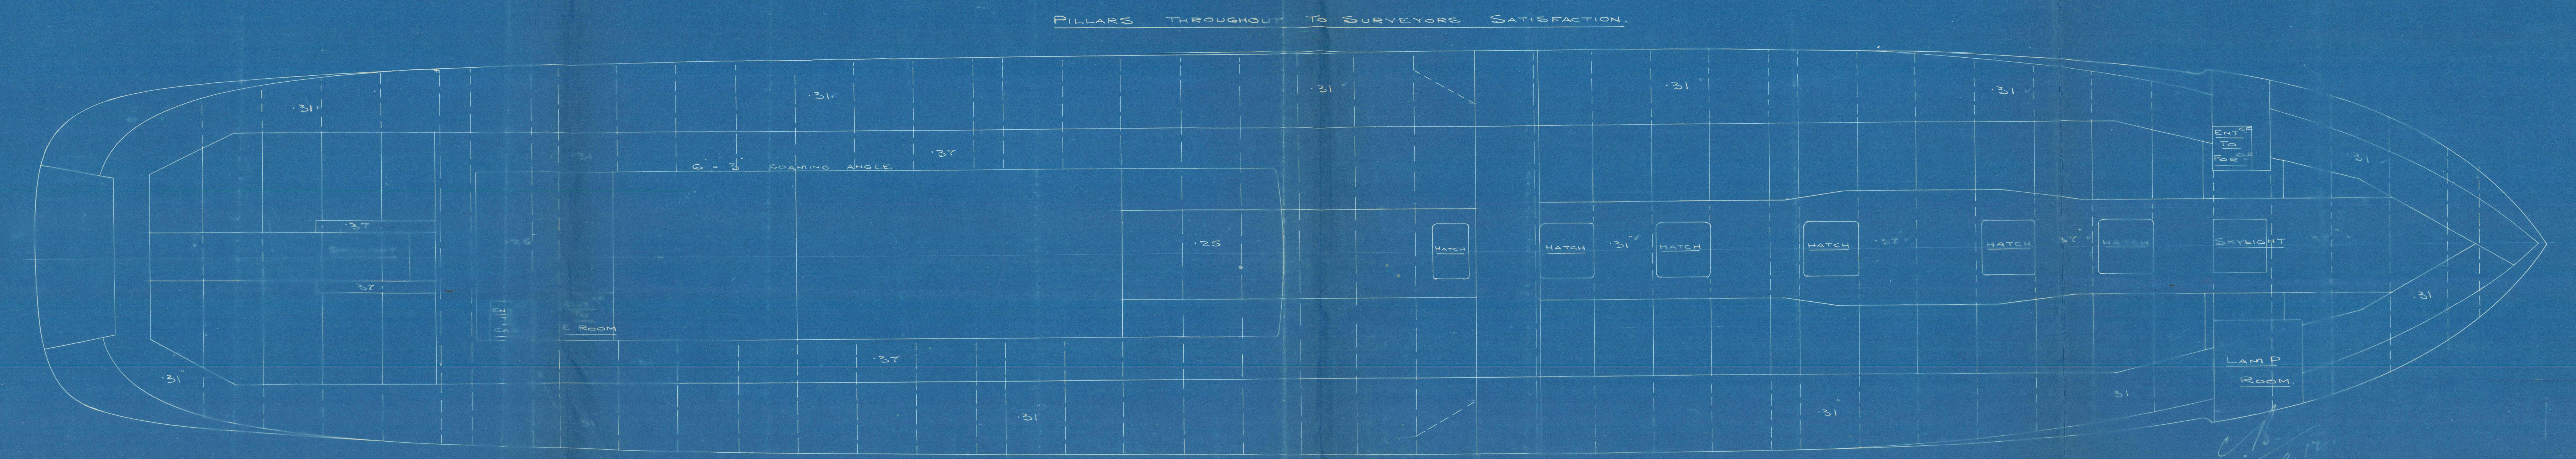


2012  
Mem. Lloyd's Surveyors  
Hull  
25/9/12 RR

PLAN No. 2395  
FOR ENCLOSURE TO  
Mr. Lloyd's Surveyors  
Hull FROM  
COCHRANE & SONS, LTD.  
SHIPBUILDERS, SELBY  
DATE Jan 3<sup>rd</sup> 1913. RR

PROFILE & DECK.  
Nos 552, 3, 4 & 5.  
SCALE 1/4" = 1 FOOT.

27.9.12

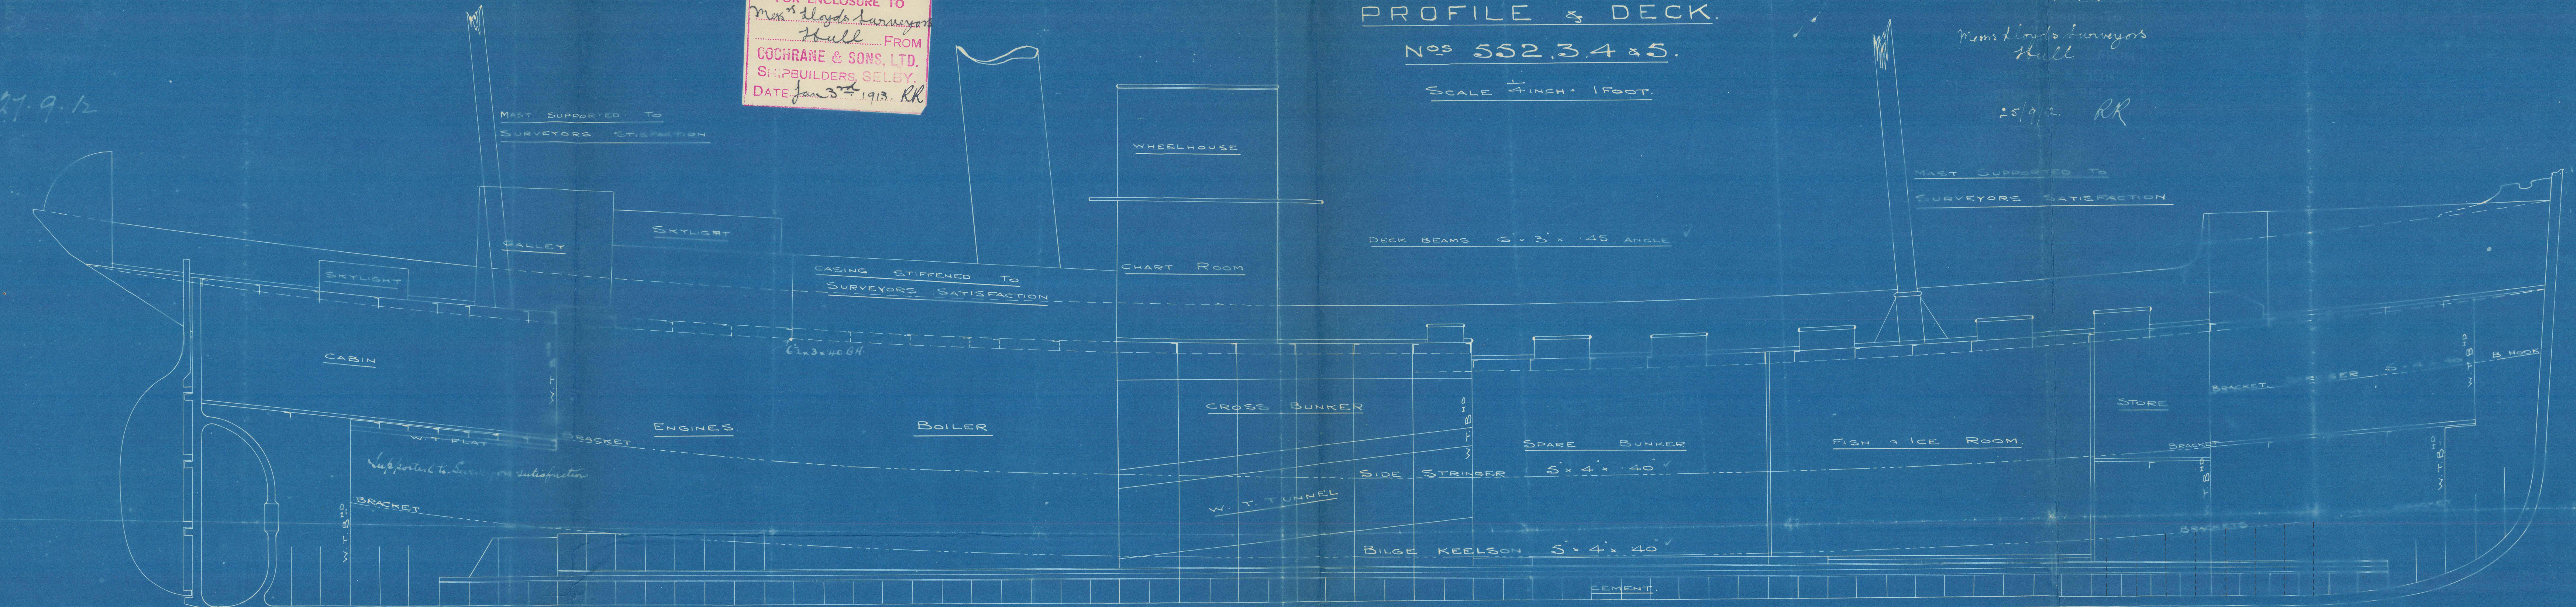




Cochran & Sons, Ltd.  
Nos 552, 553, 554 & 555.

W775-0008

Duplicate.  
Profile & Decks.  
1 Diamond Hull Report No. 25908  
" Sapphire " " 25969  
" Pearl " " "  
" Emerald " " "

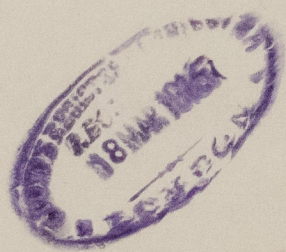

RETAIN

